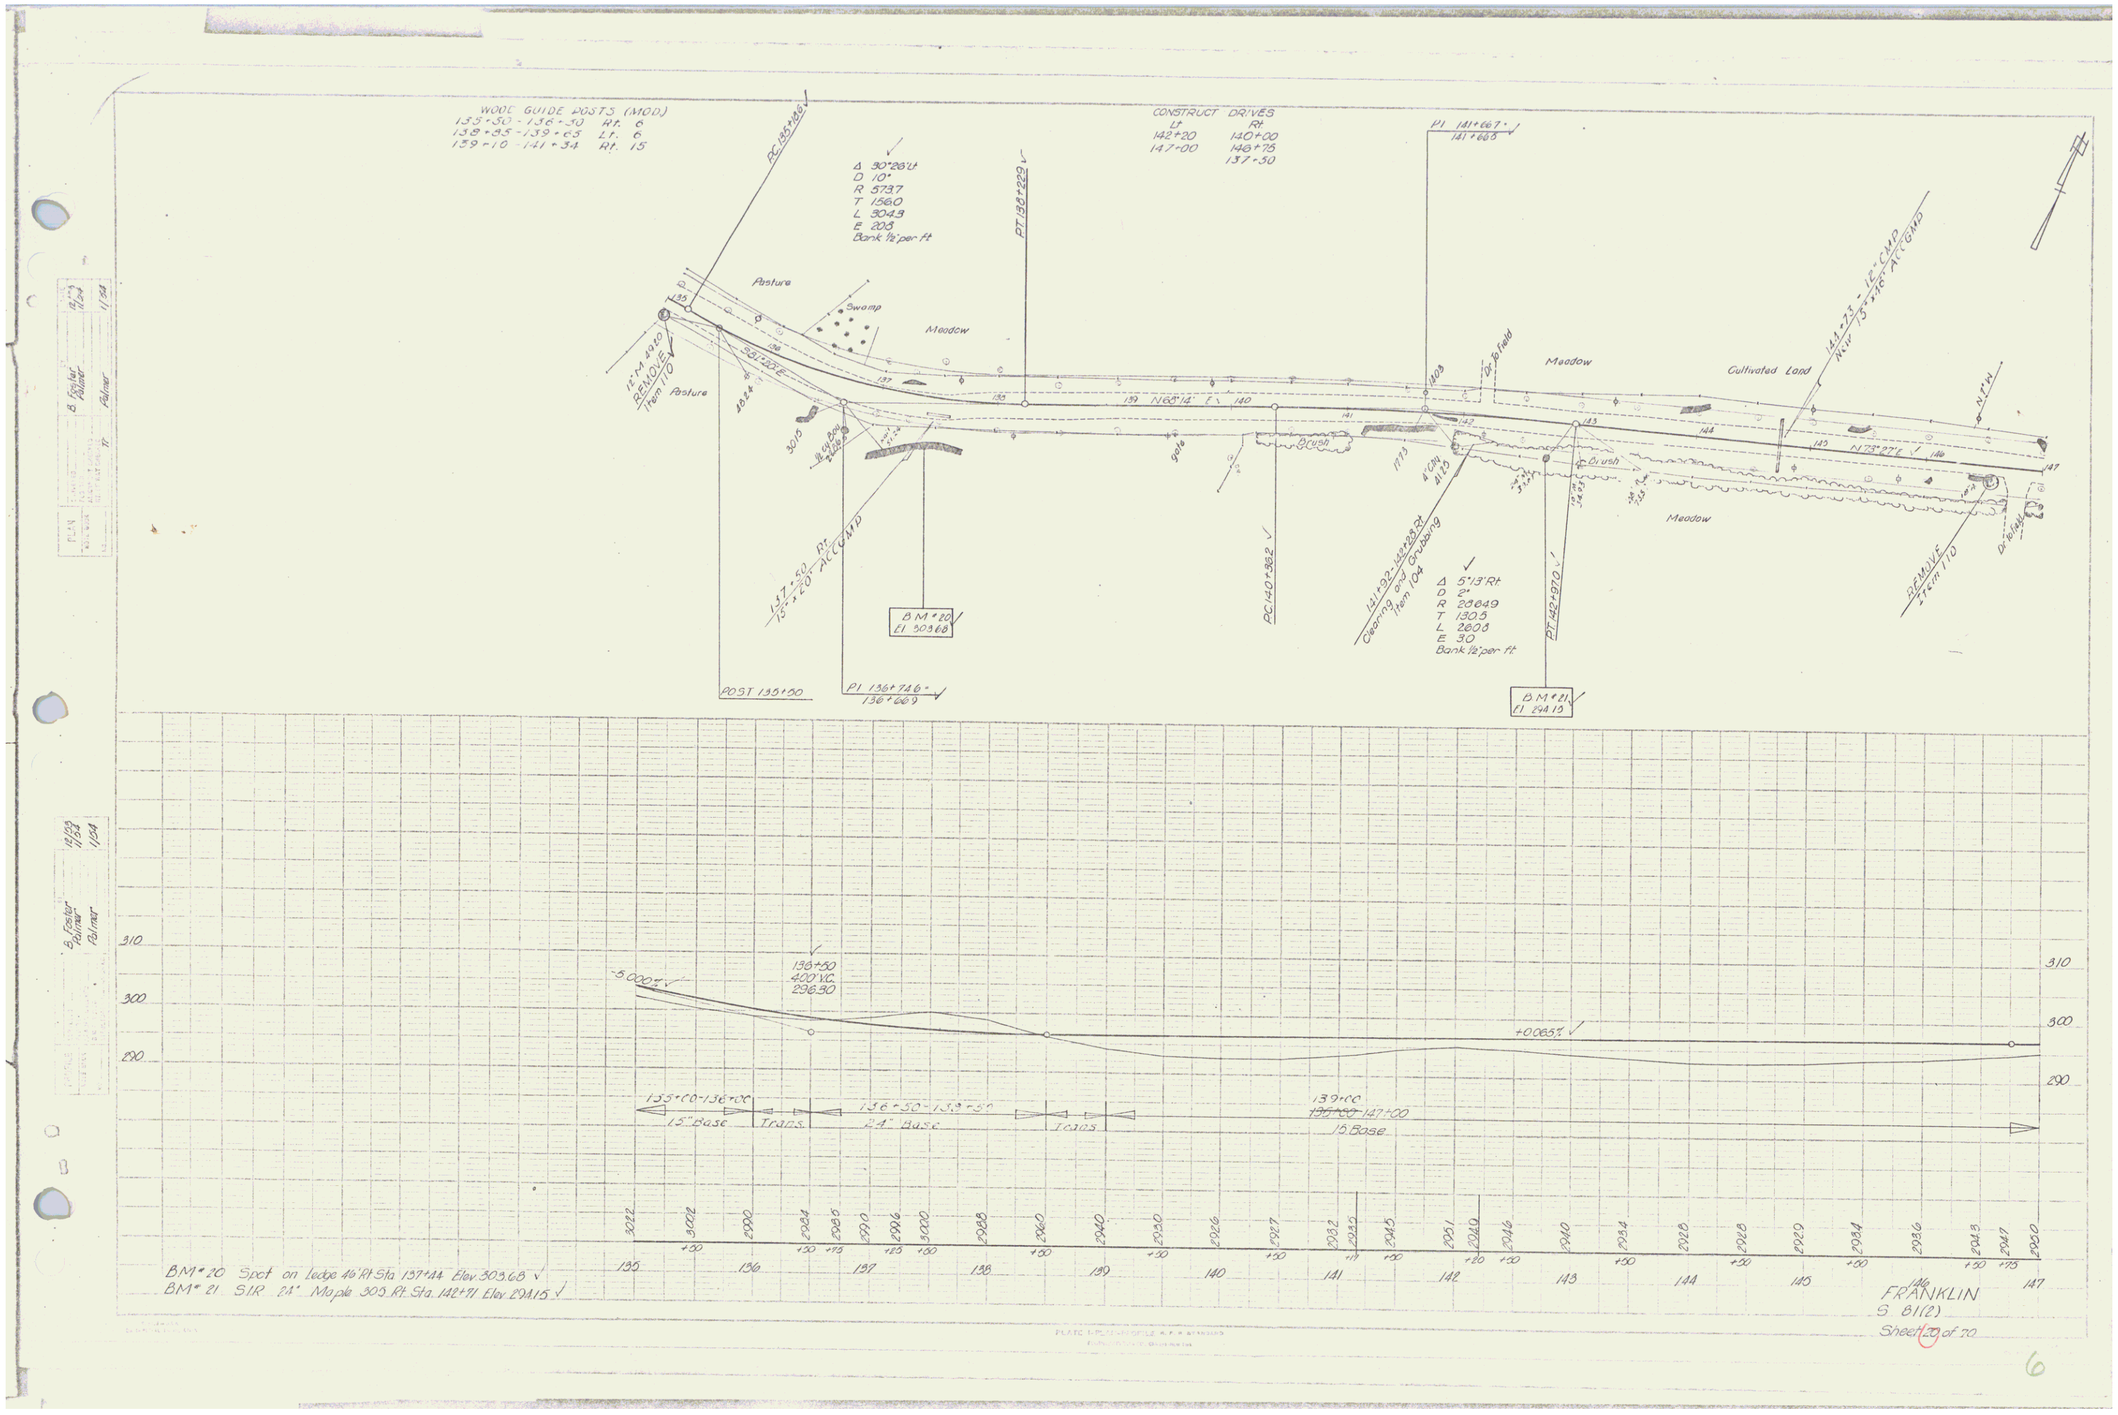
WOOD GUIDE POSTS (MOD.)
135+50 - 136+30 Rt. 6
138+85 - 139+65 Lt. 6
139+10 - 141+34 Rt. 15
PC 135+28
Δ 90°28' Lt
D 10°
R 573.7
T 1560
L 504.9
E 208
Bank ½' per ft
PT 138+229
CONSTRUCT DRIVES
Lt
142+20
147+00
Rt
140+00
146+75
137+30
PI 141+667
141+665
Pasture
Swamp
Meadow
Cultivated Land
Brush
gate
Dr. to field
N 68°14' E
N 73°27' E
5" M 4920
REMOVE
Item 110
137+50 Rt.
15" x 20' ACCEPTED
141+733 - 12" CMP
New 15" x 36' ACCEPTED
141+92 - 142+28 Rt.
Clearing and Grubbing
Item 104
REMOVE
Item 110
Dr. to field
B.M. #20
El 303.68
PC 140+862
Δ 5°13' Rt
D 2°
R 2864.9
T 130.5
L 260.8
E 30
Bank ½' per ft
PT 142+970
POST 135+50
PI 136+746
136+669
B.M. #21
El 294.15
310
300
290
-5.000%
136+50
400' V.C.
296.30
+0.065%
135+00-136+00
15" Base
Trans.
136+50-138+50
24" Base
Trans.
139+00
147+00
15 Base
BM #20 Spot on ledge 46' Rt Sta 137+44 Elev. 303.68
BM #21 S1R 24" Maple 30' S. Rt Sta. 142+71 Elev. 294.15
FRANKLIN
S 81(2)
Sheet 20 of 70
6