POOR ORIGINAL COPY

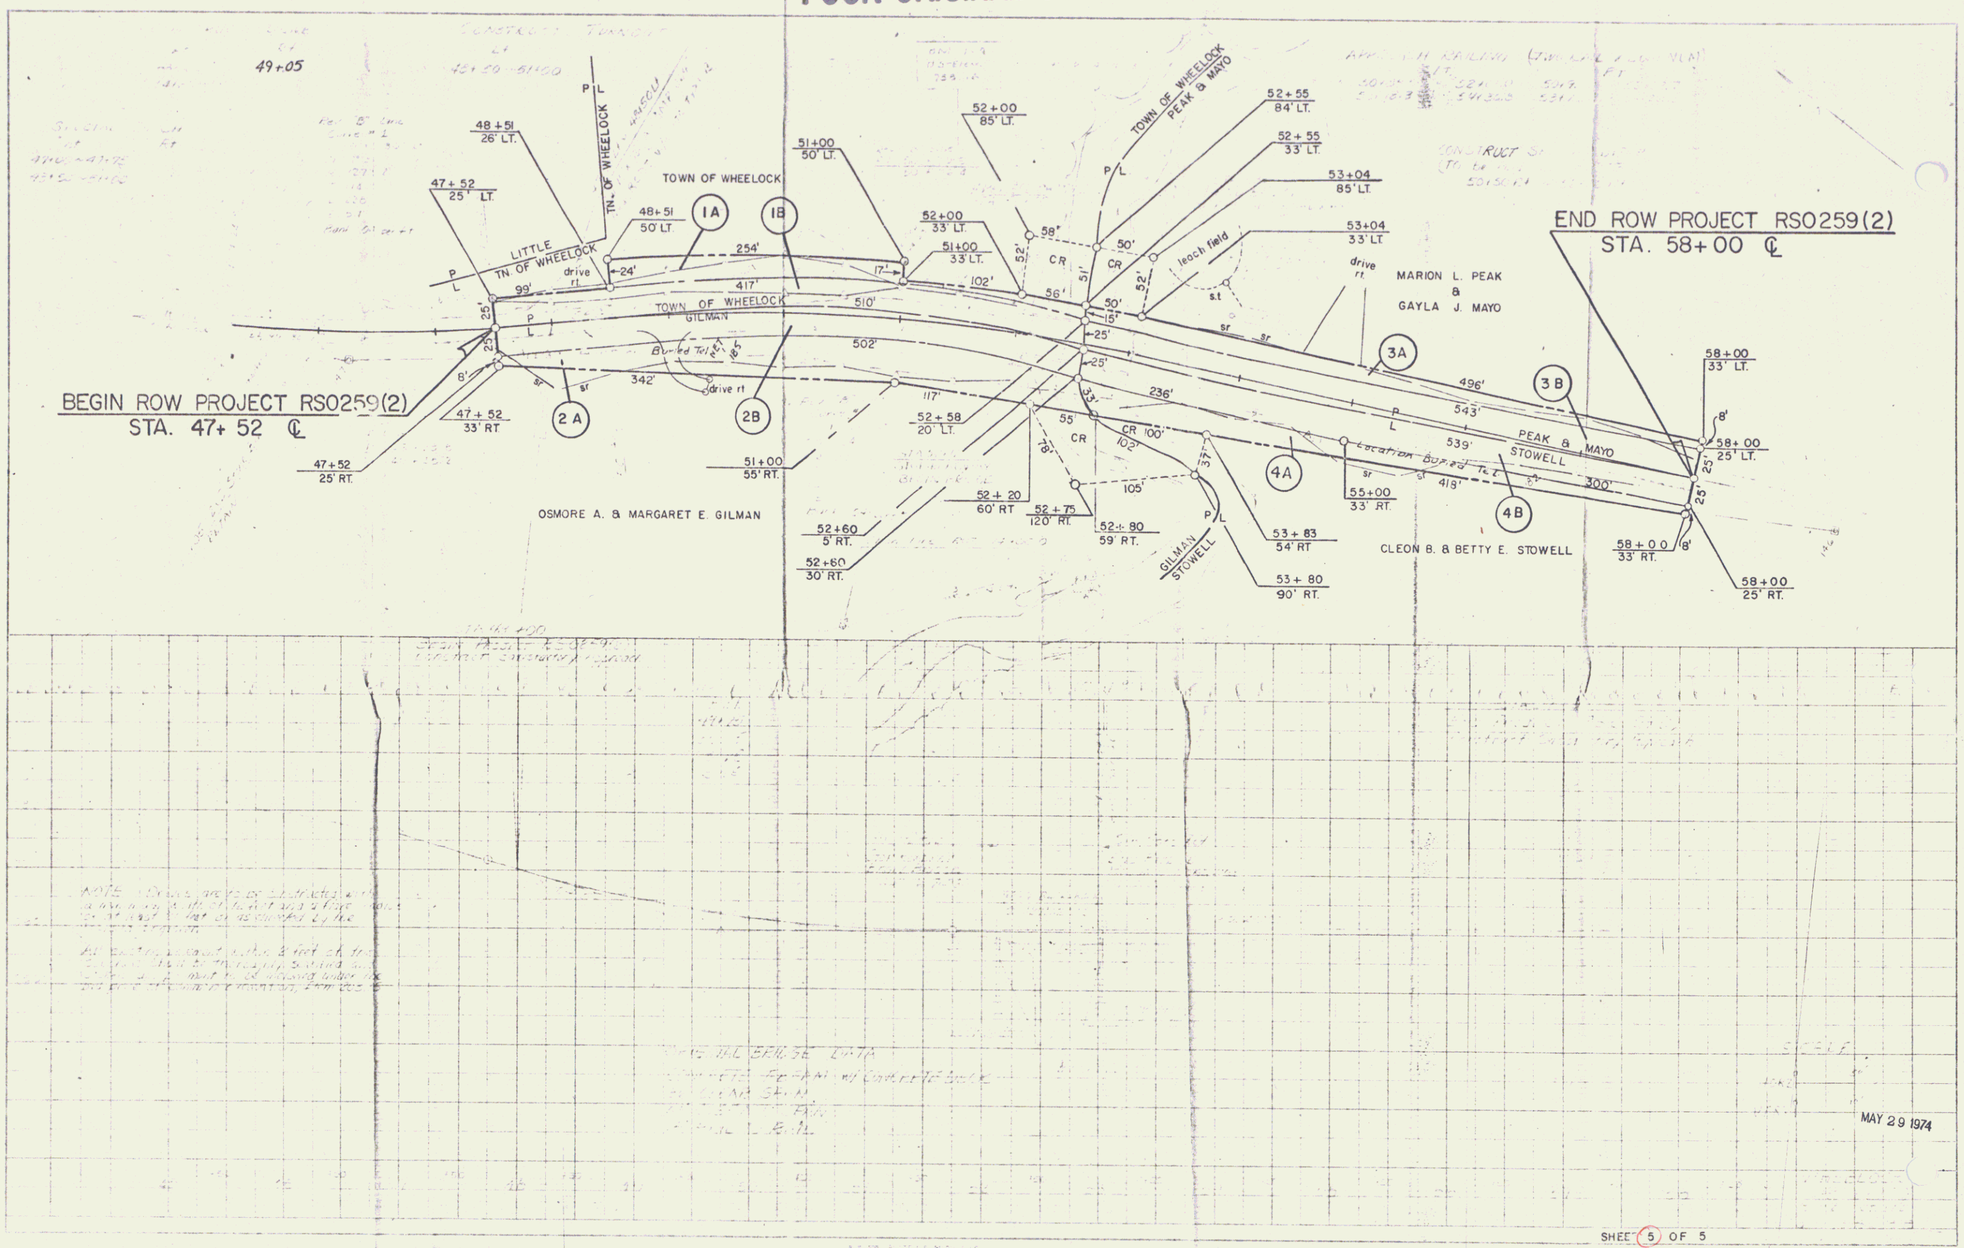

MAY 29 1974

SHEET 5 OF 5

4-