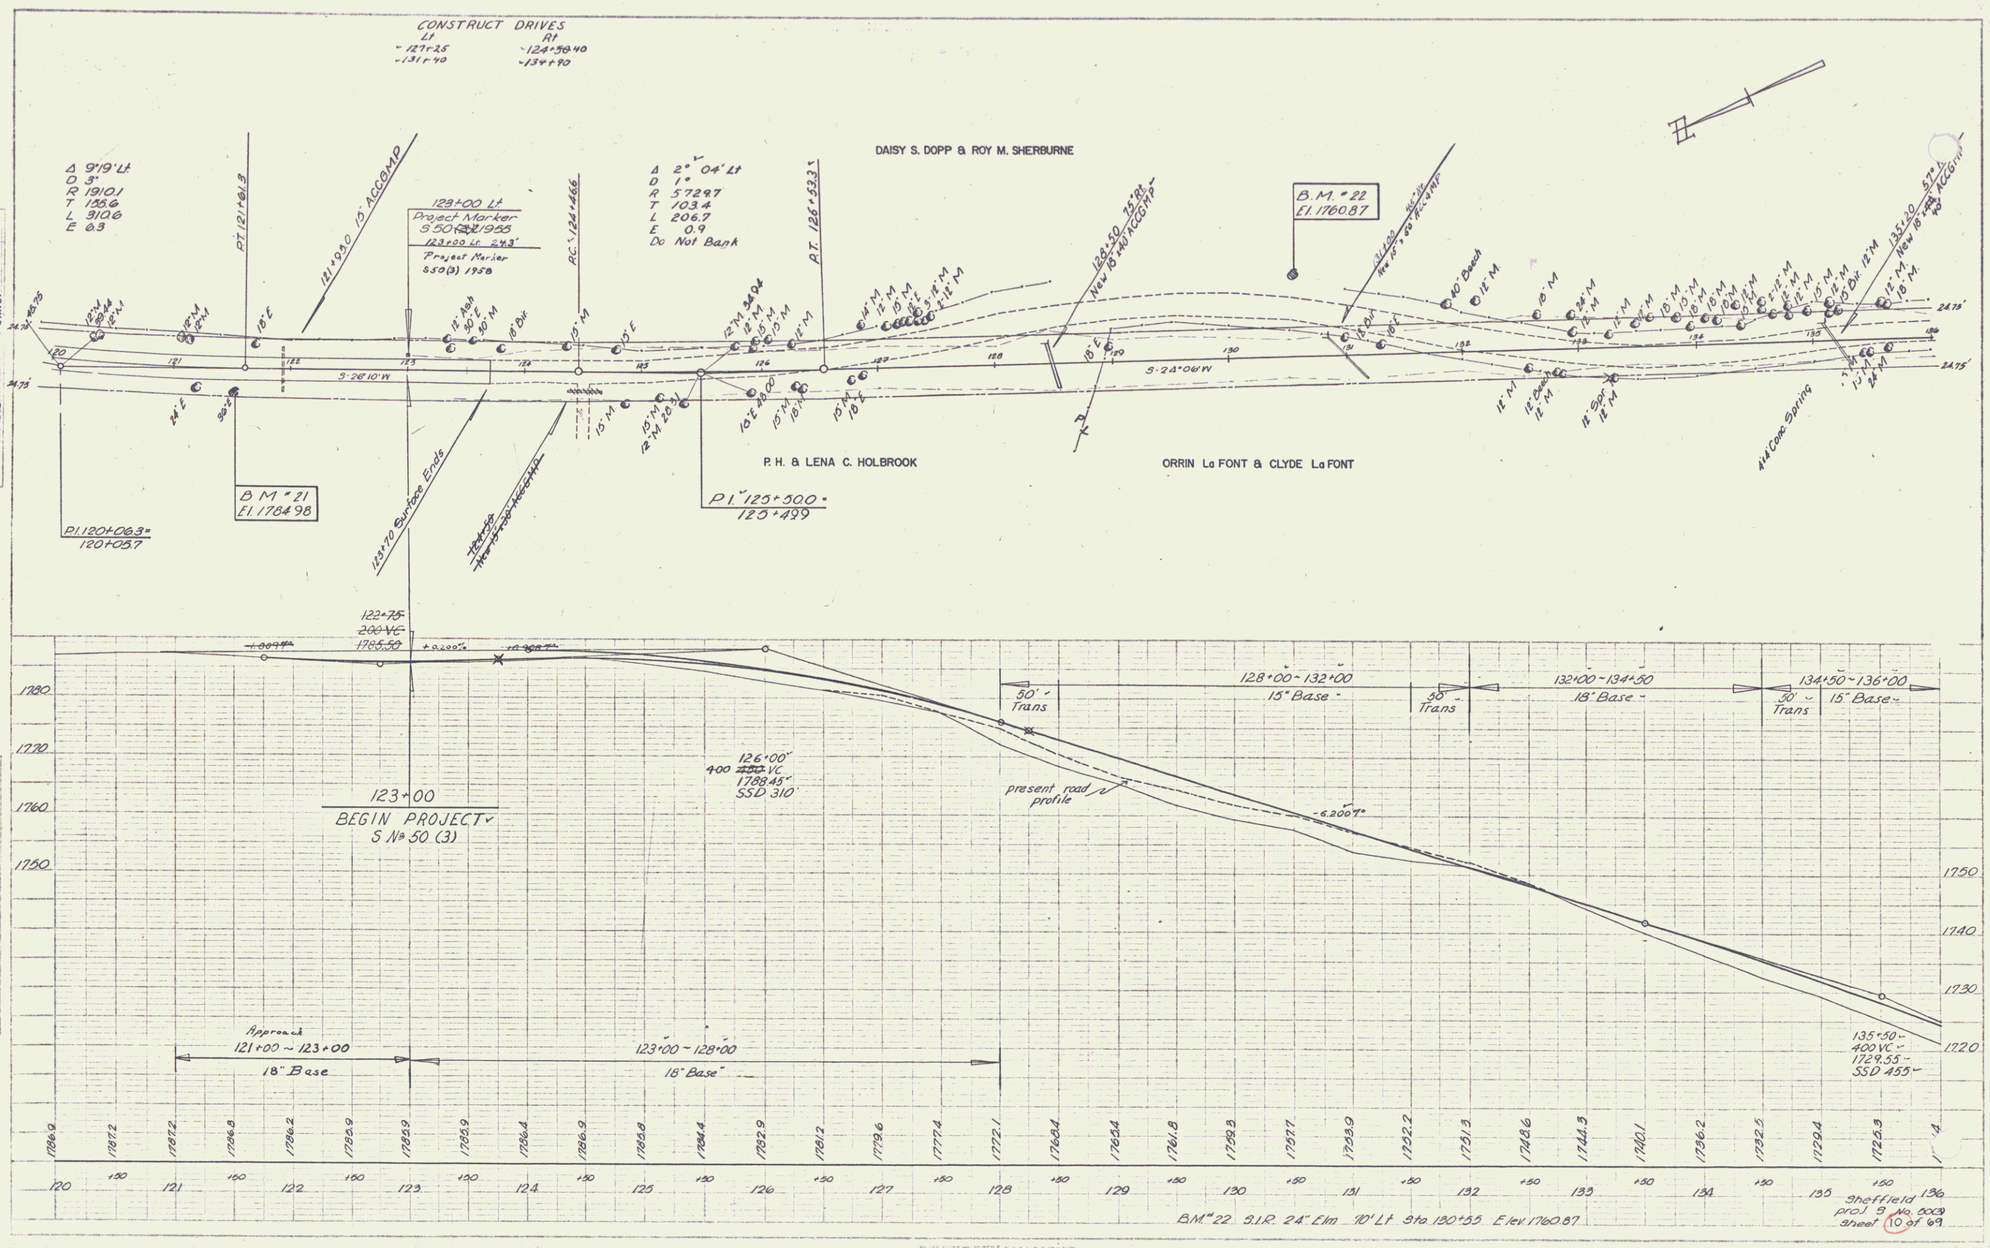
CONSTRUCT DRIVES
Lt
-121+25
-131+40
Rt
-124+50 40
-134+90
Δ 9°19' Lt
D 5°
R 1910.1
T 155.6
L 310.6
E 6.3
PT 121+61.3
121+90.0 15' ACCOMP
123+00 Lt
Project Marker
S 50(3) 1958
123+20 Lt 243'
Project Marker
S 50(3) 1958
RC 124+66
Δ 2° 04' Lt
D 1°
R 5729.7
T 103.4
L 206.7
E 0.9
Do Not Bank
PT 126+53.3
DAISY S. DOPP & ROY M. SHERBURNE
B.M. #22
El. 1760.87
New 18" x 40' RC ACCOMP
New 15" x 40' RC ACCOMP
10" Beech
12" M
15" M
12" Ash
30" E
30" M
18" Dbl
15" E
12" M 34.04
12" M
15" M
14" M
12" M
15" M
15" E
5" M
12" M
12" M
12