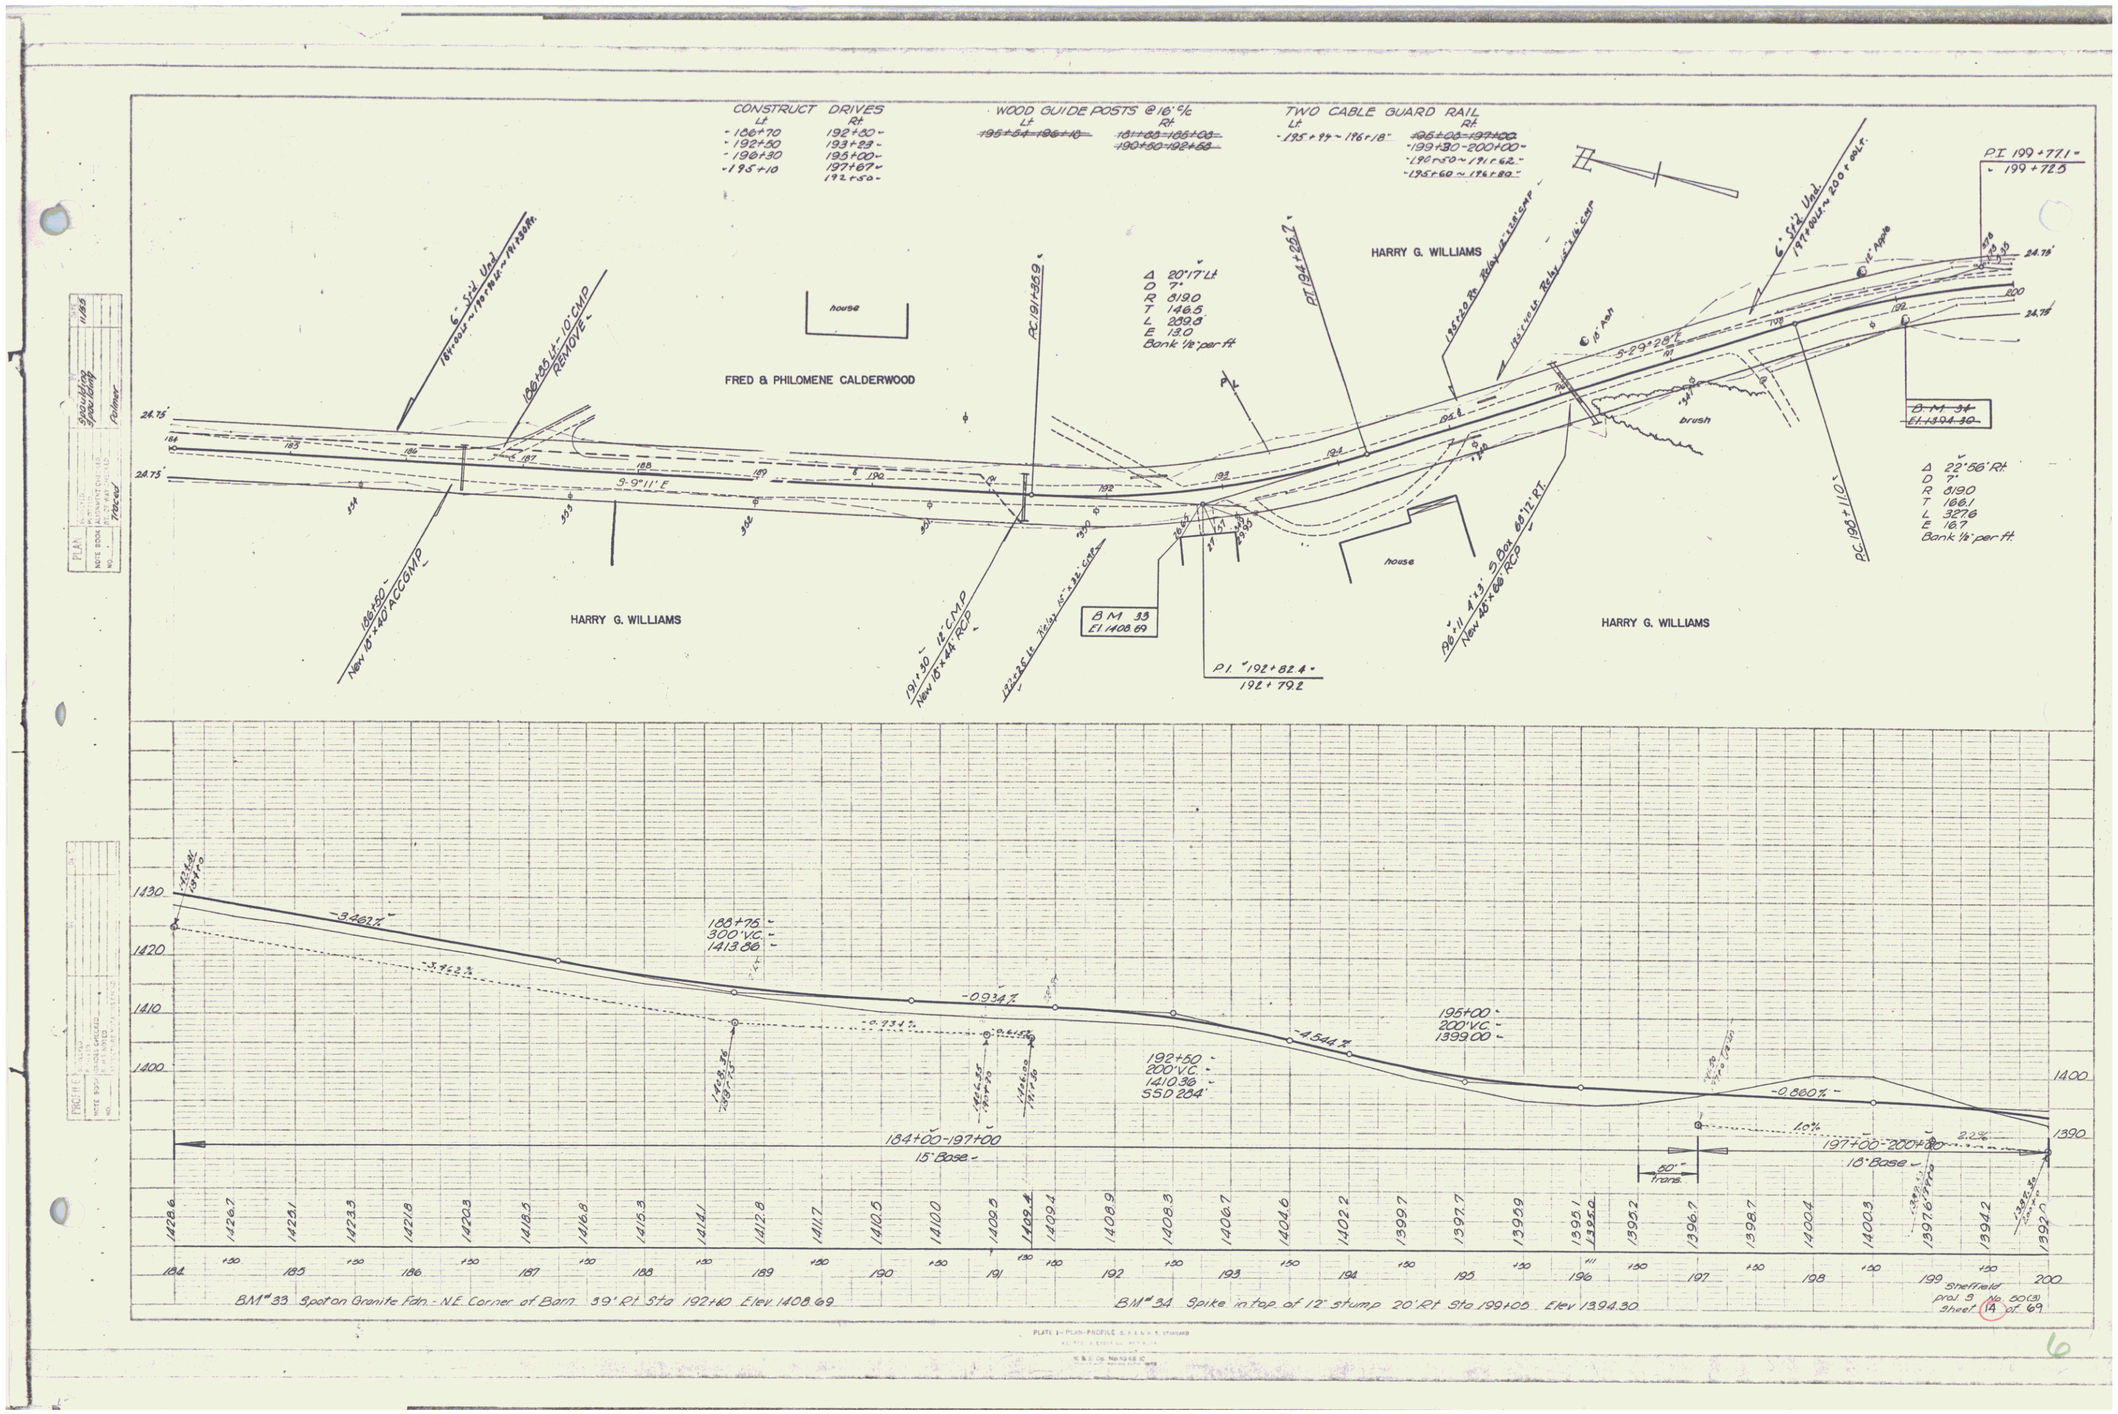
CONSTRUCT DRIVES
Lt
- 186+70
- 192+50
- 196+30
- 195+10
Rt
192+50 -
193+23 -
195+00 -
197+67 -
192+50 -
WOOD GUIDE POSTS @16' c/c
Lt
~~195+84 - 196+18~~
Rt
~~18+03 - 186+03~~
~~190+50 - 192+63~~
TWO CABLE GUARD RAIL
Lt
- 195+94 - 196+18 -
Rt
~~196+05 - 197+00~~
- 199+30 - 200+00 -
- 196+50 - 197+62 -
- 195+60 - 196+80 -
6" Std. Unsd.
188+50 Lt - 10" CMP REMOVE
FRED & PHILOMENE CALDERWOOD
house
HARRY G. WILLIAMS
Δ 80°17' Lt
D 7°
R 819.0
T 146.5
L 289.3
E 13.0
Bank 1/2' per ft
PC 191+35.9
PT 194+25.7
S-9°11' E
S-29°28' E
brush
18" Ash
24" Apple
PI 199+77.1
199+72.0
BM 34
El 1394.30
Δ 22°56' Rt.
D 7°
R 819.0
T 166.1
L 327.6
E 16.7
Bank 1/2' per ft.
PC 195+11.0
188+50 - New 18"x40' ACCGMP
191+30 - 18" CMP New 18"x44' RCP
BM 33
El 1408.69
P.I. 192+82.4
192+79.2
196+11 4'x3' Box 68.12' Rt New 48"x68' RCP
HARRY G. WILLIAMS
-3.267%
-3.433%
-0.934%
-0.731%
-4.544%
-0.860%
188+75
300' VC
1413.88
192+50
200' VC
1410.36
SSD 284'
195+00
200' VC
1399.00
184+00-197+00
15' Base
197+00-200+80
10' Base
10%
2.2%
50' trans.
1430
1420
1410
1400
1390
BM 33 Spot on Granite Fdn. - N.E. Corner of Barn 39' Rt Sta 192+60 Elev. 1408.69
BM 34 Spike in top of 12" stump 20' Rt Sta 199+00 Elev 1394.30
Sheffield
Proj. 9 No. 50(3)
Sheet 14 of 69

6