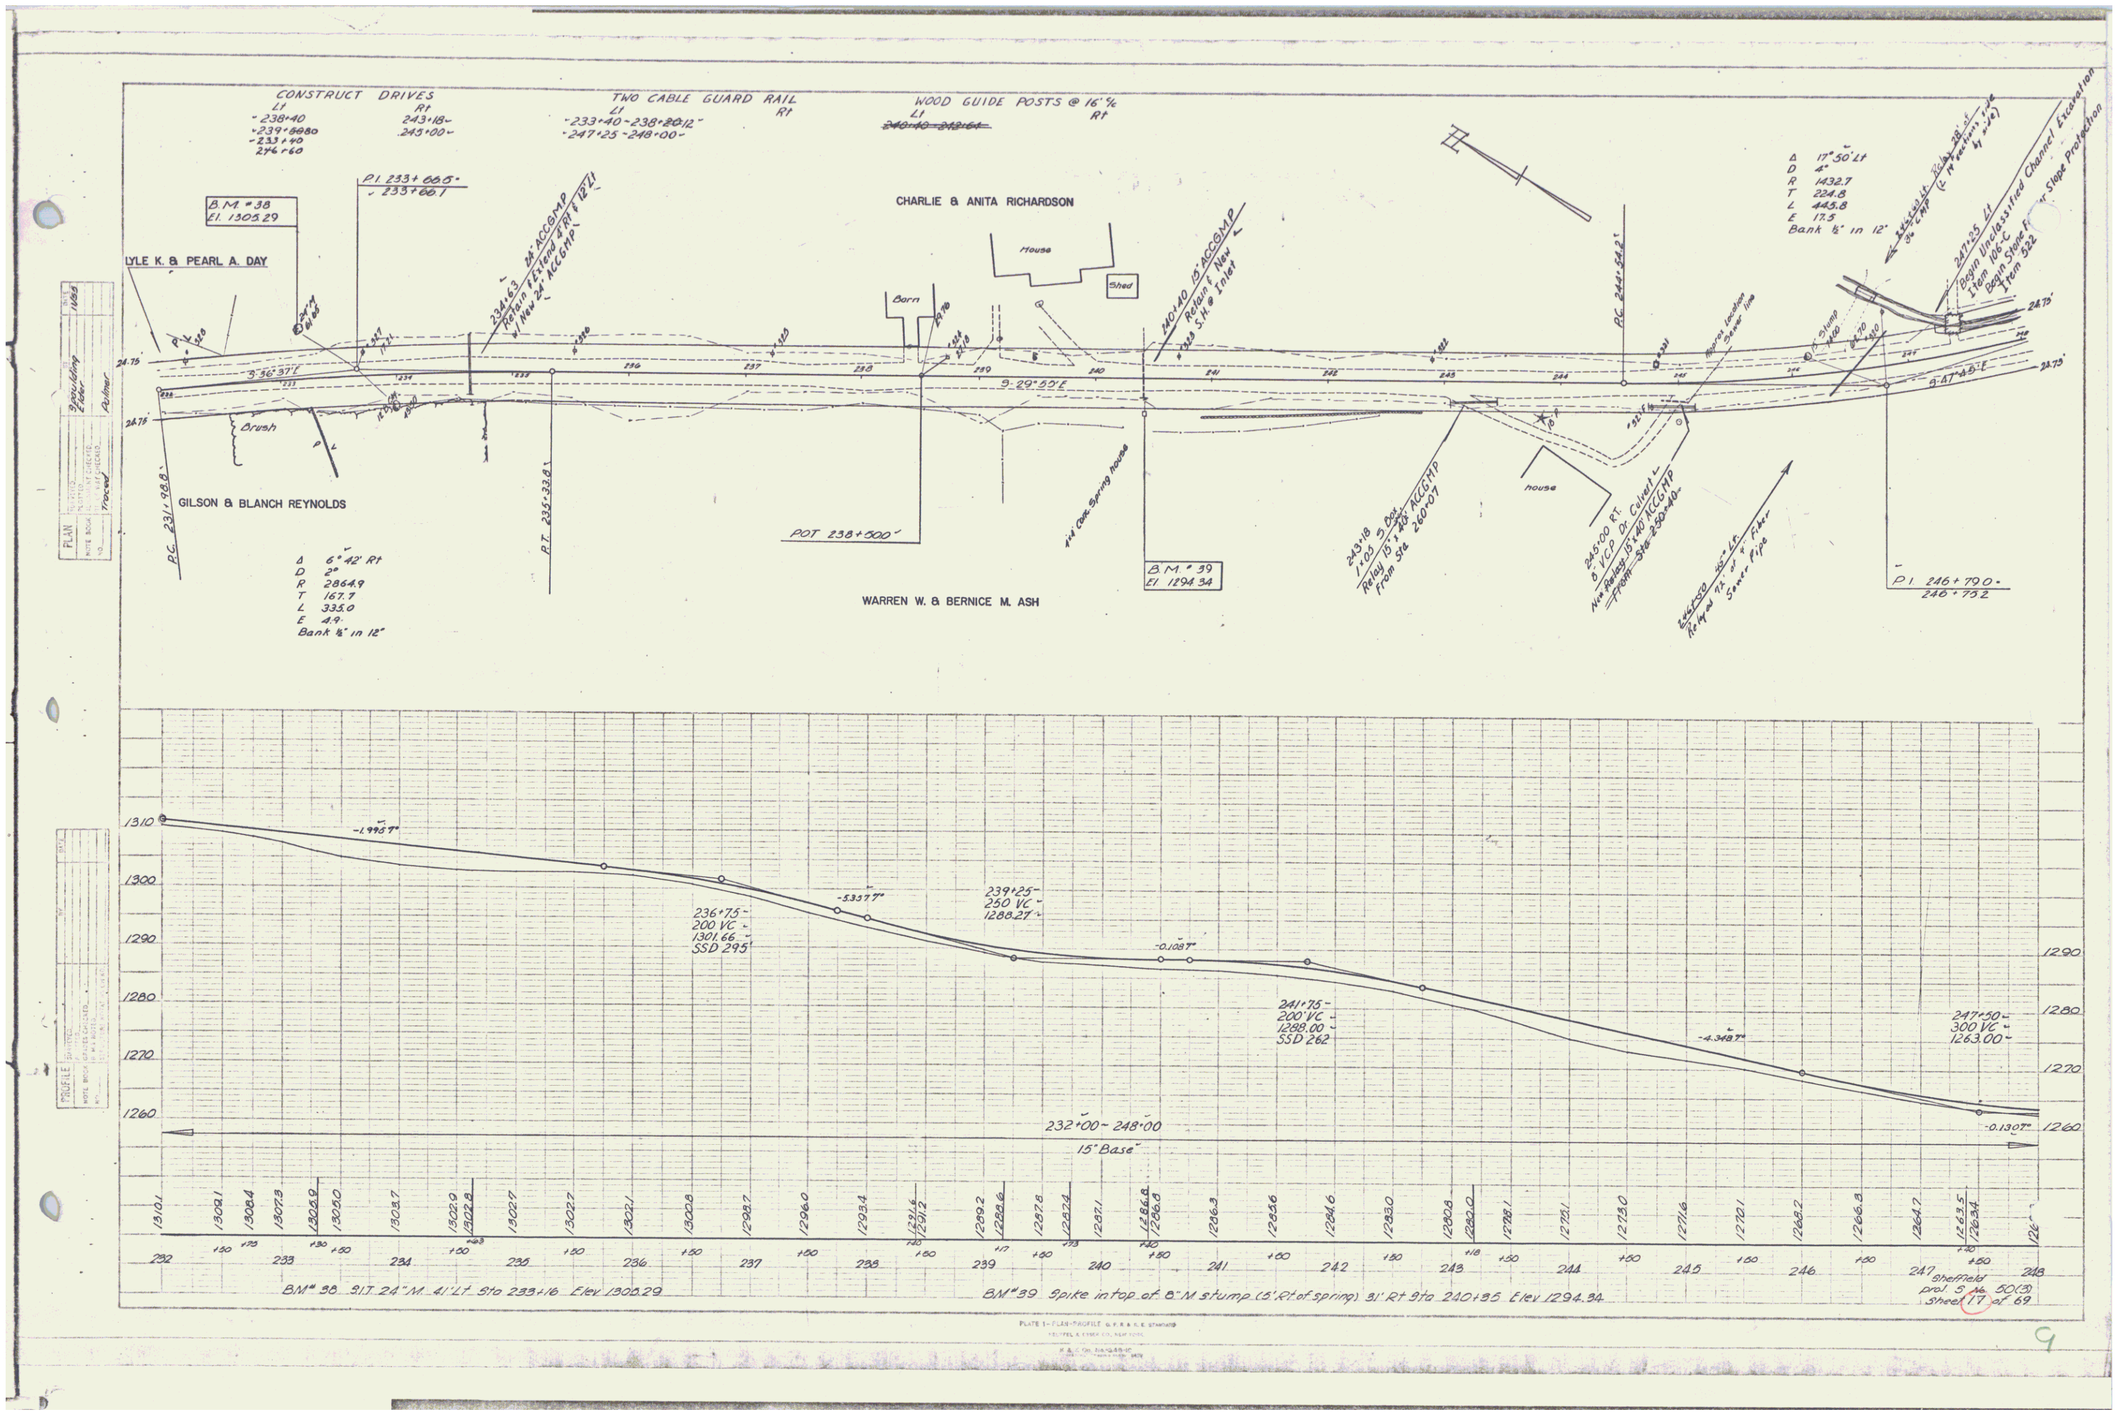
CONSTRUCT DRIVES
Lt
238+40
239+60
233+40
246+60
Rt
243+18
243+00
TWO CABLE GUARD RAIL
Lt
233+40 - 238+20.12
247+25 - 248+00
Rt
WOOD GUIDE POSTS @ 16' %
Lt
Rt
B.M. = 38
El. 1300.29
P.I. 233+66.5
233+66.1
LYLE K. & PEARL A. DAY
CHARLIE & ANITA RICHARDSON
House
Barn
Shed
GILSON & BLANCH REYNOLDS
WARREN W. & BERNICE M. ASH
house
Brush
POT 238+500
B.M. = 39
El. 1294.34
P.I. 246+79.0
246+79.2
Δ 6° 42' Rt
D 2°
R 2864.9
T 167.7
L 335.0
E 4.9
Bank ½" in 12"
Δ 17° 50' Lt
D 4°
R 1432.7
T 224.8
L 445.8
E 17.5
Bank ½" in 12"
232+00 ~ 248+00
15' Base
236+75
200 VC
1301.66
SSD 295
239+25
250 VC
1288.27
241+75
200 VC
1288.00
SSD 262
247+50
300 VC
1263.00
BM# 38 9' LT 24" M. 41' Lt. Sta 233+16 Elev 1300.29
BM# 39 Spike in top of 8" M stump (5' Rt of spring) 31' Rt Sta 240+85 Elev 1294.34
Sheffield
proj. S 46 50(3)
sheet 17 of 69