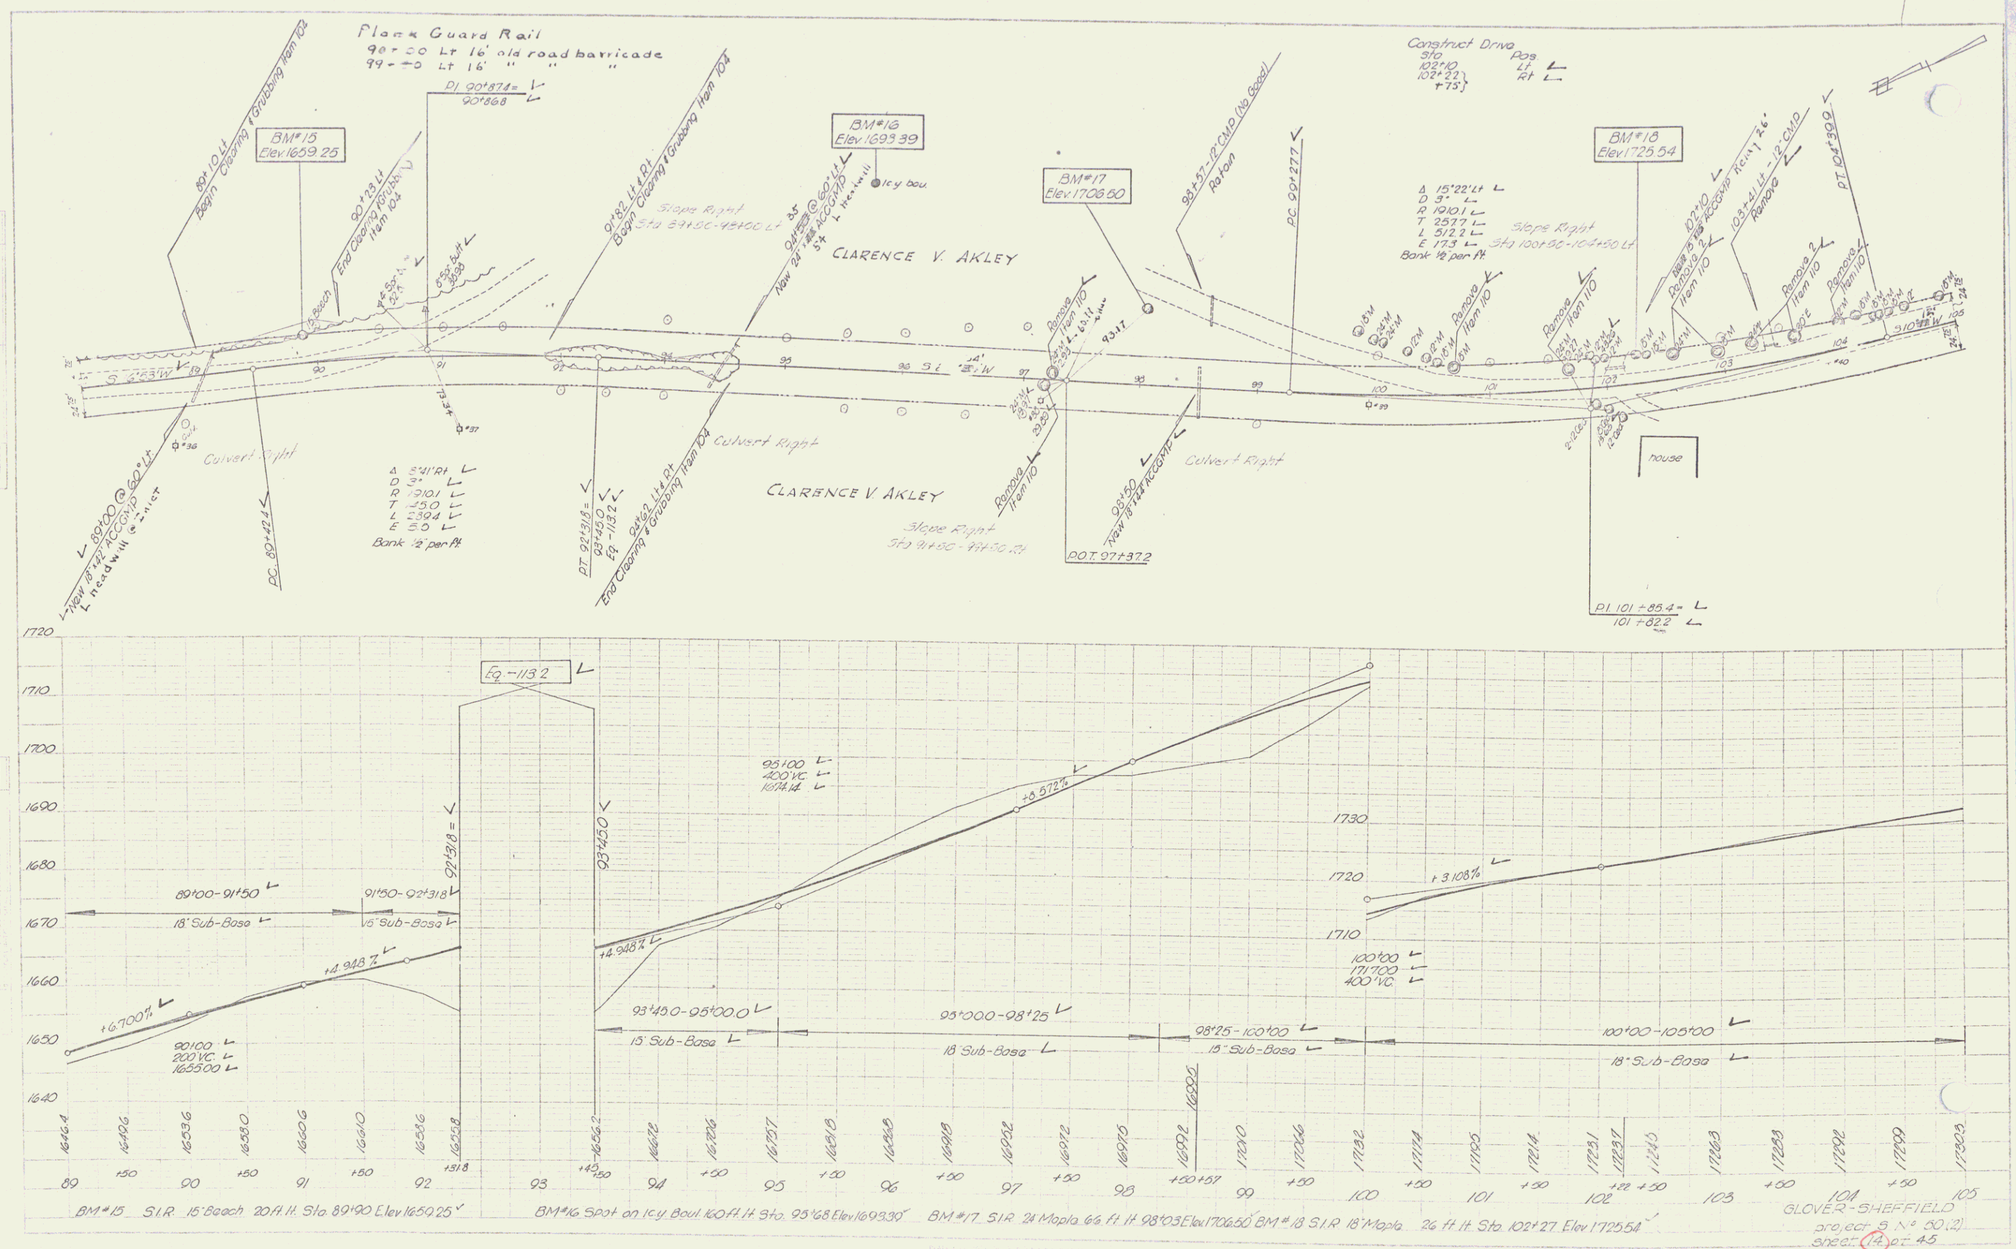

BM#15 S.I.R. 15' Beech 20 ft. lt. Sta. 89+90 Elev 1659.25

BM#16 Spot on Icy Boul. 160 ft. lt. Sta. 95+68 Elev 1693.39

BM#17 S.I.R. 24" Maple 66 ft. lt. 98+03 Elev 1706.50

BM#18 S.I.R. 18" Maple 26 ft. lt. Sta. 102+27 Elev 1725.54

GLOVER-SHEFFIELD
project S No 50(2)
sheet 14 of 45

8