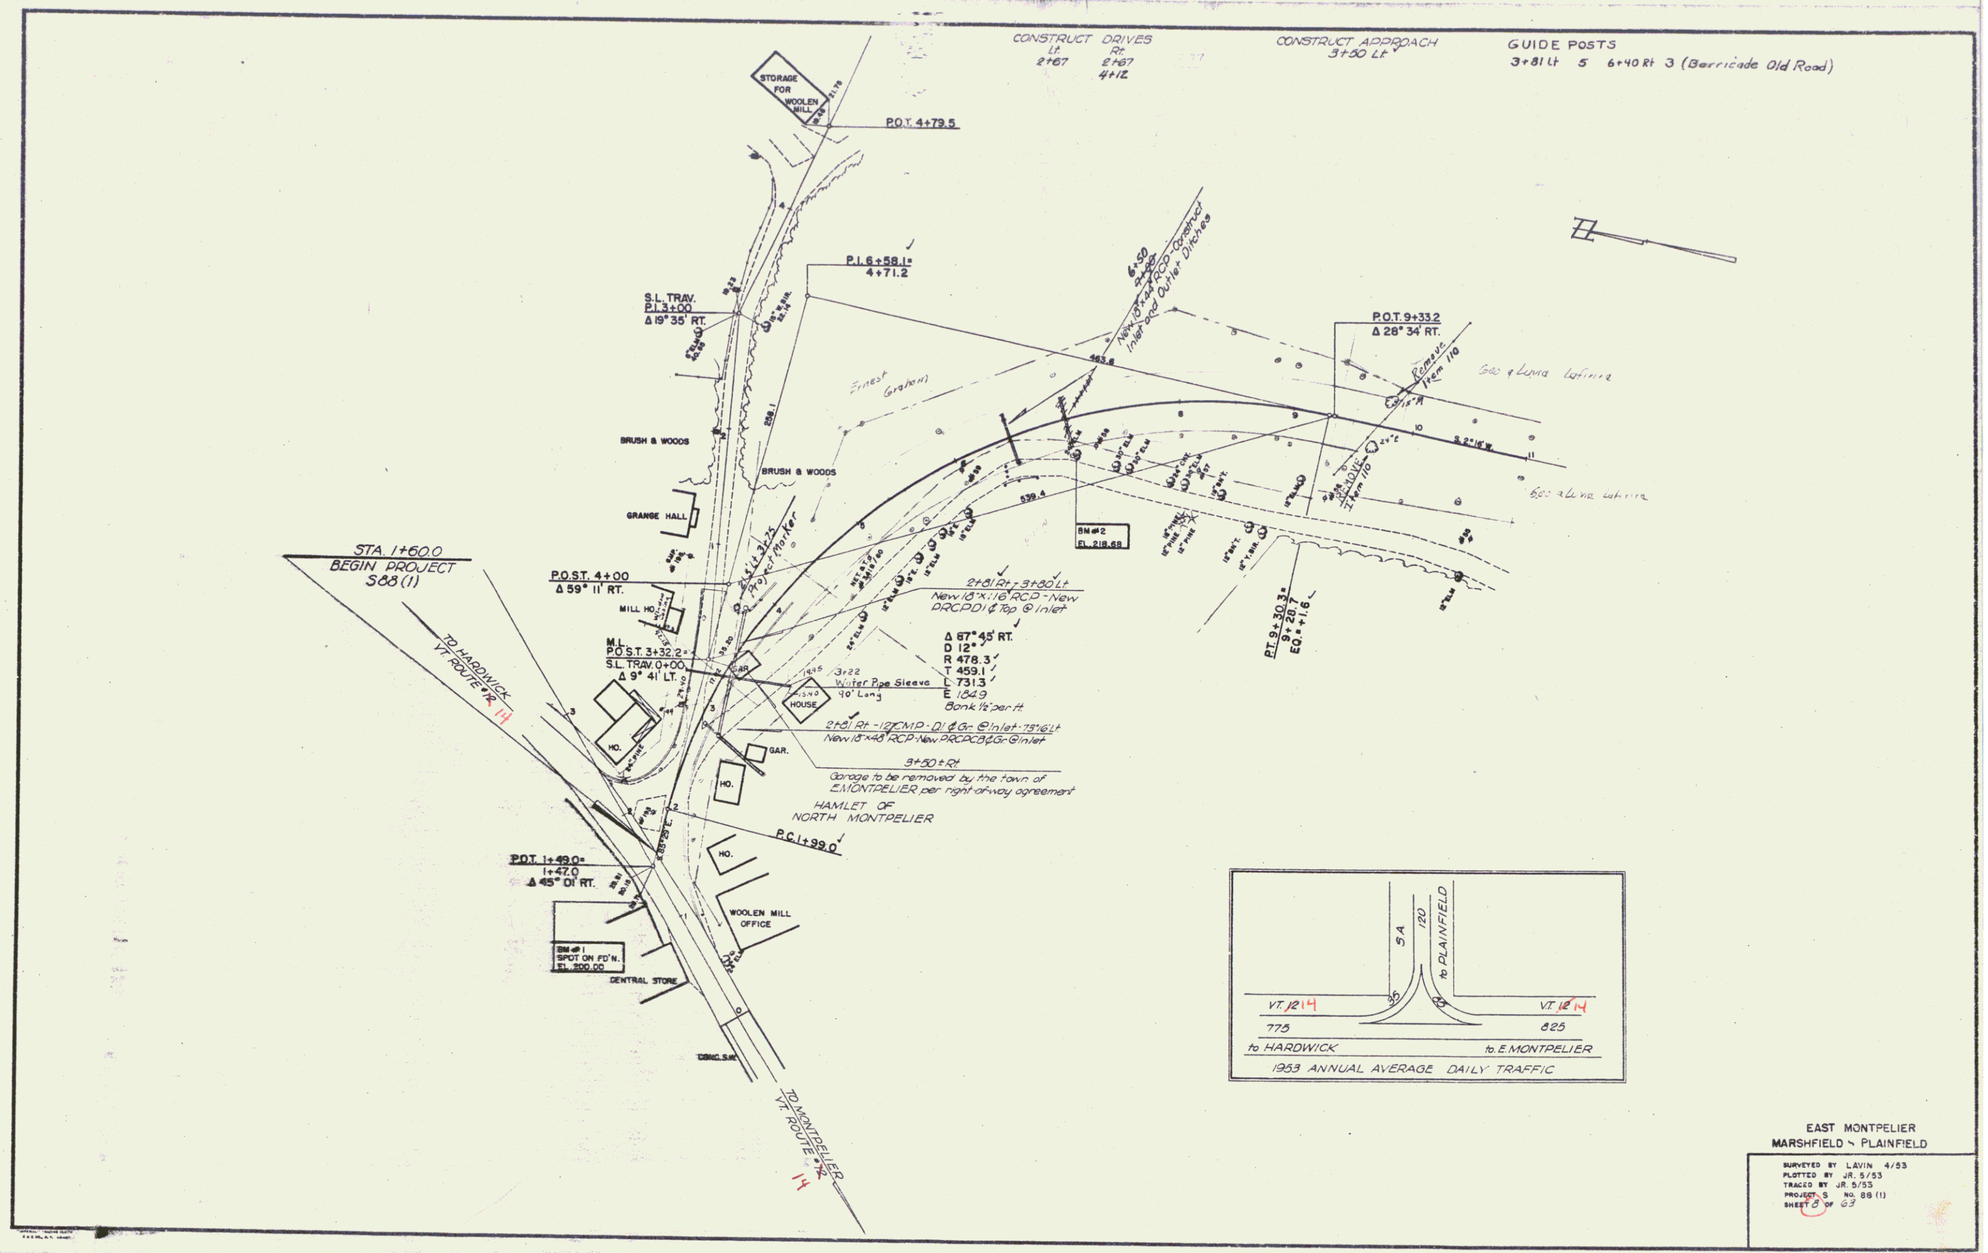

EAST MONTPELIER
MARSHFIELD ~ PLAINFIELD

SURVEYED BY LAVIN 4/53
PLOTTED BY JR. 5/53
TRACED BY JR. 5/53
PROJECT S NO. 88 (1)
SHEET 8 OF 63

2