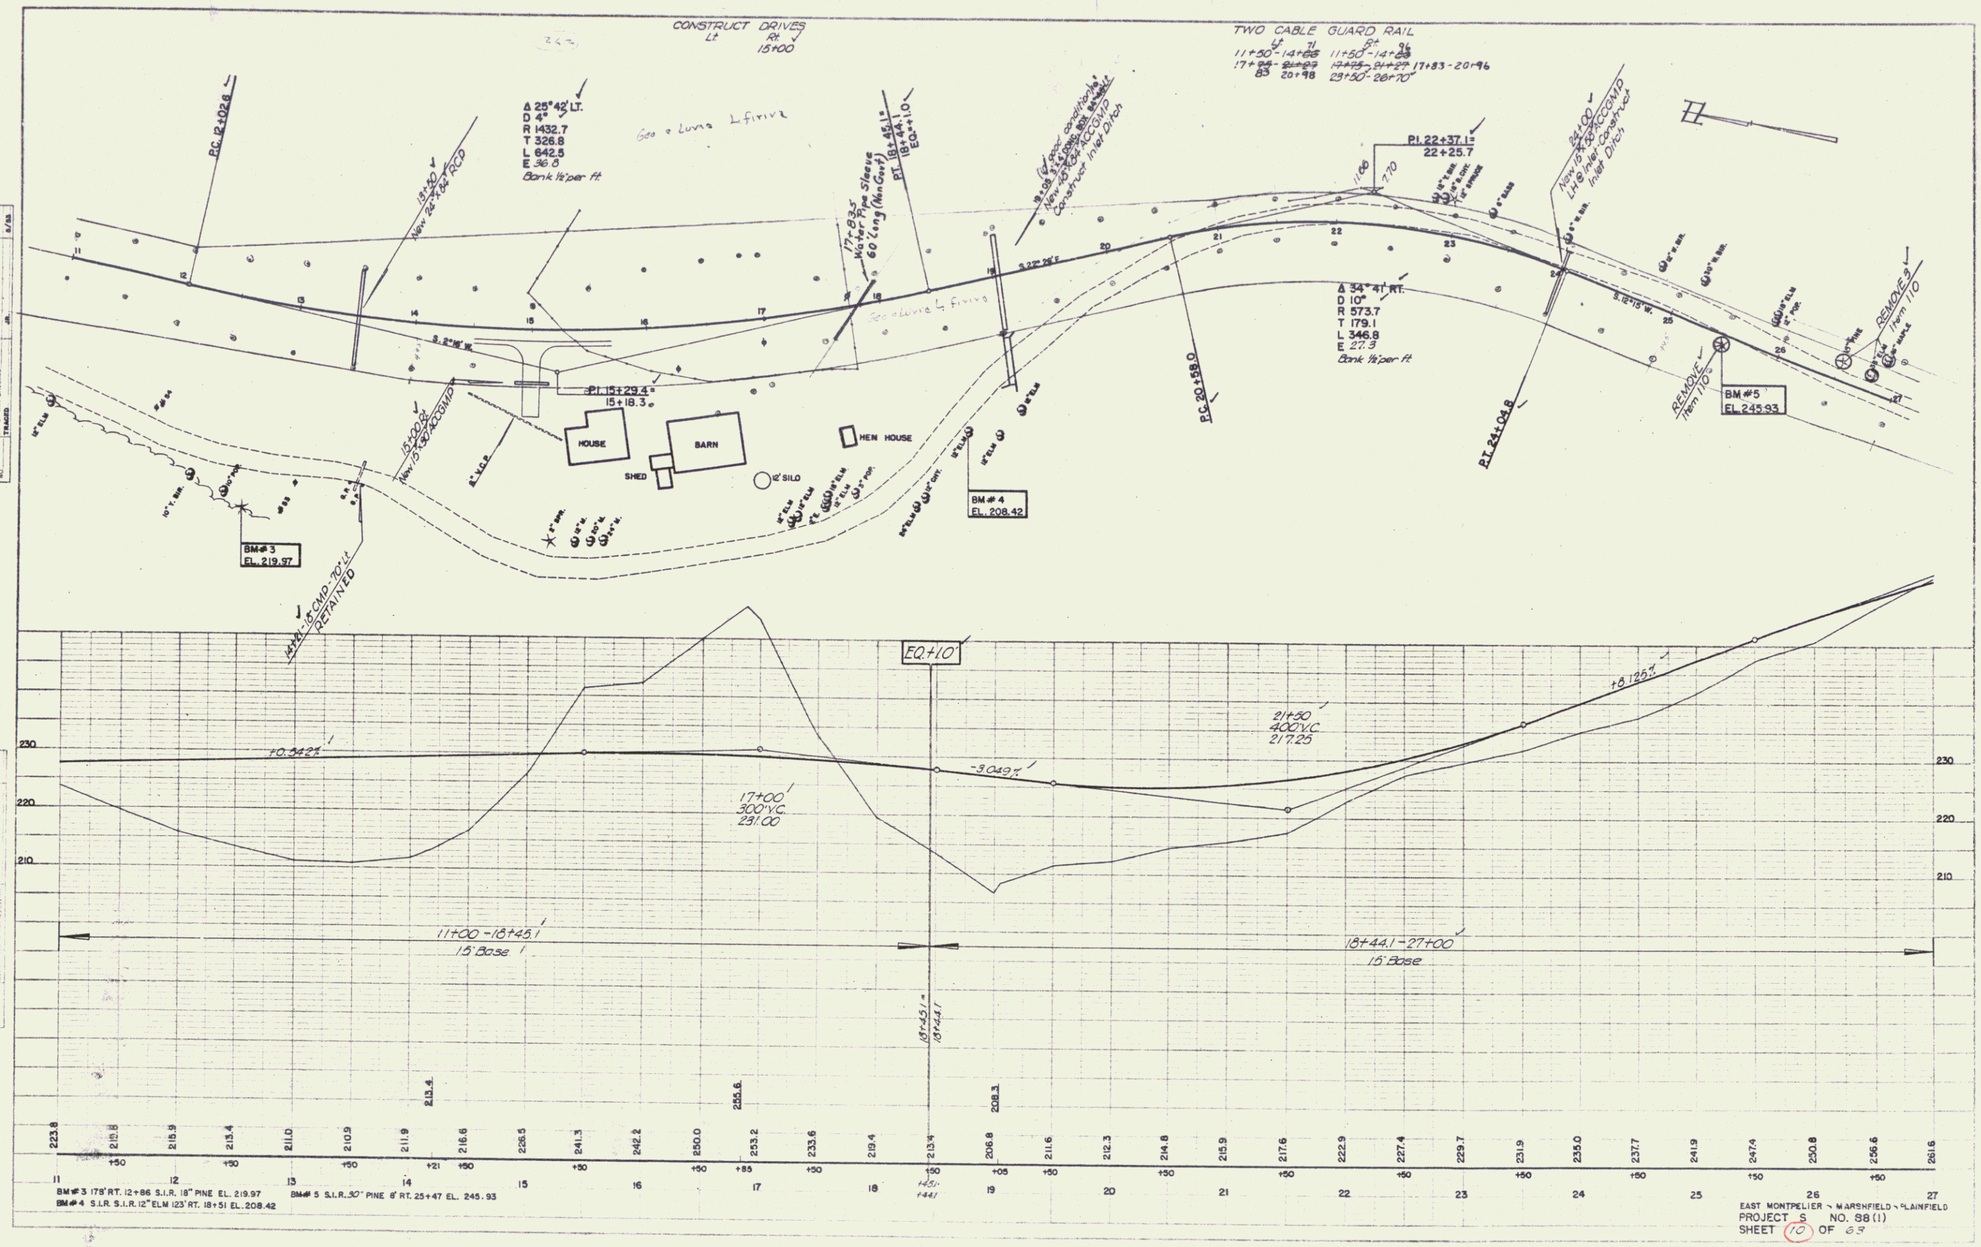
CONSTRUCT DRIVES
Lt Rt
15+00
TWO CABLE GUARD RAIL
Lt Rt
11+50 - 14+00 11+50 - 14+00
17+00 - 21+00 17+83 - 20+96
83 20+98 29+50 - 26+70
Δ 25° 42' LT.
D 4°
R 1432.7
T 326.8
L 642.5
E 36.0
Bank 1½ per ft
See Lump Lifting
P.C. 12+02.8
18+50
New 24" X 24' RCP
17+83
Water Pipe Sleeve
60' Long (Min. Cover)
Pt. 18+45.1
18+44.1
EQ.+10'
New 10" X 24' ACCGMP
Construct Inlet Ditch
Pl. 22+37.1
22+25.7
24+00
New 10" X 30' ACCGMP
Lift & Inlet Construct
Inlet Ditch
Δ 34° 41' RT.
D 10°
R 573.7
T 179.1
L 346.8
E 27.3
Bank 1½ per ft
S.2°18' W.
S.22°26' E.
Pl. 15+29.4
15+18.3
15+00
New 15" X 30' ACCGMP
HOUSE
BARN
SHED
12' SILO
HEN HOUSE
P.C. 20+58.0
P.T. 24+04.8
REMOVE
Item 110
BM #3
EL. 219.97
BM #4
EL. 208.42
BM #5
EL. 245.93
14+00 - 15" CMP - 70' L.F.
RETAINED
+0.442%
-3.049%
+8.135%
17+00
300' V.C.
231.00
21+50
400' V.C.
217.25
11+00 - 18+45.1
15' Base
18+44.1 - 27+00
15' Base
18+45.1 =
18+44.1
223.8 215.8 215.9 213.4 211.0 210.9 211.9 216.6 226.5 241.3 242.2 250.0 253.2 233.6 219.4 213.4 206.8 211.6 212.3 214.8 215.9 217.6 222.9 227.4 229.7 231.9 235.0 237.7 241.9 247.4 250.8 256.6 261.6
BM #3 179' RT. 12+86 S.I.R. 18" PINE EL. 219.97
BM #4 S.I.R. S.I.R. 12" ELM 125' RT. 18+51 EL. 208.42
BM #5 S.I.R. 30" PINE 8' RT. 25+47 EL. 245.93
EAST MONTPELIER - MARSHFIELD - PLAINFIELD
PROJECT S NO. 98(1)
SHEET 10 OF 63

3