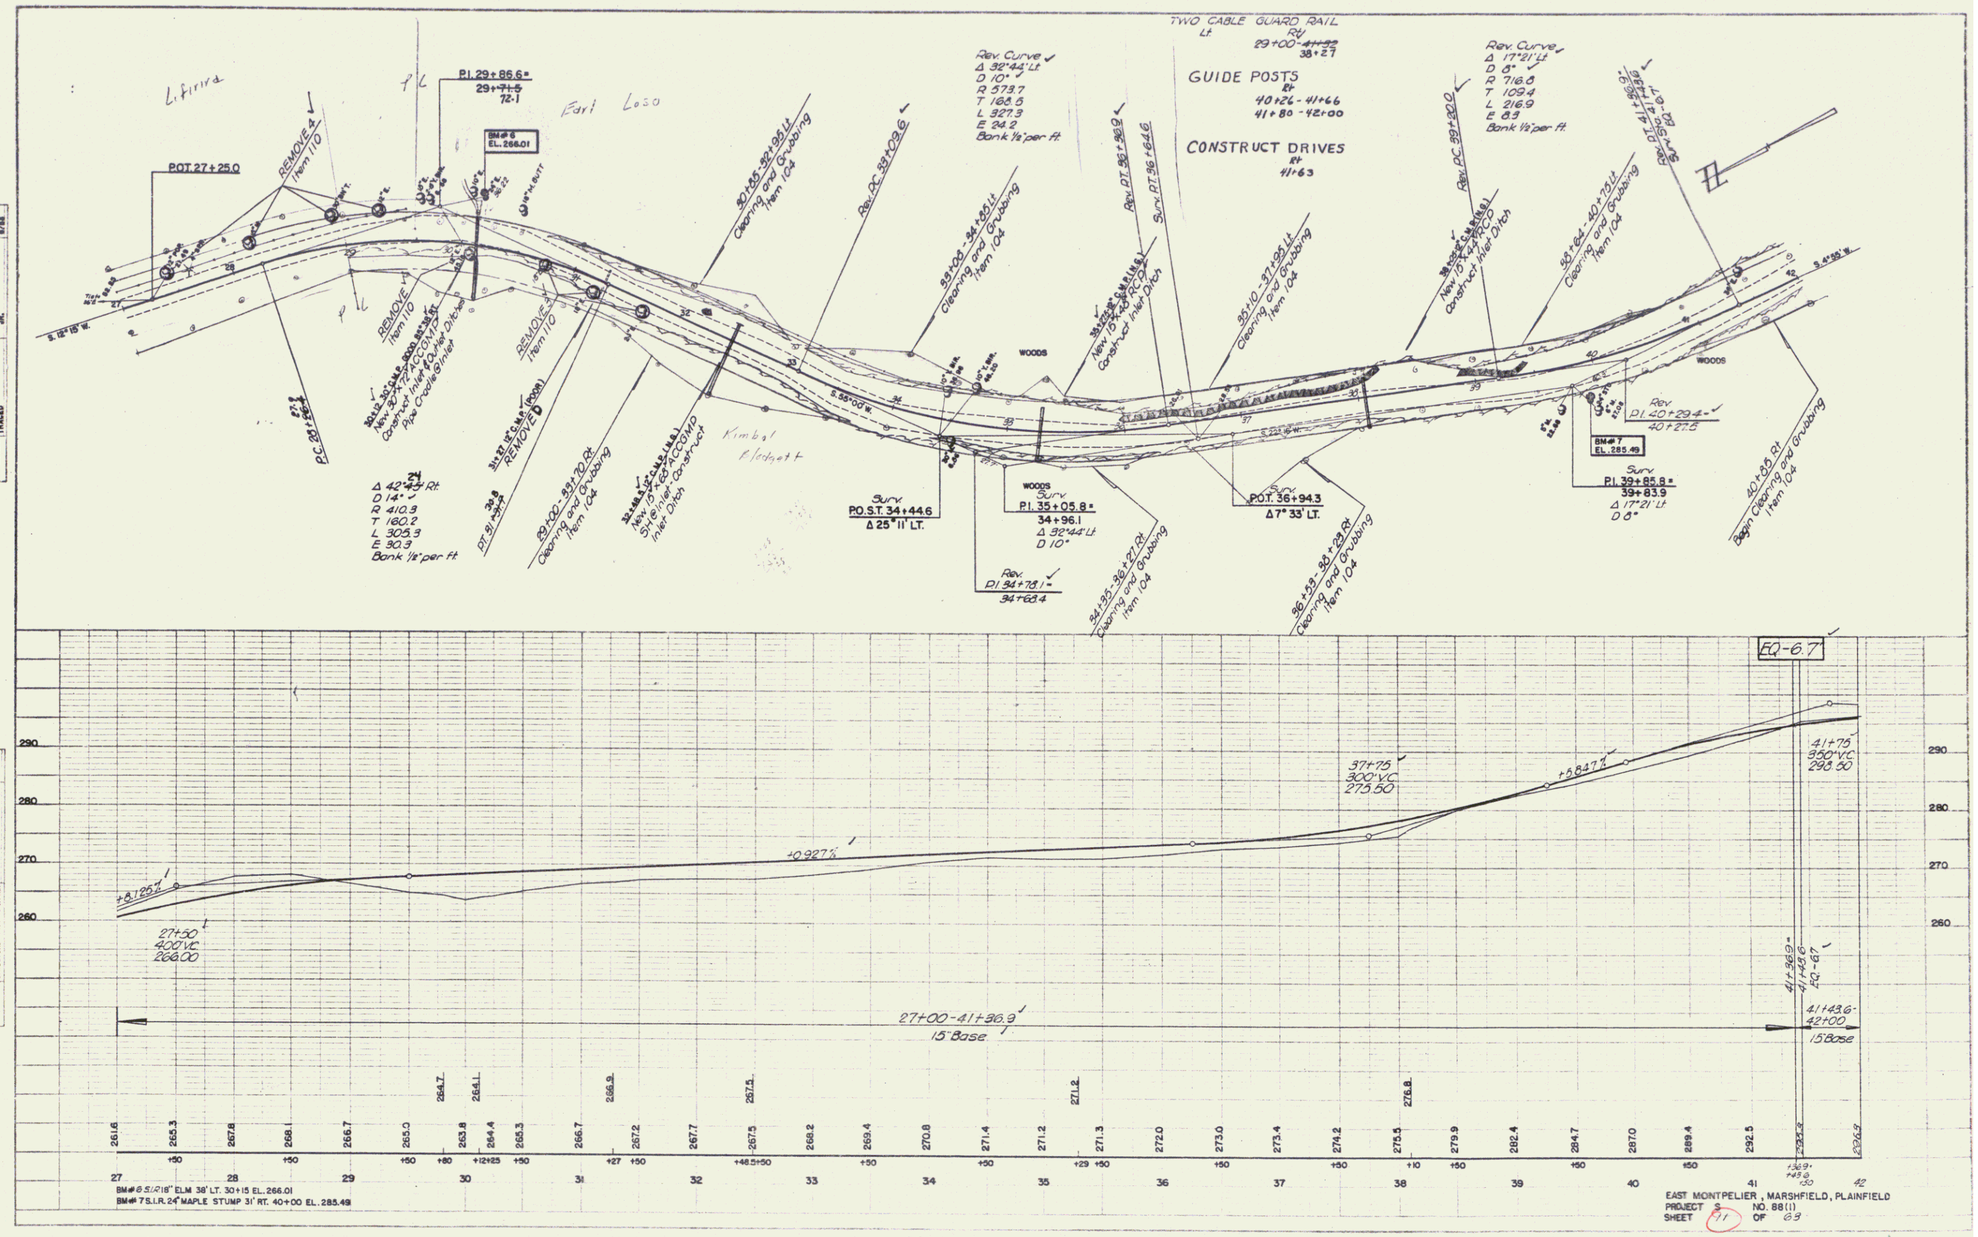

EAST MONTPELIER, MARSHFIELD, PLAINFIELD
PROJECT S NO. 88(1)

4