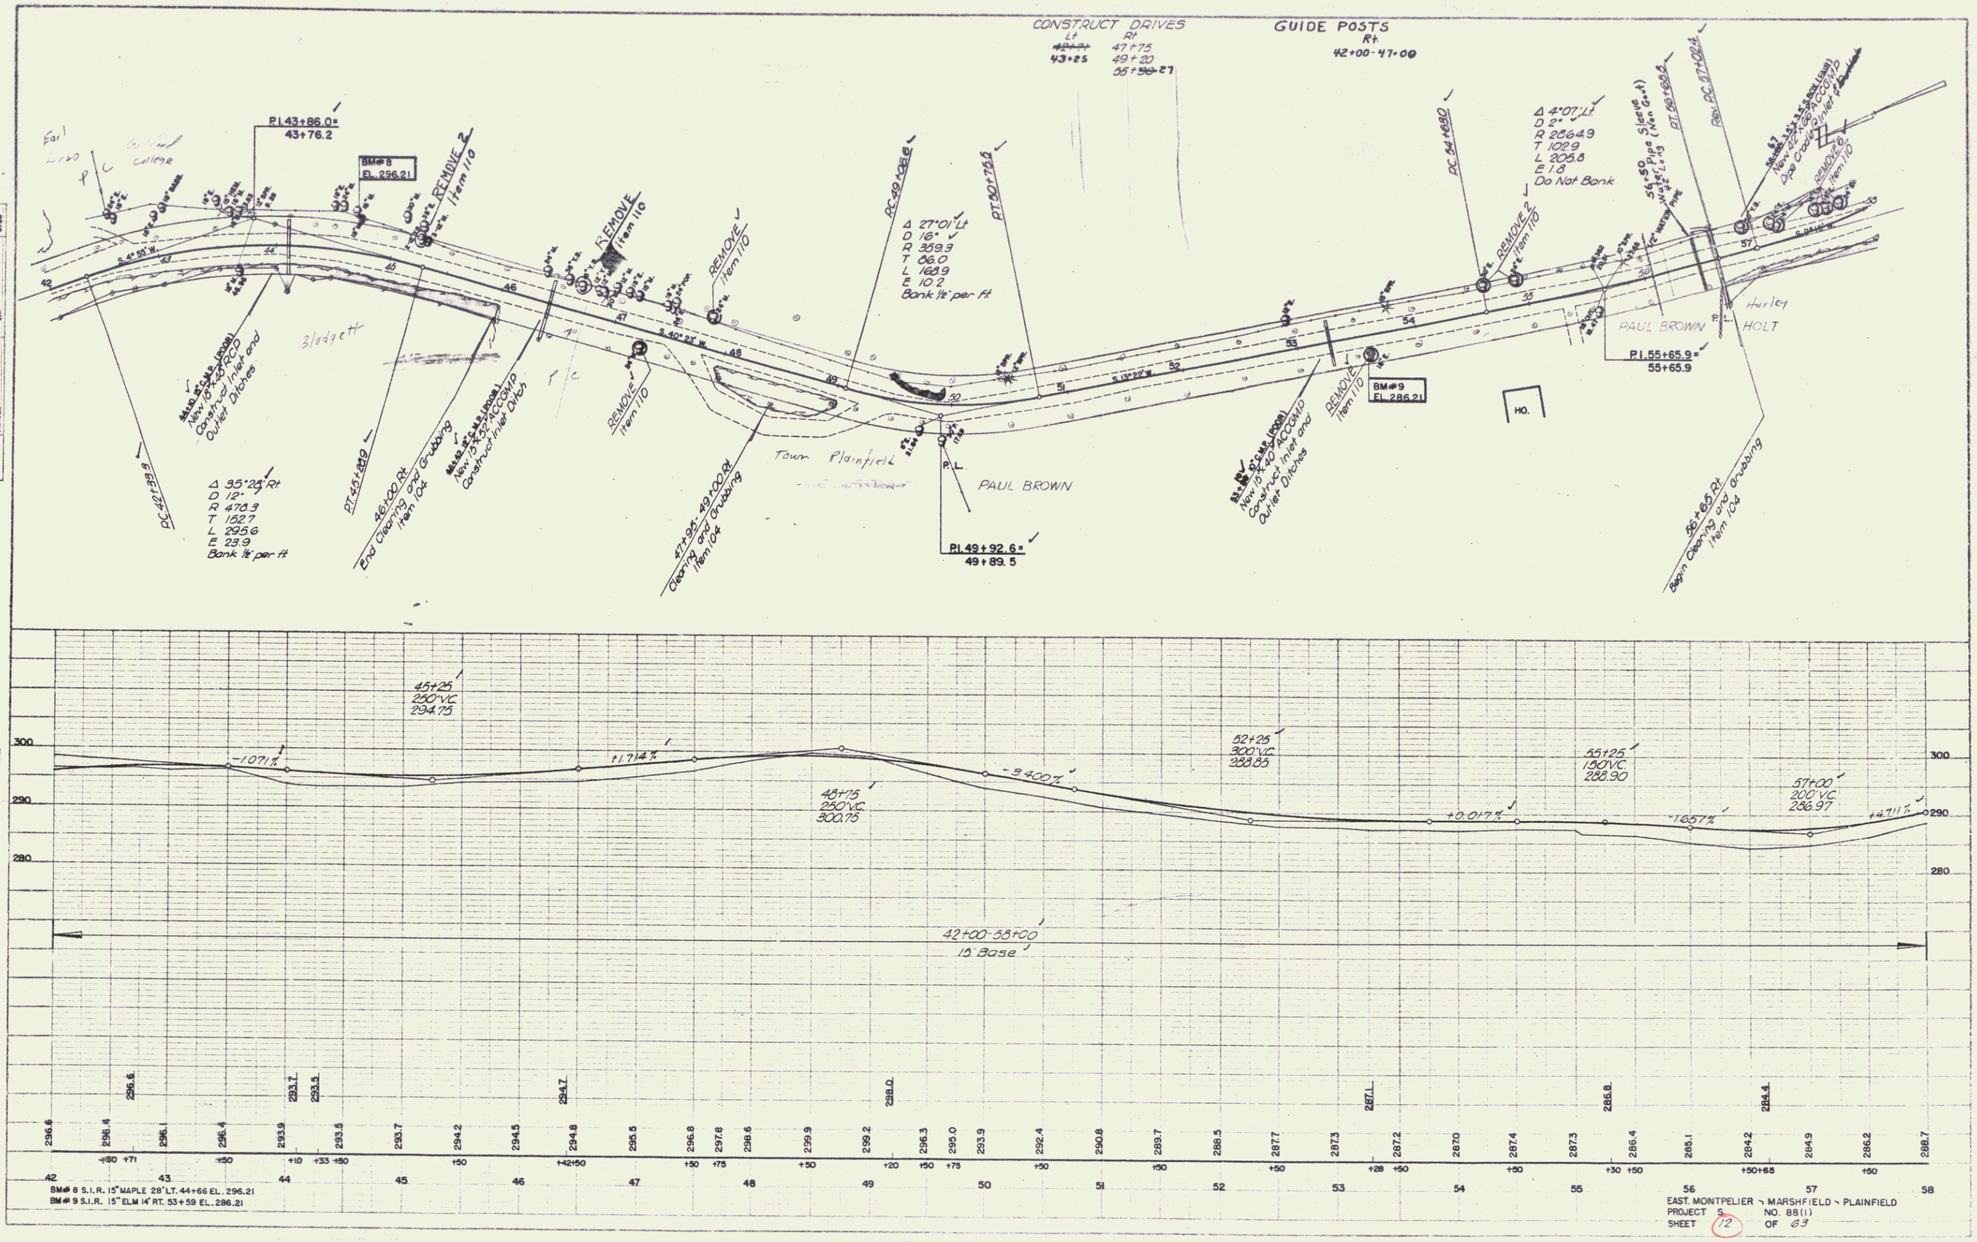
CONSTRUCT DRIVES
Lt
43+25
Rt
47+75
49+20
55+50-57
GUIDE POSTS
Rt
42+00-47+00
P.I. 43+86.0=
43+76.2
BM#8
EL. 296.21
REMOVE 2
Item 110
REMOVE
Item 110
Δ 27°01' Lt
D 16°
R 359.3
T 86.0
L 162.9
E 10.2
Bank ½" per ft
PC 49+02.8
PT 50+72.6
Δ 4°07' Lt
D 2°
R 2564.9
T 102.9
L 205.8
E 1.8
Do Not Bank
PC 54+60.0
PT 56+65.8
PC 57+02.4
Sleeve
Chan. Gate
Rem. Gate
Rem. Pipe
Rem. Concrete Headwall
Rem. Concrete Apron
New 24" x 38" CMP Arch
Dig Cross Drain Inlet
Remove Item 110
Δ 95°28' Rt
D 12°
R 478.3
T 152.7
L 295.6
E 23.9
Bank ½" per ft
PT 45+69
46+00 Rt
End Cleaning and Grubbing
Item 104
New 15" x 40" CMP Arch
Construct Inlet Ditch
New 15" x 40" CMP Arch
Construct Inlet and Outlet Ditches
47+96-49+00 Rt
Cleaning and Grubbing
Item 104
Town Plainfield
P.L.
PAUL BROWN
P.I. 49+92.6=
49+89.5
BM#9
EL. 286.21
HO.
P.I. 55+65.9=
55+65.9
Hurley
HOLT
56+85 Rt
Basin Cleaning and Grubbing
Item 104
45+25
250' VC
294.75
-1.071%
+1.714%
48+75
250' VC
300.75
-3.400%
52+25
300' VC
288.85
+0.017%
55+25
150' VC
288.90
-1.857%
57+00
200' VC
286.97
+4.711%
42+00-58+00
15' Base
296.6
296.4
296.1
296.4
293.9
293.7
293.5
293.8
293.7
294.2
294.5
294.7
294.8
295.5
296.8
297.8
298.6
299.9
299.2
299.0
296.3
295.0
293.9
292.4
290.8
289.7
288.5
287.7
287.3
287.1
287.2
287.0
287.4
287.3
286.8
286.4
285.1
284.2
284.4
284.9
286.2
286.7
BM# 8 S.I.R. 15" MAPLE 28' LT. 44+66 EL. 296.21
BM# 9 S.I.R. 15" ELM 14' RT. 53+59 EL. 286.21
EAST. MONTPELIER - MARSHFIELD - PLAINFIELD
PROJECT S NO. 88(1)
SHEET 12 OF 63
PLAN
PROFILE
LAYIN
TRACED

5