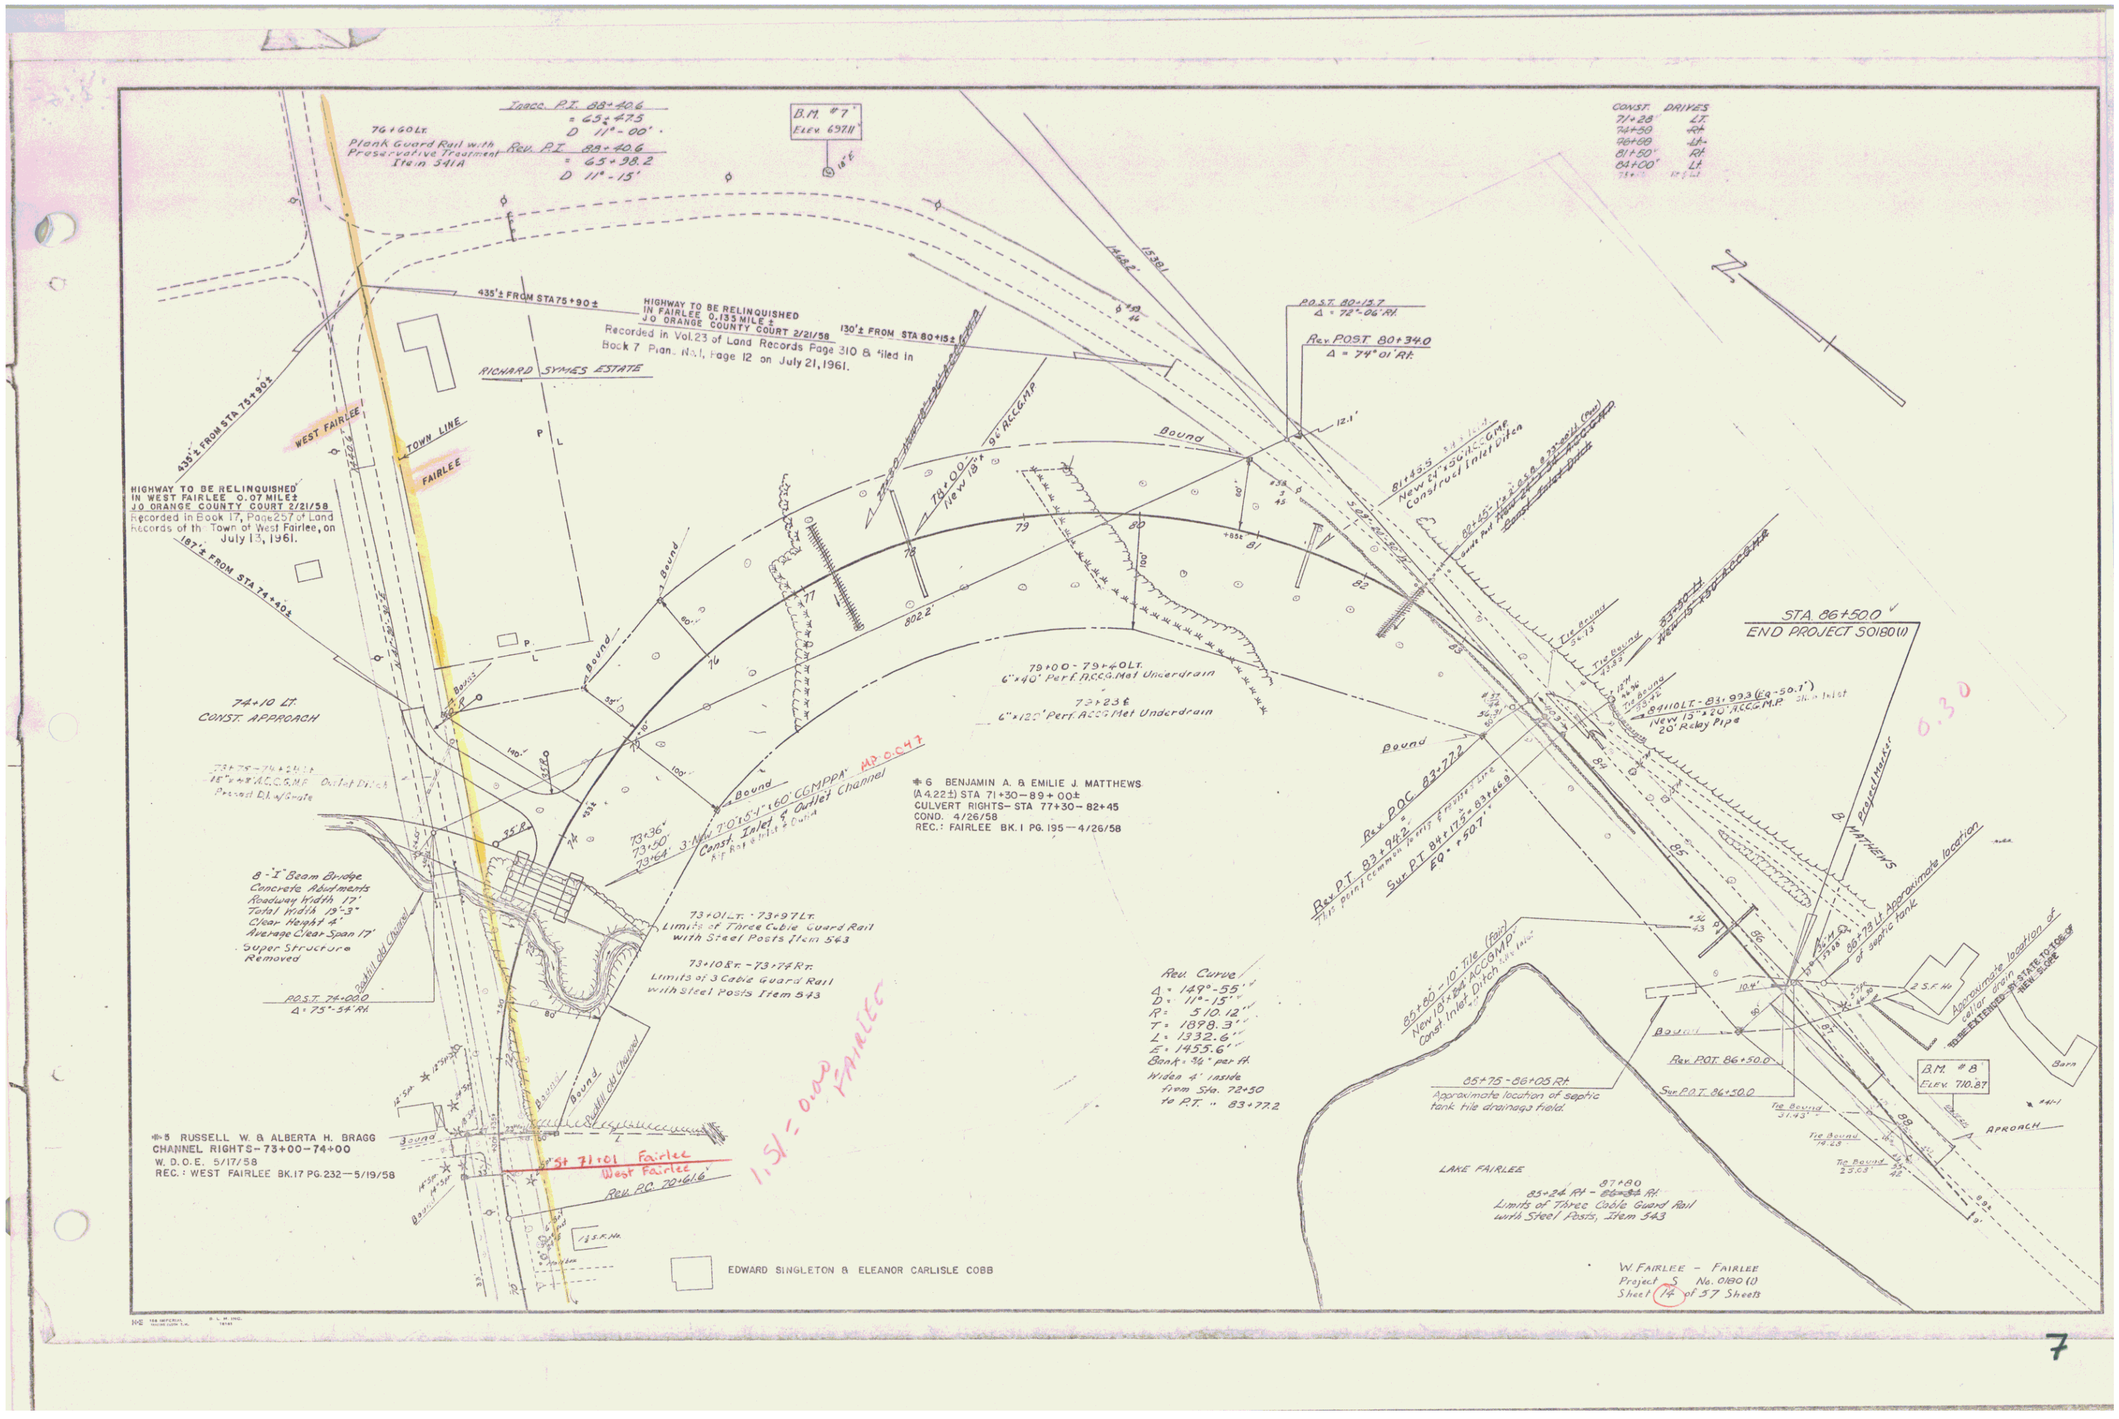
Trace P.T. 88+40.6
= 65+47.5
D 11°-00'
76+60 Lt.
Plank Guard Rail with Preservative Treatment Item 541A
Rev. P.T. 88+40.6
= 65+98.2
D 11°-15'
B.M. #7
Elev. 697.11'
CONST. DRIVES
71+28 Lt.
74+50 Rt.
76+00 Lt.
81+50' Rt.
84+00' Lt.
435'± FROM STA 75+90±
HIGHWAY TO BE RELINQUISHED IN FAIRLEE 0.135 MILE ± JO ORANGE COUNTY COURT 2/21/58
Recorded in Vol. 23 of Land Records Page 310 & filed in Book 7 Plan. No. 1, Page 12 on July 21, 1961.
130'± FROM STA 80+15±
RICHARD SYMES ESTATE
P.O.S.T. 80+15.7
Δ = 72°-26' Rt.
Rev. POST 80+34.0
Δ = 74°-01' Rt.
WEST FAIRLEE
TOWN LINE
FAIRLEE
HIGHWAY TO BE RELINQUISHED IN WEST FAIRLEE 0.07 MILE ± JO ORANGE COUNTY COURT 2/21/58
Recorded in Book 17, Page 257 of Land Records of the Town of West Fairlee, on July 13, 1961.
187'± FROM STA 74+40±
74+10 Lt.
CONST. APPROACH
79+00 - 79+40 Lt.
6"x40' Perf. ACCG. Met Underdrain
79+23 Rt.
6"x120' Perf. ACCG Met Underdrain
STA. 86+50.0
END PROJECT 5018011
New 15"x20' ACCG.M.P.
60' Relay Pipe
Rev. POC 83+72.2
Rev. P.T. 83+94.2
Sur. P.T. But 1½" 83+66.8
EQ. +50.7'
Rev. Curve
Δ = 149°-55'
D = 11°-15'
R = 510.12'
T = 1898.3'
L = 1332.6'
E = 1455.6'
Bank: 36" per ft.
Widen 4' inside from Sta. 72+50 to P.T. 83+77.2
8"-I Beam Bridge
Concrete Abutments
Roadway Width 17'
Total Width 19'-3"
Clear Height 4'
Average Clear Span 17'
Super Structure Removed
P.O.S.T. 74+00.0
Δ = 75°-54' Rt.
73+01 Lt. - 73+97 Lt.
Limits of Three Cable Guard Rail with Steel Posts, Item 543
73+10 Rt. - 73+74 Rt.
Limits of 3 Cable Guard Rail with Steel Posts Item 543
Const. Inlet & Outlet Channel
MP 0.647
6 BENJAMIN A. & EMILIE J. MATTHEWS
(A 4.22±) STA 71+30 - 89+00±
CULVERT RIGHTS - STA 77+30 - 82+45
COND. 4/26/58
REC.: FAIRLEE BK. I PG. 195 - 4/26/58
5 RUSSELL W. & ALBERTA H. BRAGG
CHANNEL RIGHTS - 73+00 - 74+00
W. D. O. E. 5/17/58
REC.: WEST FAIRLEE BK. 17 PG. 232 - 5/19/58
Old Hill Old Channel
Bound
Tie Bound
P.O.S.T. 71+01 Fairlee West Fairlee
Rev. P.O. 70+61.6'
1.51 = 0.02 FAIRLEE
EDWARD SINGLETON & ELEANOR CARLISLE COBB
85+80 - 10" Tile (Rip) New 10" Rd. ACCMP Const. Inlet & Ditch
85+75 - 86+05 Rt.
Approximate location of septic tank tile drainage field.
LAKE FAIRLEE
87+80
85+24 Rt. - 86+34 Rt.
Limits of Three Cable Guard Rail with Steel Posts, Item 543
Rev. P.O.T. 86+50.0
Sur. P.O.T. 86+50.0
B. MATTHEWS
Approximate location of septic tank
Approximate location of edge of pavement to be extended by state to tie of new culvert
B.M. #8
Elev. 710.87
Barn
APPROACH
W. FAIRLEE - FAIRLEE
Project S No. 0180(1)
Sheet 14 of 37 Sheets