PARCEL	INSTRUMENT	DATE	GRANTOR	GRANTEE	RECORDED FAIRLEE BOOK	PAGE	DATE	REMARKS
#4A	W.D.O.E.	8-24-48	ALFRED W. & AUGUSTA P. BACON	ST. OF VT.	20	318-319	9-2-48	

F.A.S. ROAD DIST. NO.	STATE		FISCAL YEAR	SHEET NO.	TOTAL SHEETS
9	S	176(3)	1948	9	28

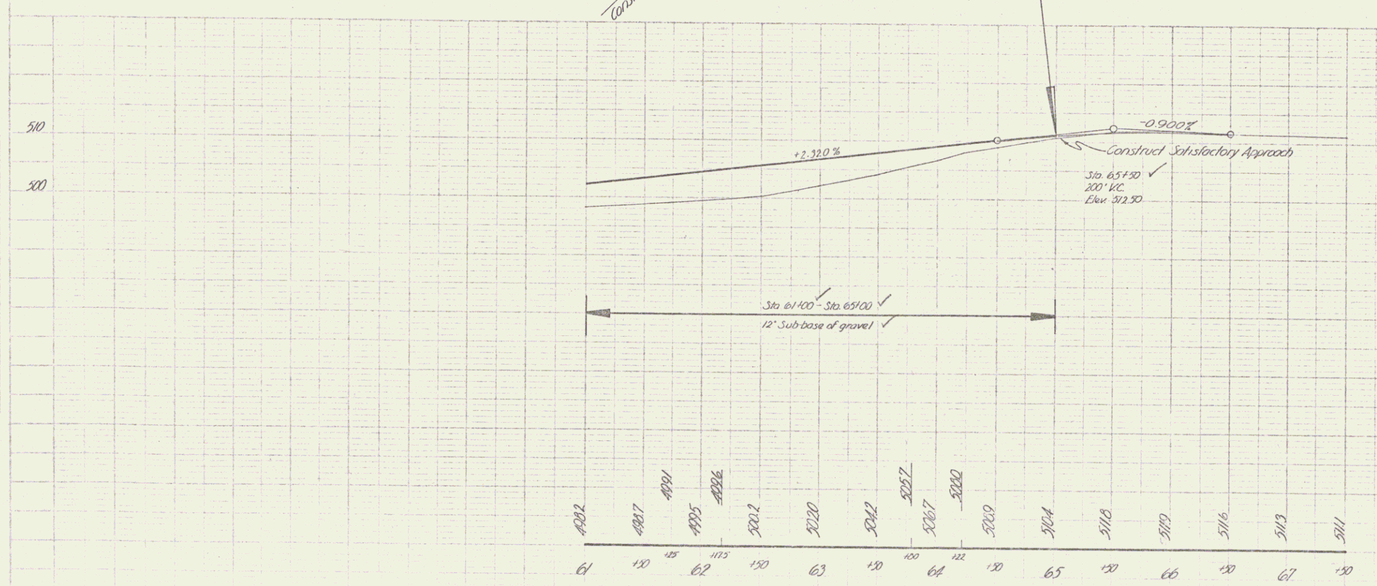

B.M. #10 Spike in root 12" Pine 24 ft. rt sta 61+69 Elev. 496.24

FAIRLEE
Series S No 176 (3)
Sheet 9 of 28 Sheets

6