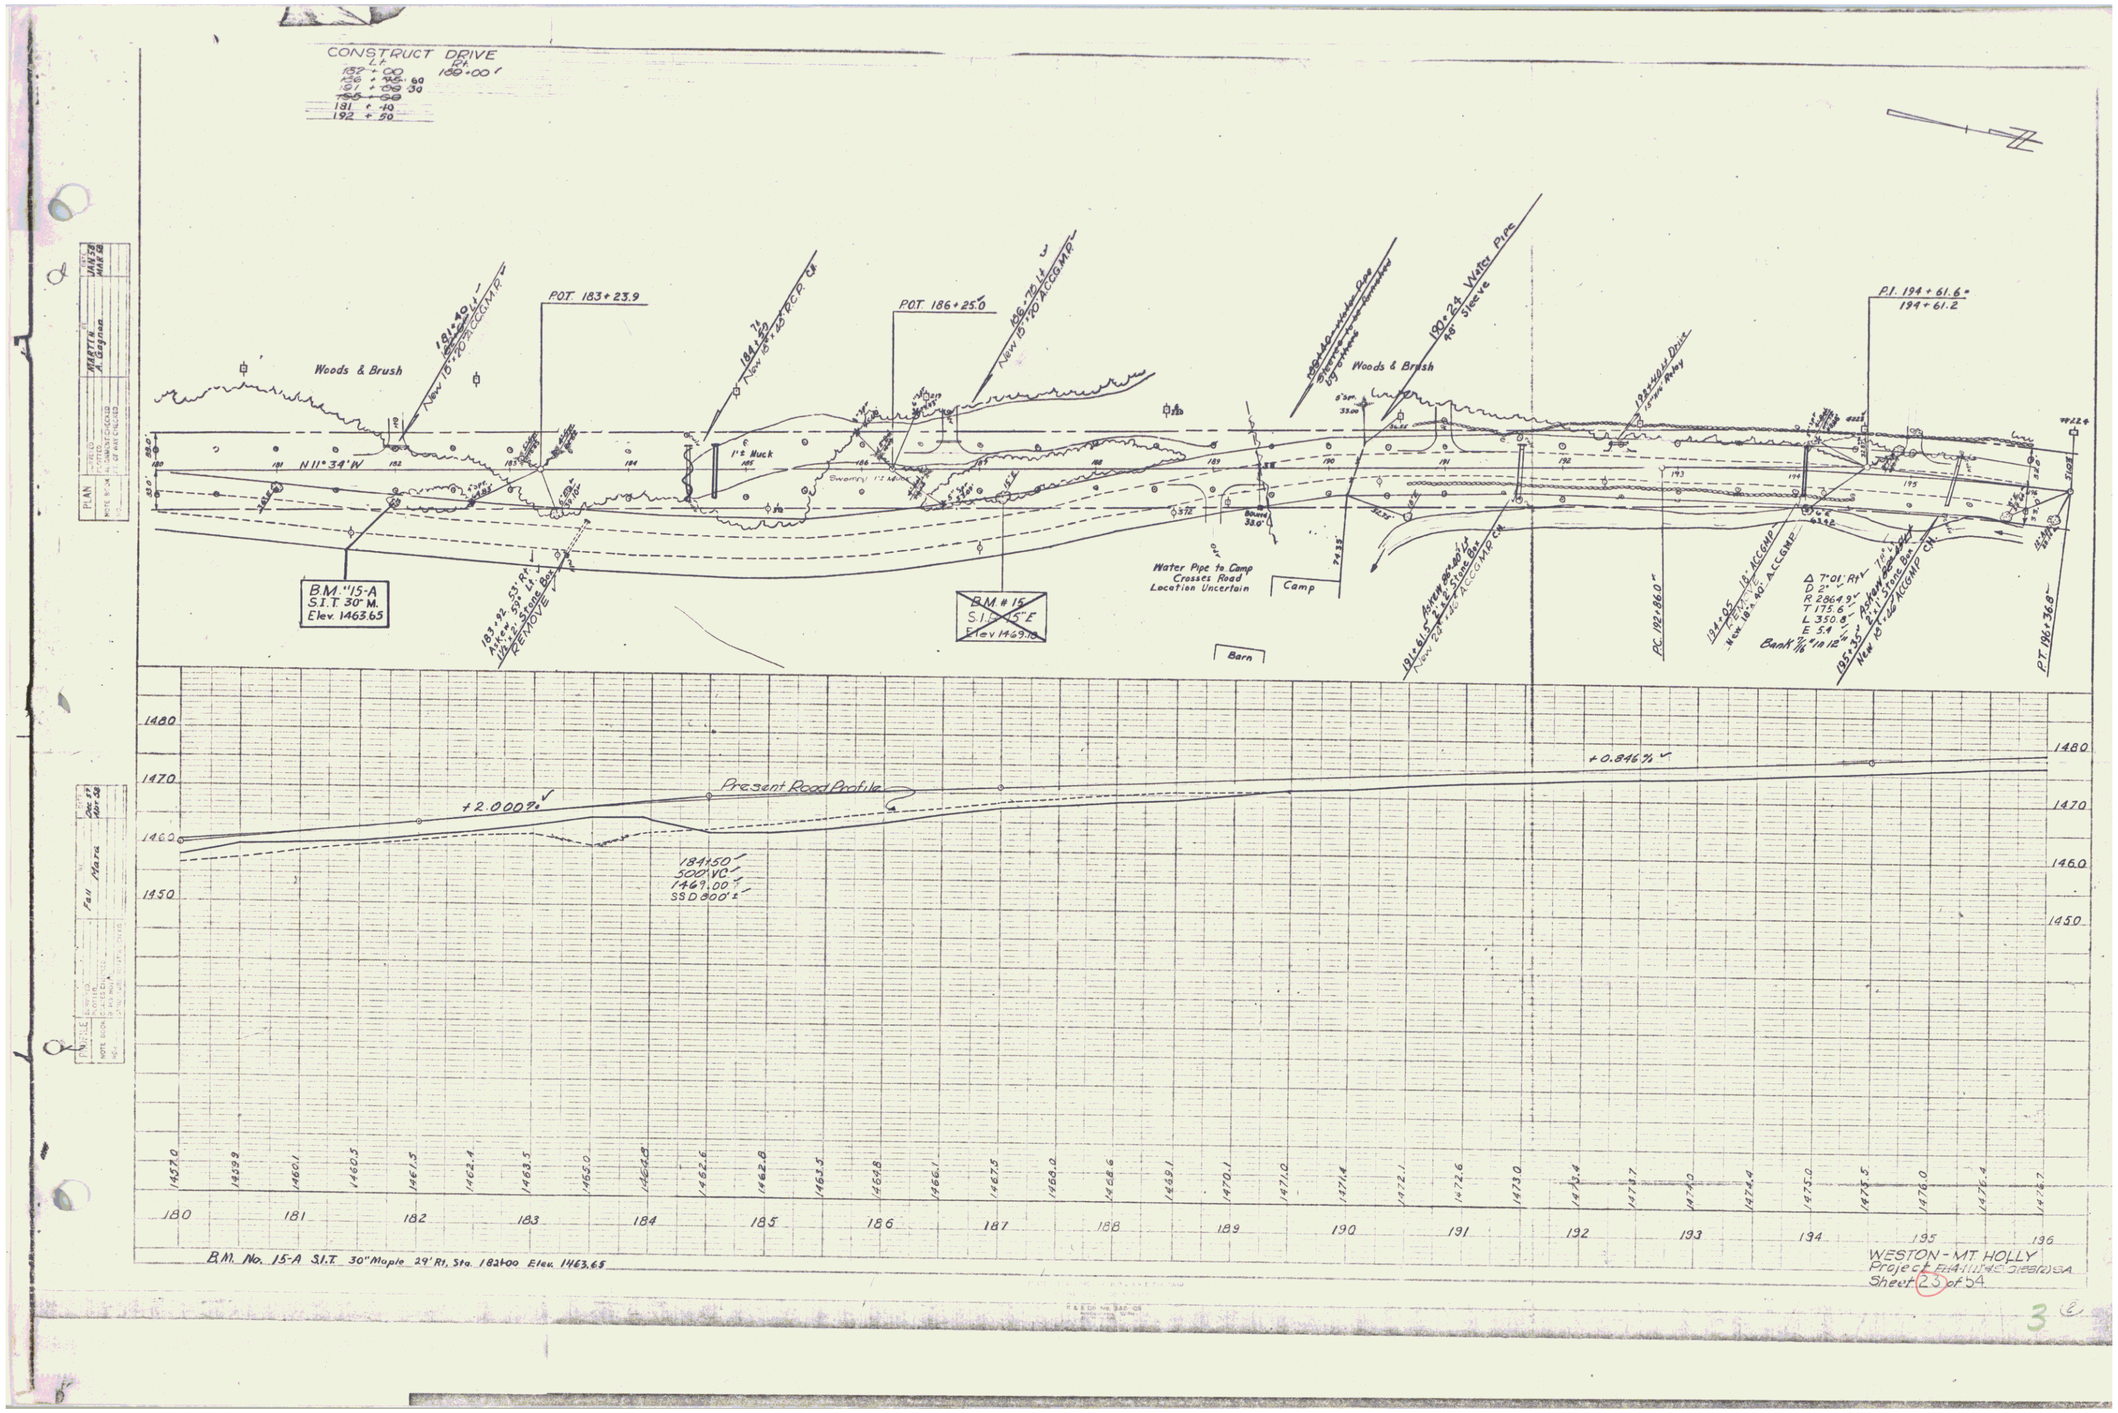
CONSTRUCT DRIVE
S.T. 152 + 00
156 + 145.50
157 + 159.30
180 + 68
181 + 10
192 + 50
Ch. 180+00'
Woods & Brush
N 11° 34' W
POT. 183+23.9
POT. 186+25.0
1" ± Muck
Swampy
B.M. "15-A
S.I.T. 30" M.
Elev. 1463.65
B.M. # 15
S.I.T. 15" E
Elev. 1469.70
Water Pipe to Camp
Crosses Road
Location Uncertain
Camp
Barn
Woods & Brush
48" Sleeve
P.I. 194 + 61.6
194 + 61.2
PC 192+86.0
PT 196+36.8
Present Road Profile
+2.000%
+0.846%
1480
1470
1460
1450
180
181
182
183
184
185
186
187
188
189
190
191
192
193
194
195
196
B.M. No. 15-A S.I.T. 30" Maple 29' Rt. Sta. 182+00 Elev. 1463.65
WESTON - MT. HOLLY
Project
Sheet 23 of 54