




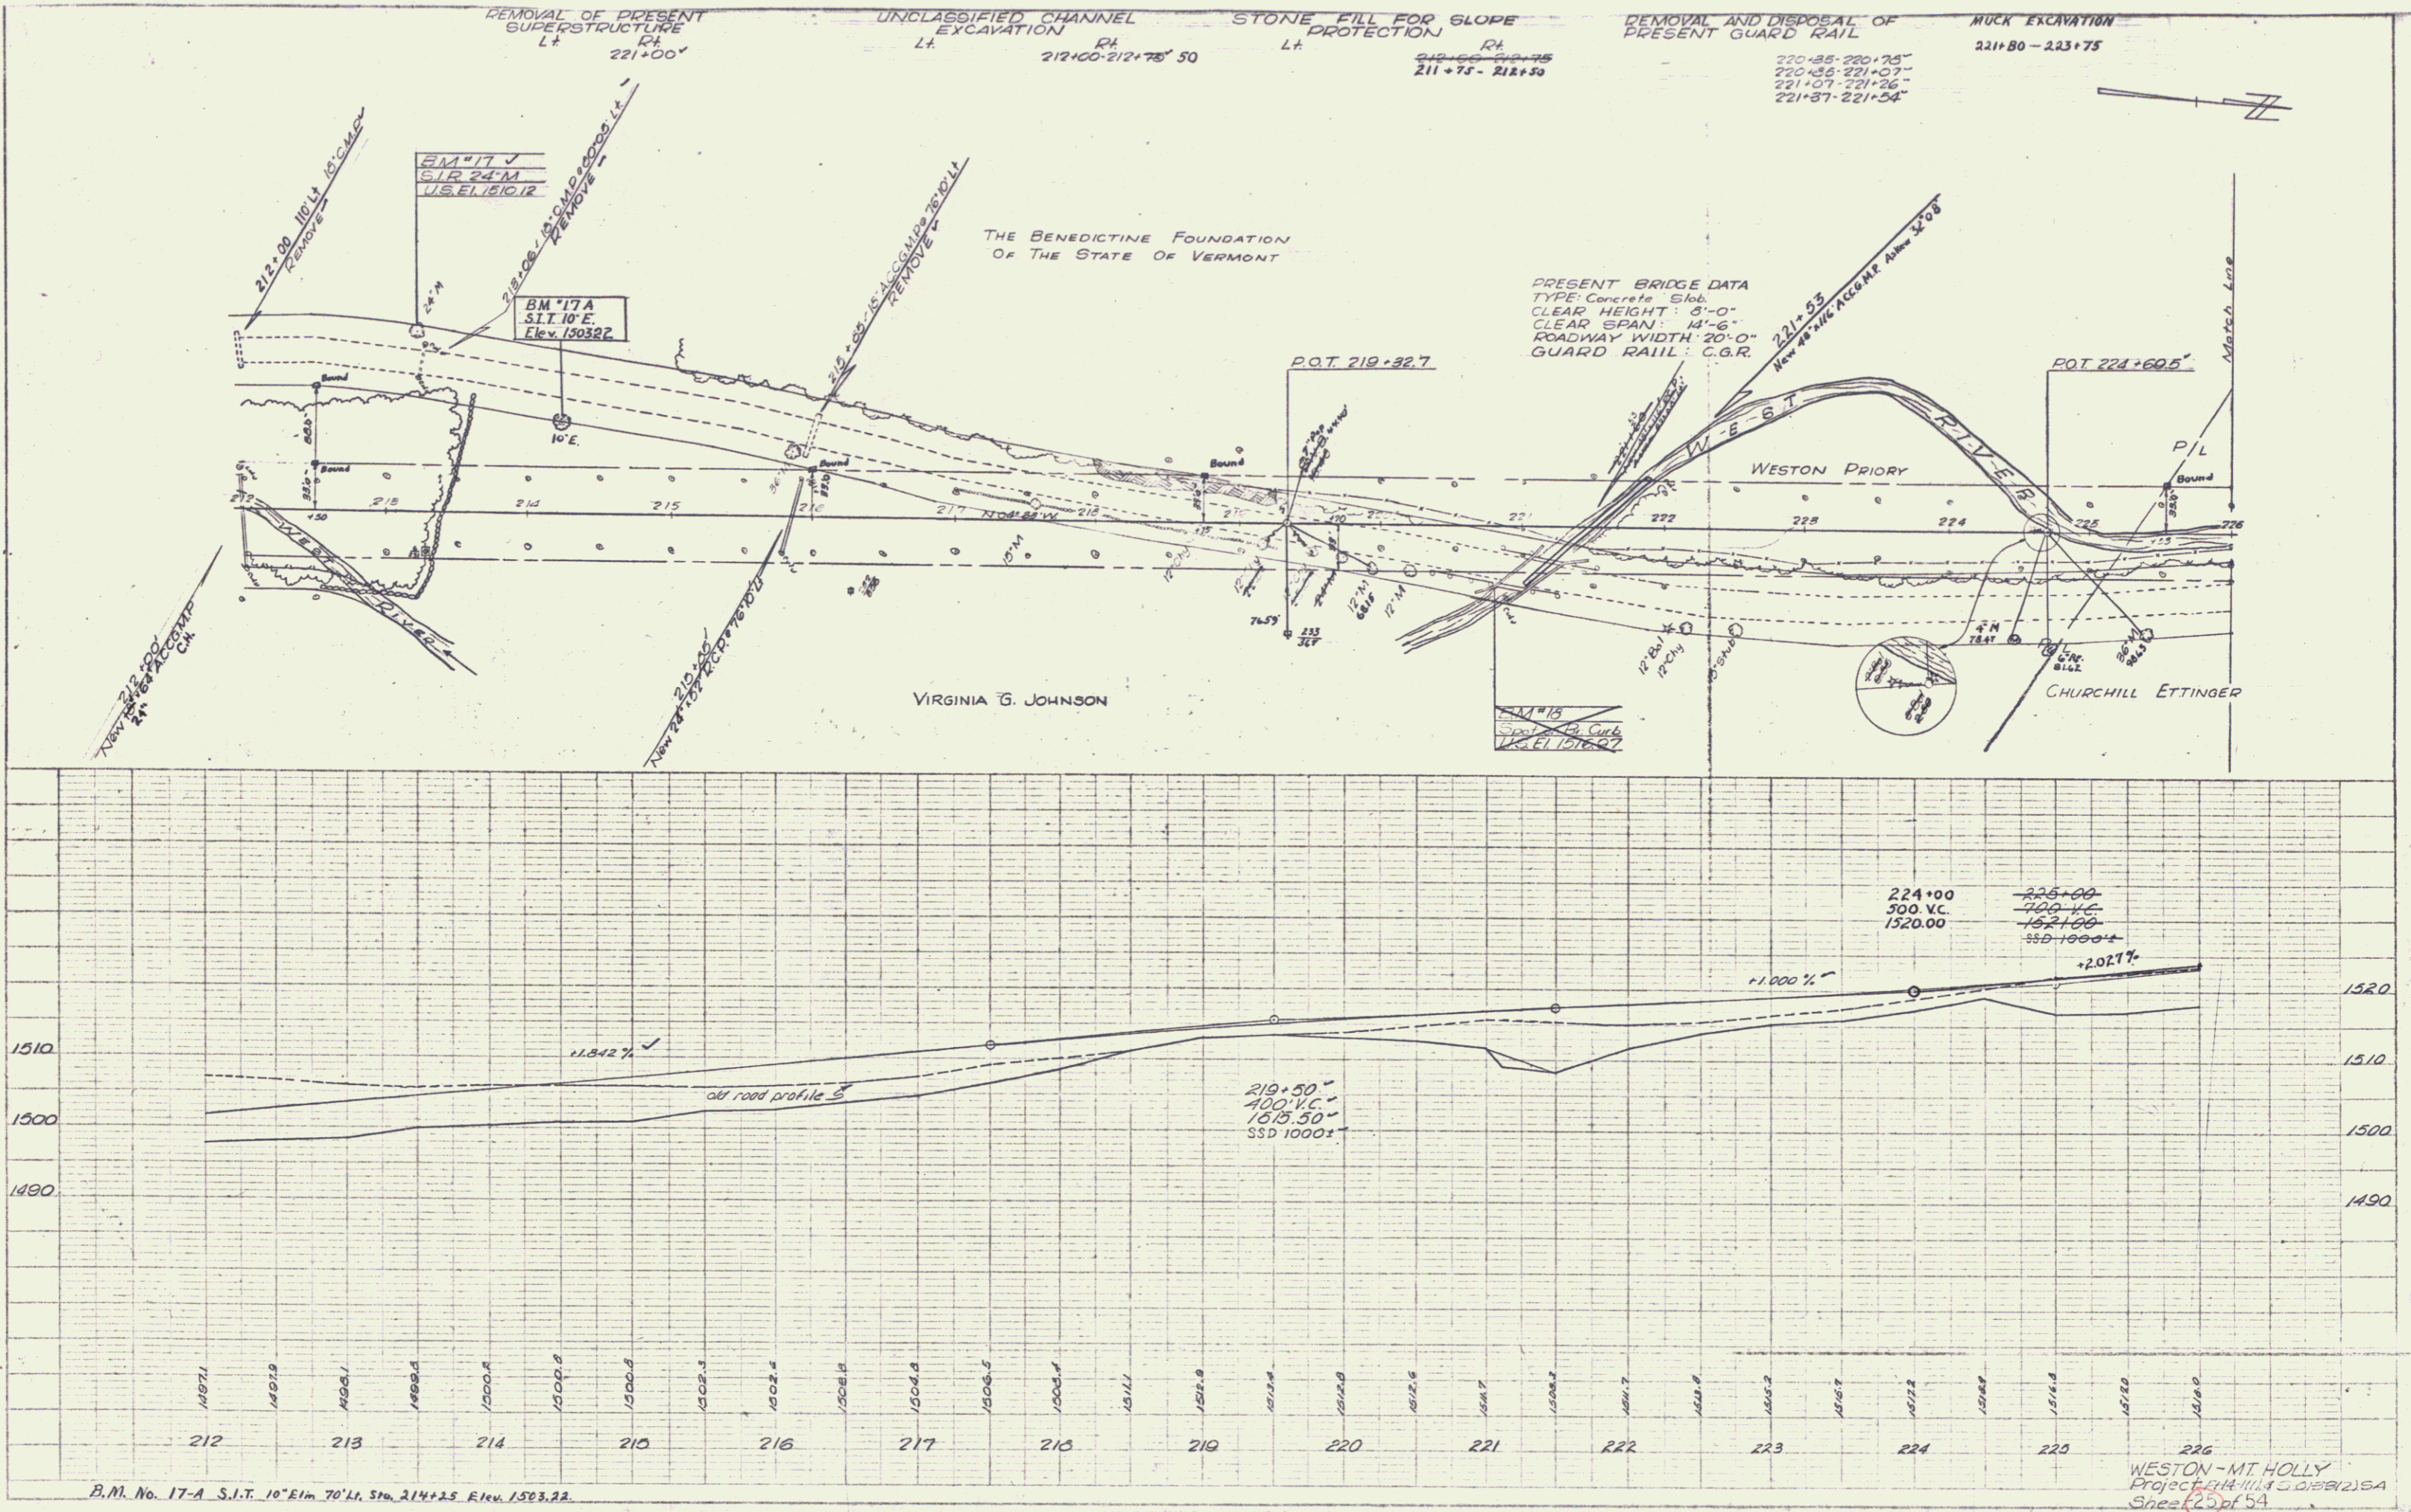

B.M. No. 17-A S.I.T. 10' Elm 70' Lt. Sta. 214+2.5 Elev. 1503.22

LEVEL PLAN PROFILE & P. & L. SURFACE

WESTON - MT. HOLLY  
