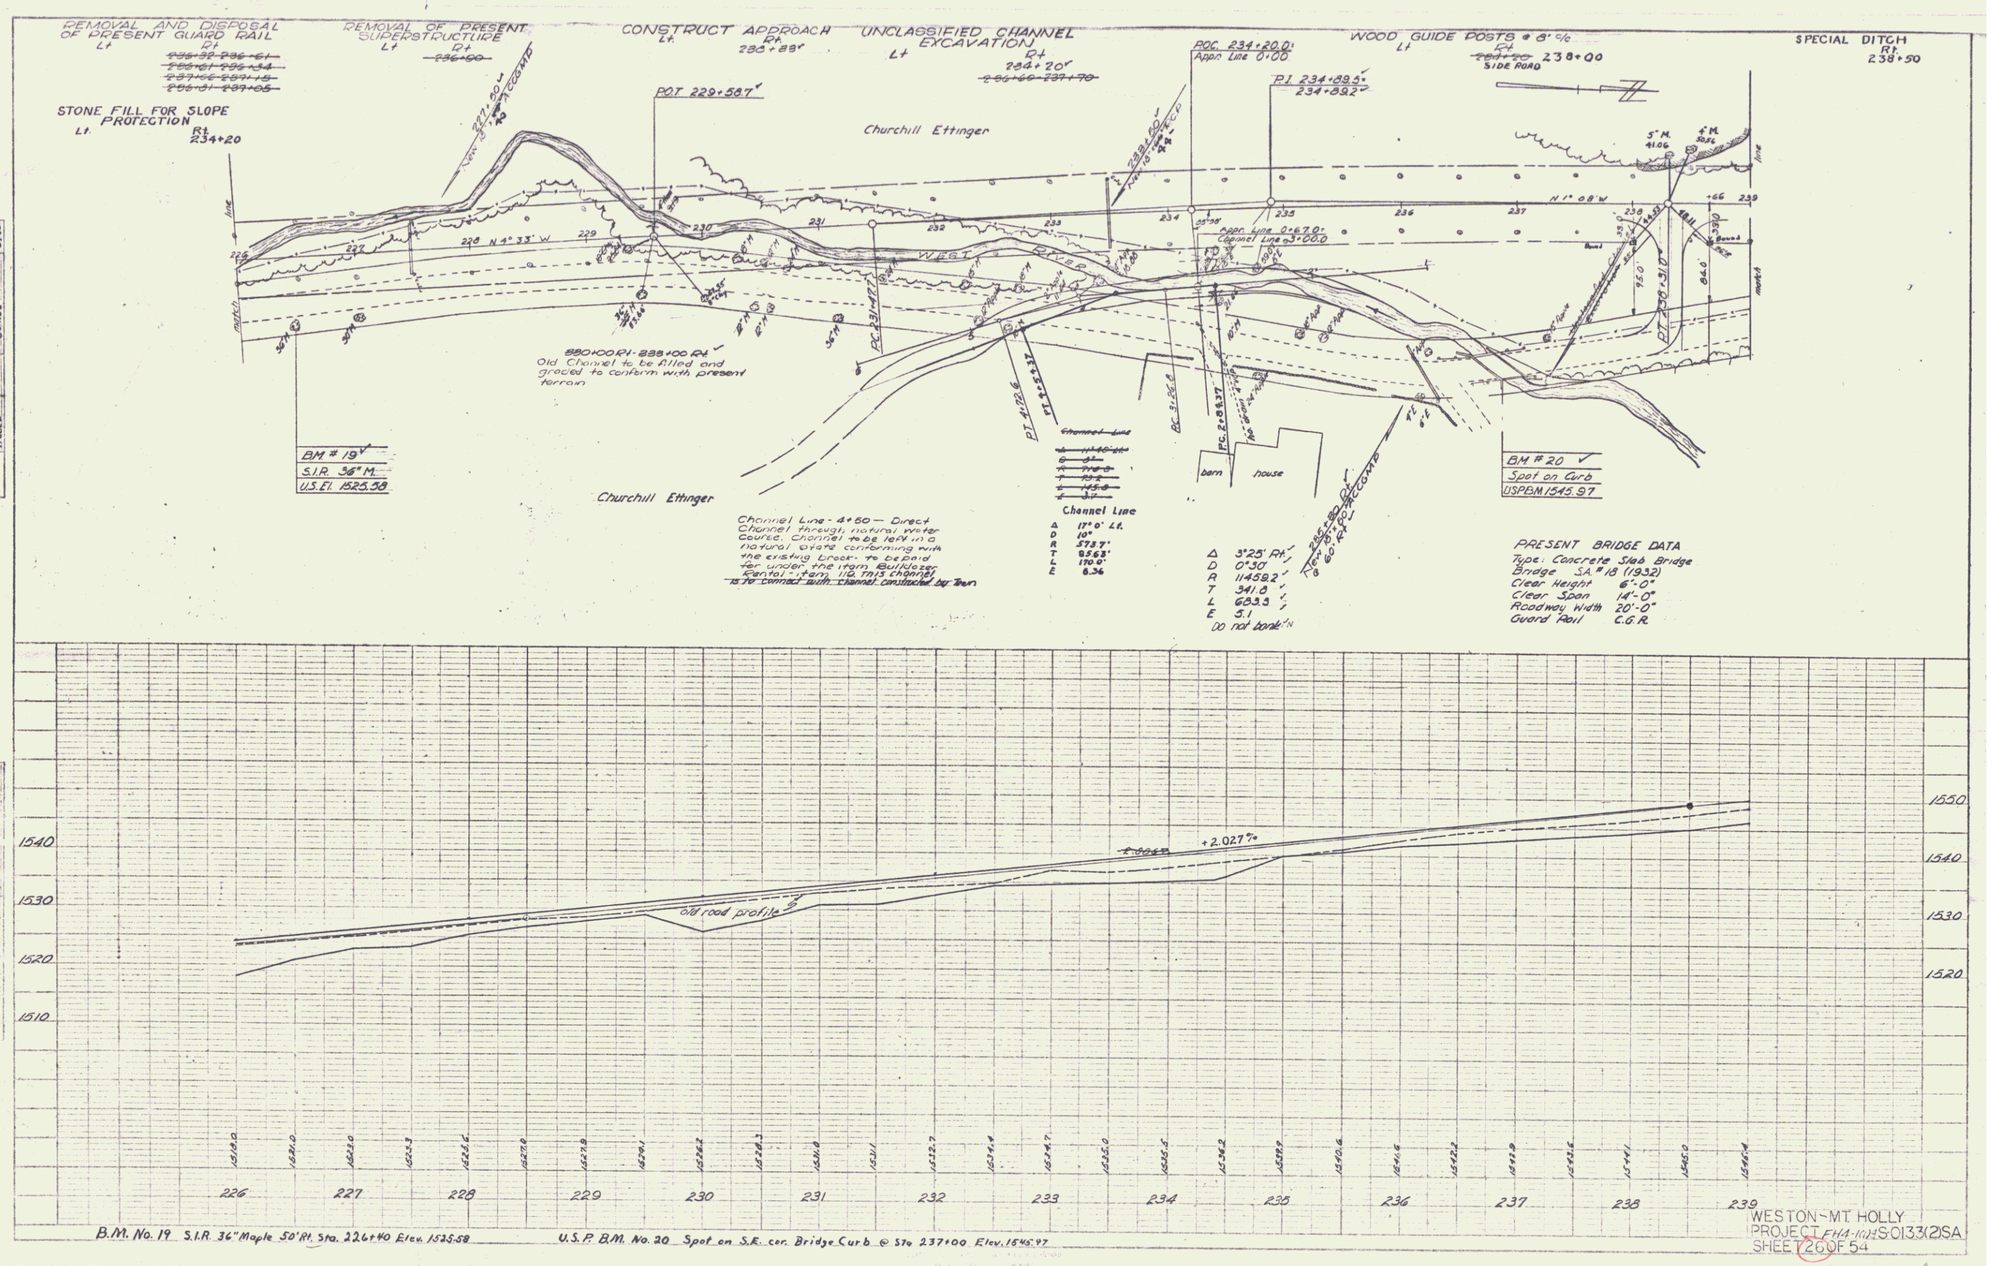

B.M. No. 19 S.I.R. 36" Maple 50' Rt. Sta. 226+40 Elev. 1525.58

U.S.P. B.M. No. 20 Spot on S.E. cor. Bridge Curb @ Sta 237+00 Elev. 1545.97

WESTON - MT. HOLLY
PROJECT FHA-16(1) S0133(2)SA
SHEET 26 OF 54

6