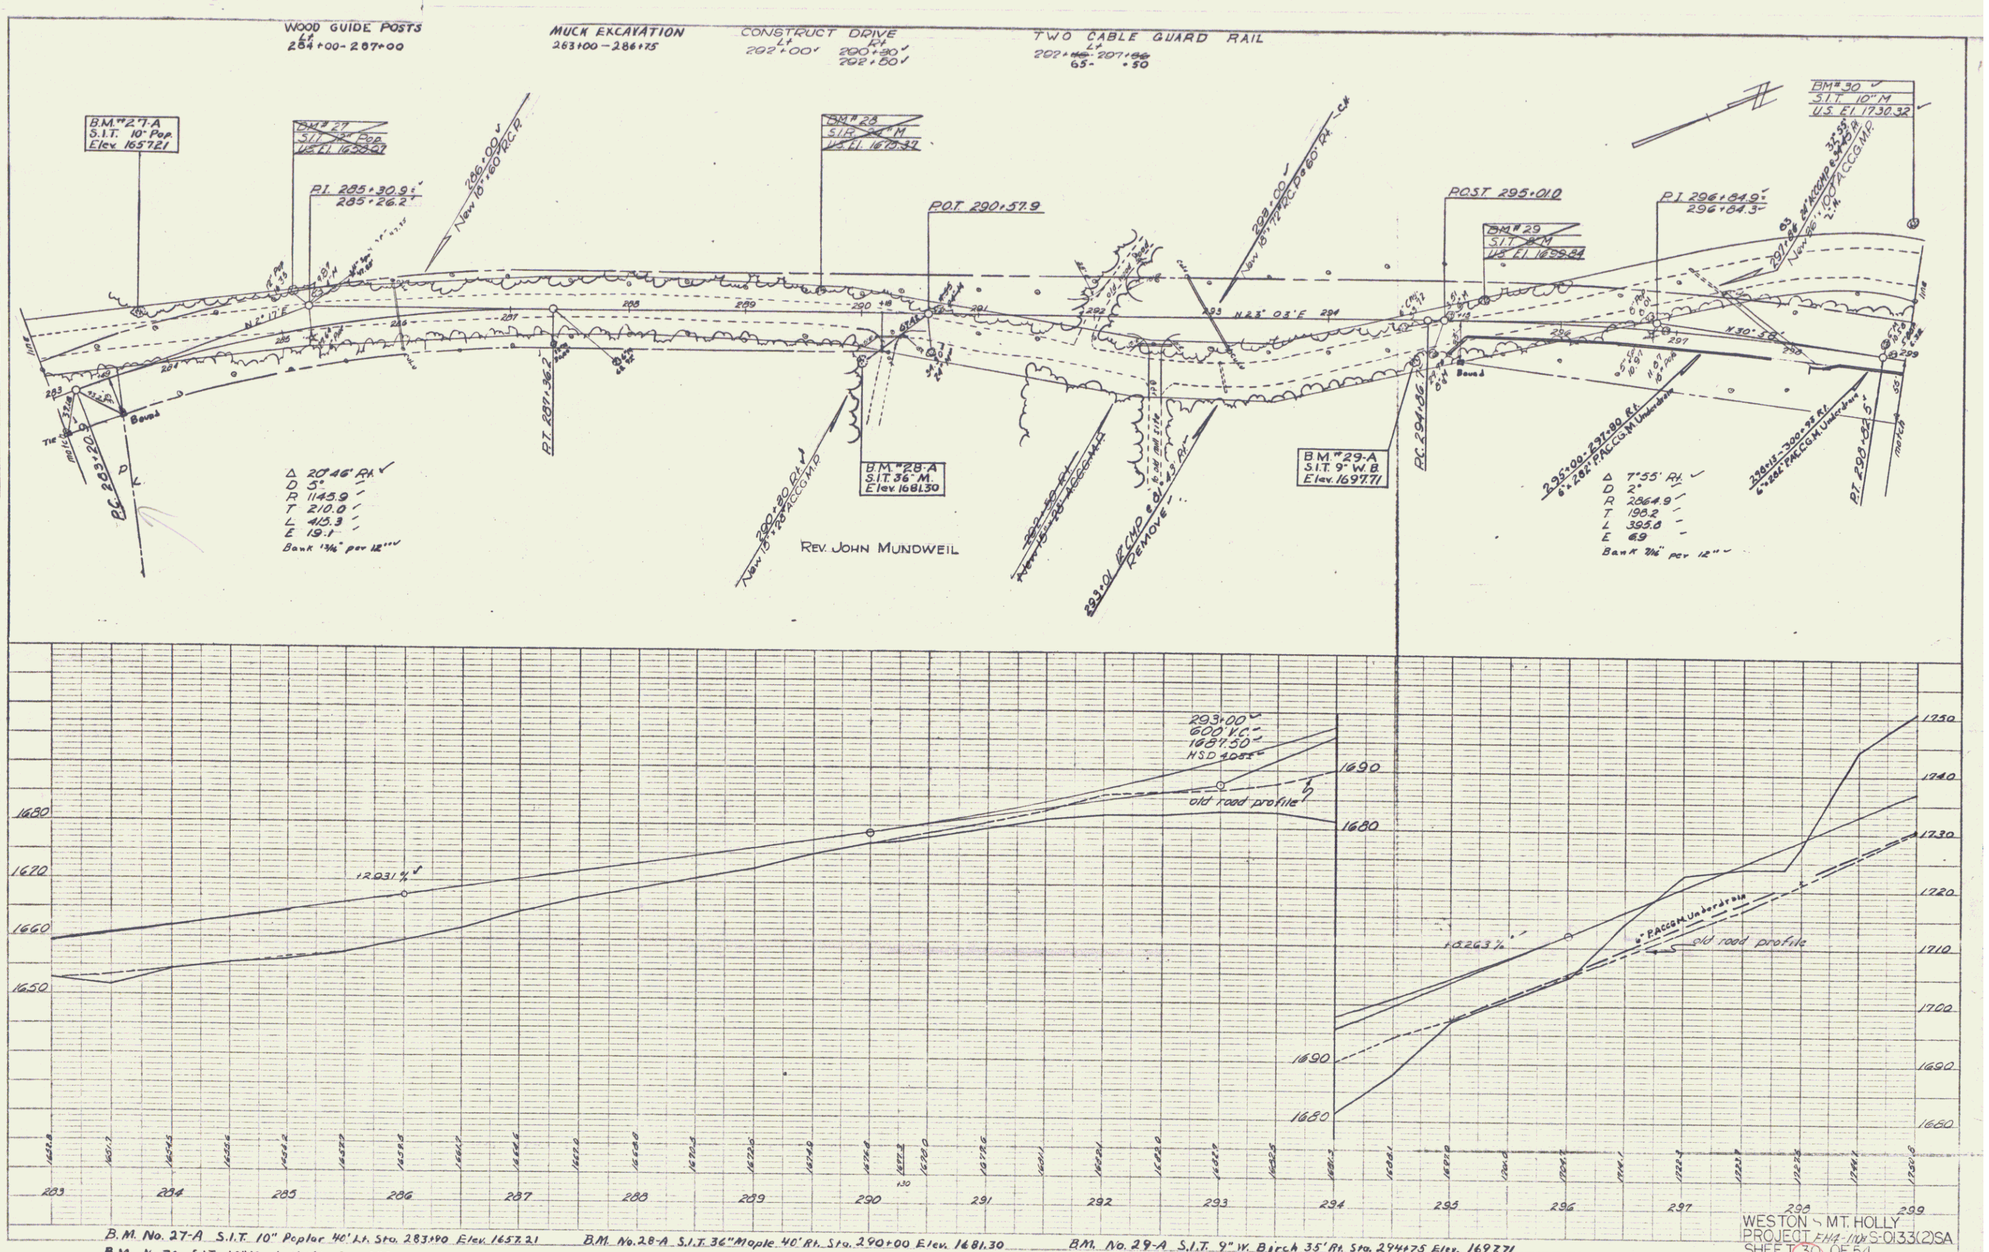

B.M. No. 27-A S.I.T. 10" Poplar 40' Lt. Sta. 283+90 Elev. 1657.21 B.M. No. 28-A S.I.T. 36" Maple 40' Rt. Sta. 290+00 Elev. 1681.30 B.M. No. 29-A S.I.T. 9" W. Birch 35' Rt. Sta. 294+75 Elev. 1697.71

B.M. No. 30 S.I.T. 10" Maple 110' Lt. Sta. 299+00 Elev. 1730.32.

WESTON & MT. HOLLY
PROJECT FAP-1(17) S-0133(2)SA
SHEET 30 OF 54

10