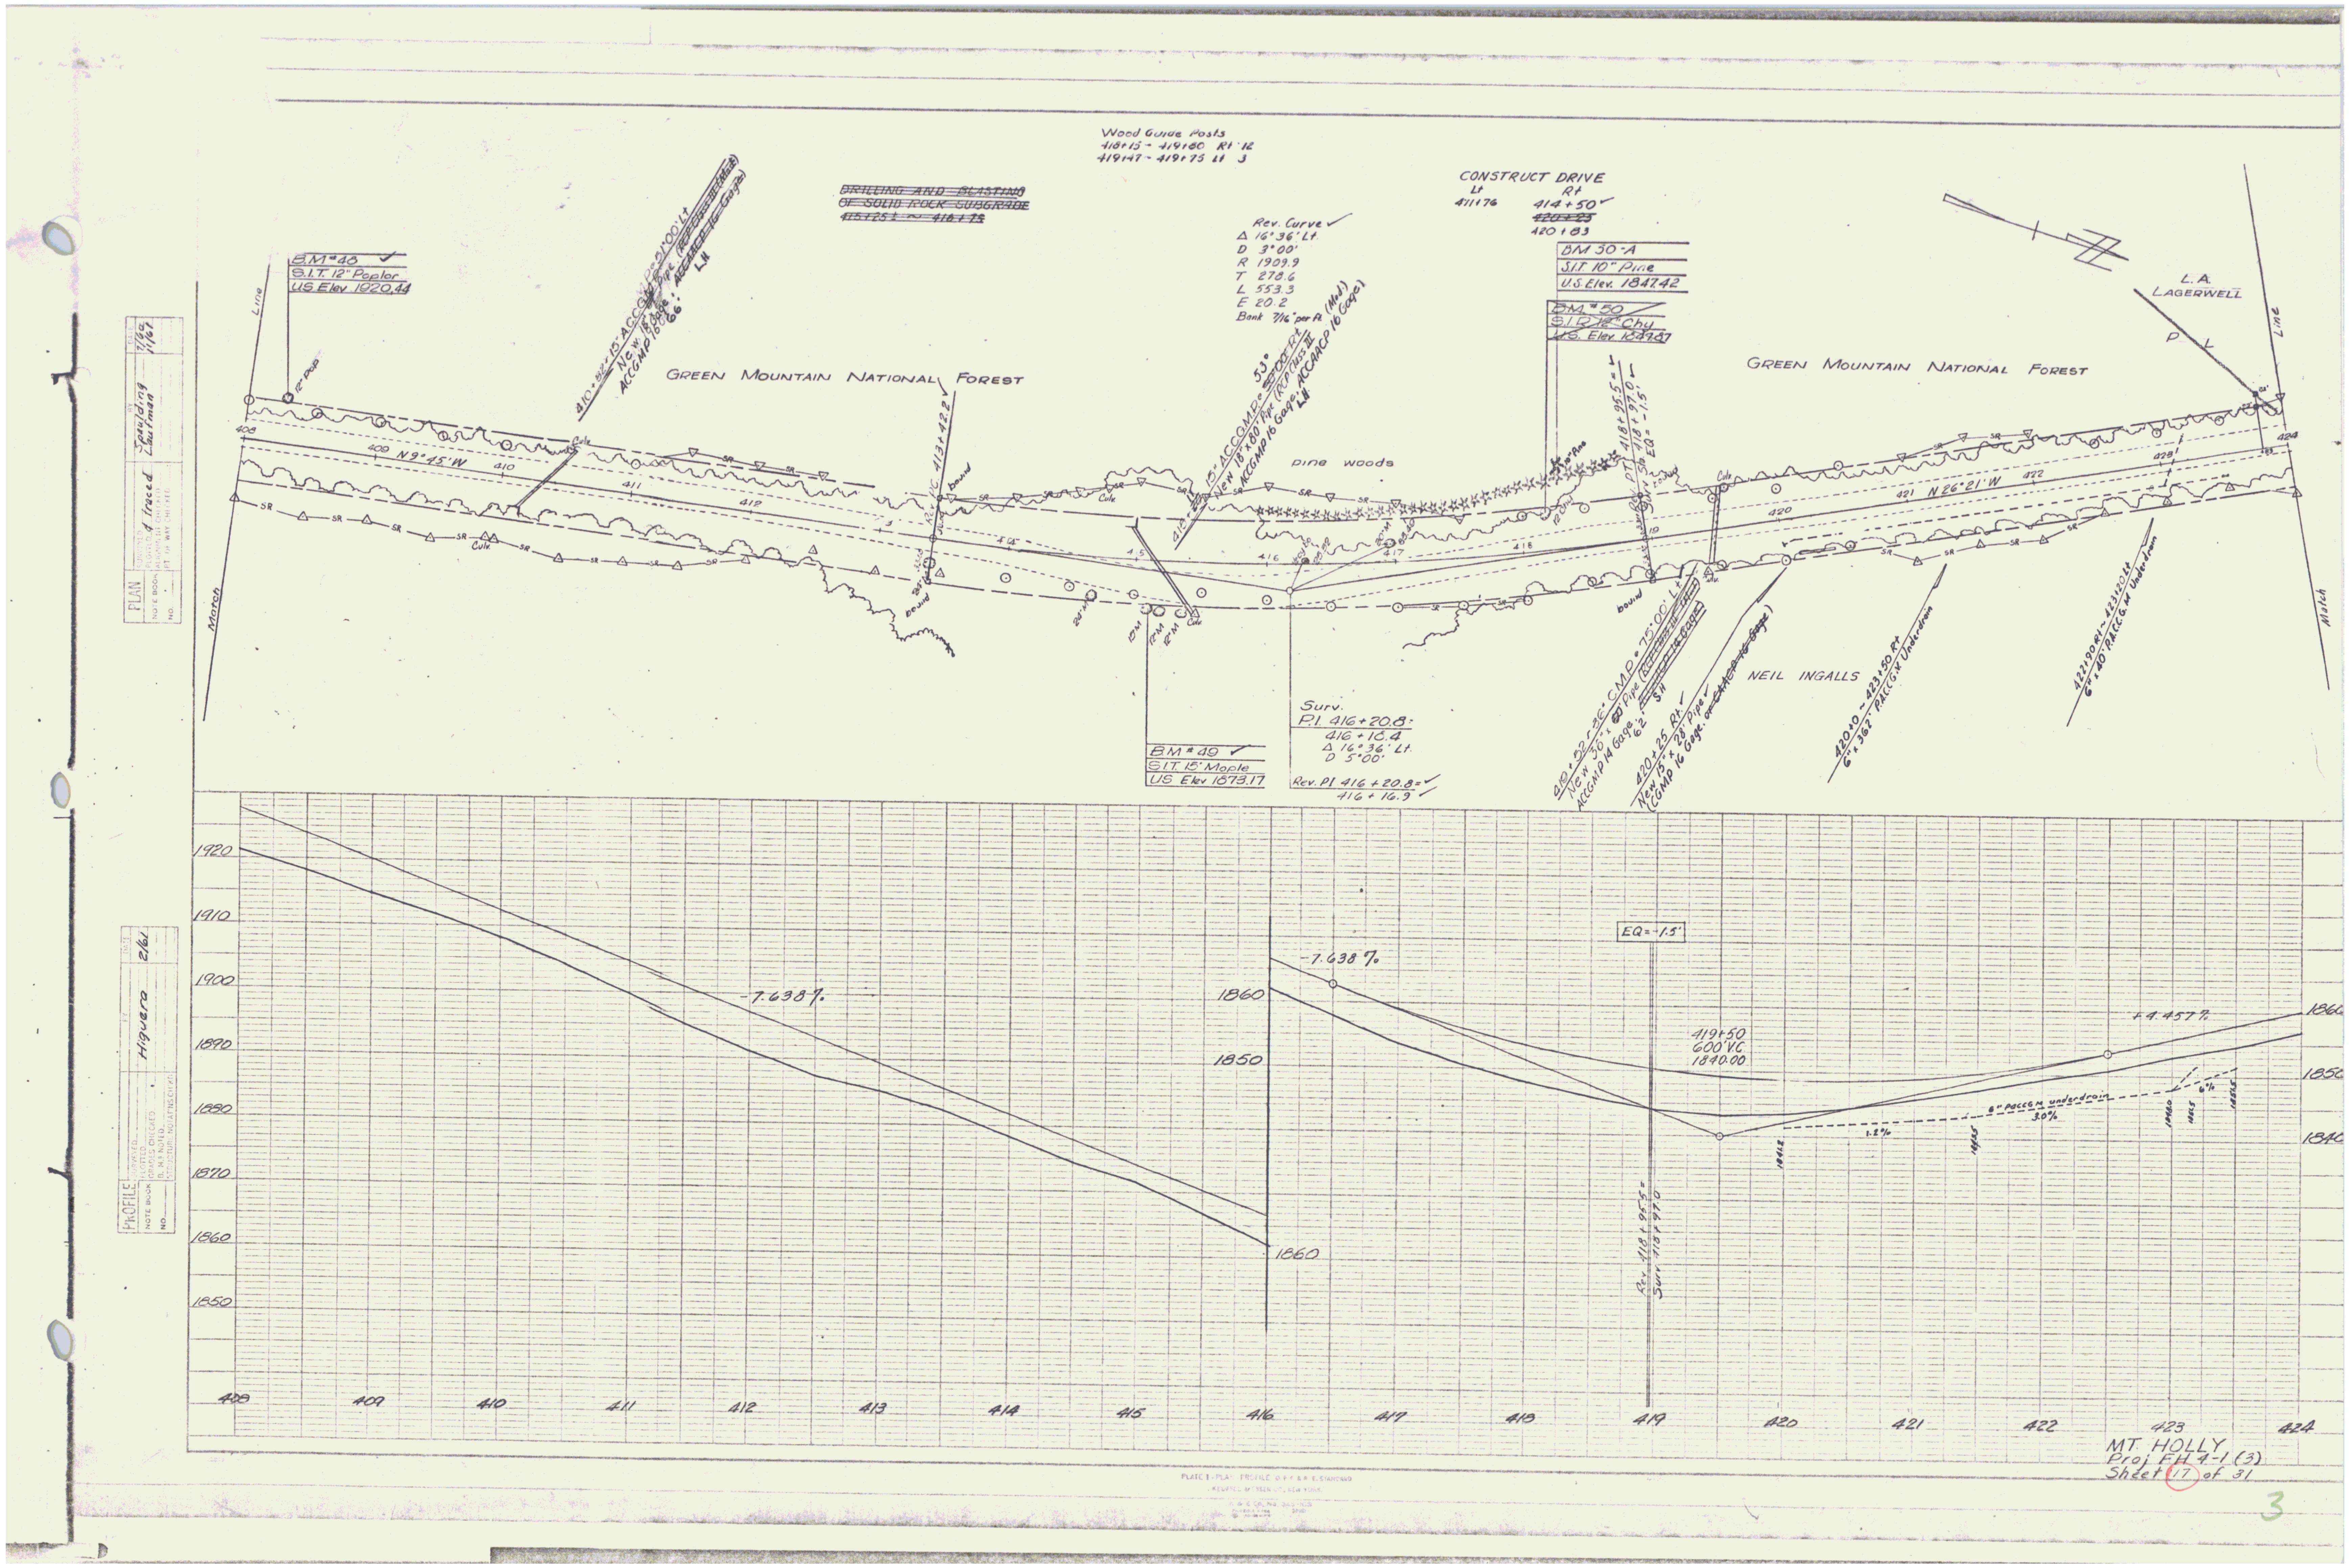

Wood Curve Posts
418+15 - 414+80 Rt 16
419+47 - 419+75 Lt 3
DRILLING AND BLASTING OF SOLID ROCK SUBGRADE
CONSTRUCT DRIVE
BM #46
S.I.T. 12" Poplar
US Elev 1920.44
Rev. Curve
Δ 16°36' Lt
D 5°00'
R 1909.9
T 278.6
L 553.3
E 20.2
BM 30-A
S.I.T. 10" Pine
U.S. Elev 1847.42
L.A. LAGERWELL
GREEN MOUNTAIN NATIONAL FOREST
GREEN MOUNTAIN NATIONAL FOREST
pine woods
N 9°45' W
N 26°21' W
NEIL INGALLS
Surv.
P.I. 416+20.8
416+16.4
Δ 16°36' Lt
D 5°00'
Rev. P.I. 416+20.8
416+16.9
BM #49
S.I.T. 15" Maple
US Elev 1878.17
Match Line
Match Line
-7.638%
-7.638%
EQ = -1.5'
419+50
600' VC
1840.00
+4.457%
1920
1910
1900
1890
1880
1870
1860
1850
1860
1850
1860
408
409
410
411
412
413
414
415
416
417
418
419
420
421
422
423
424
PLAN
PROFILE
Higuera
MT HOLLY
Proj FH 4-1 (3)
Sheet 17 of 31
3