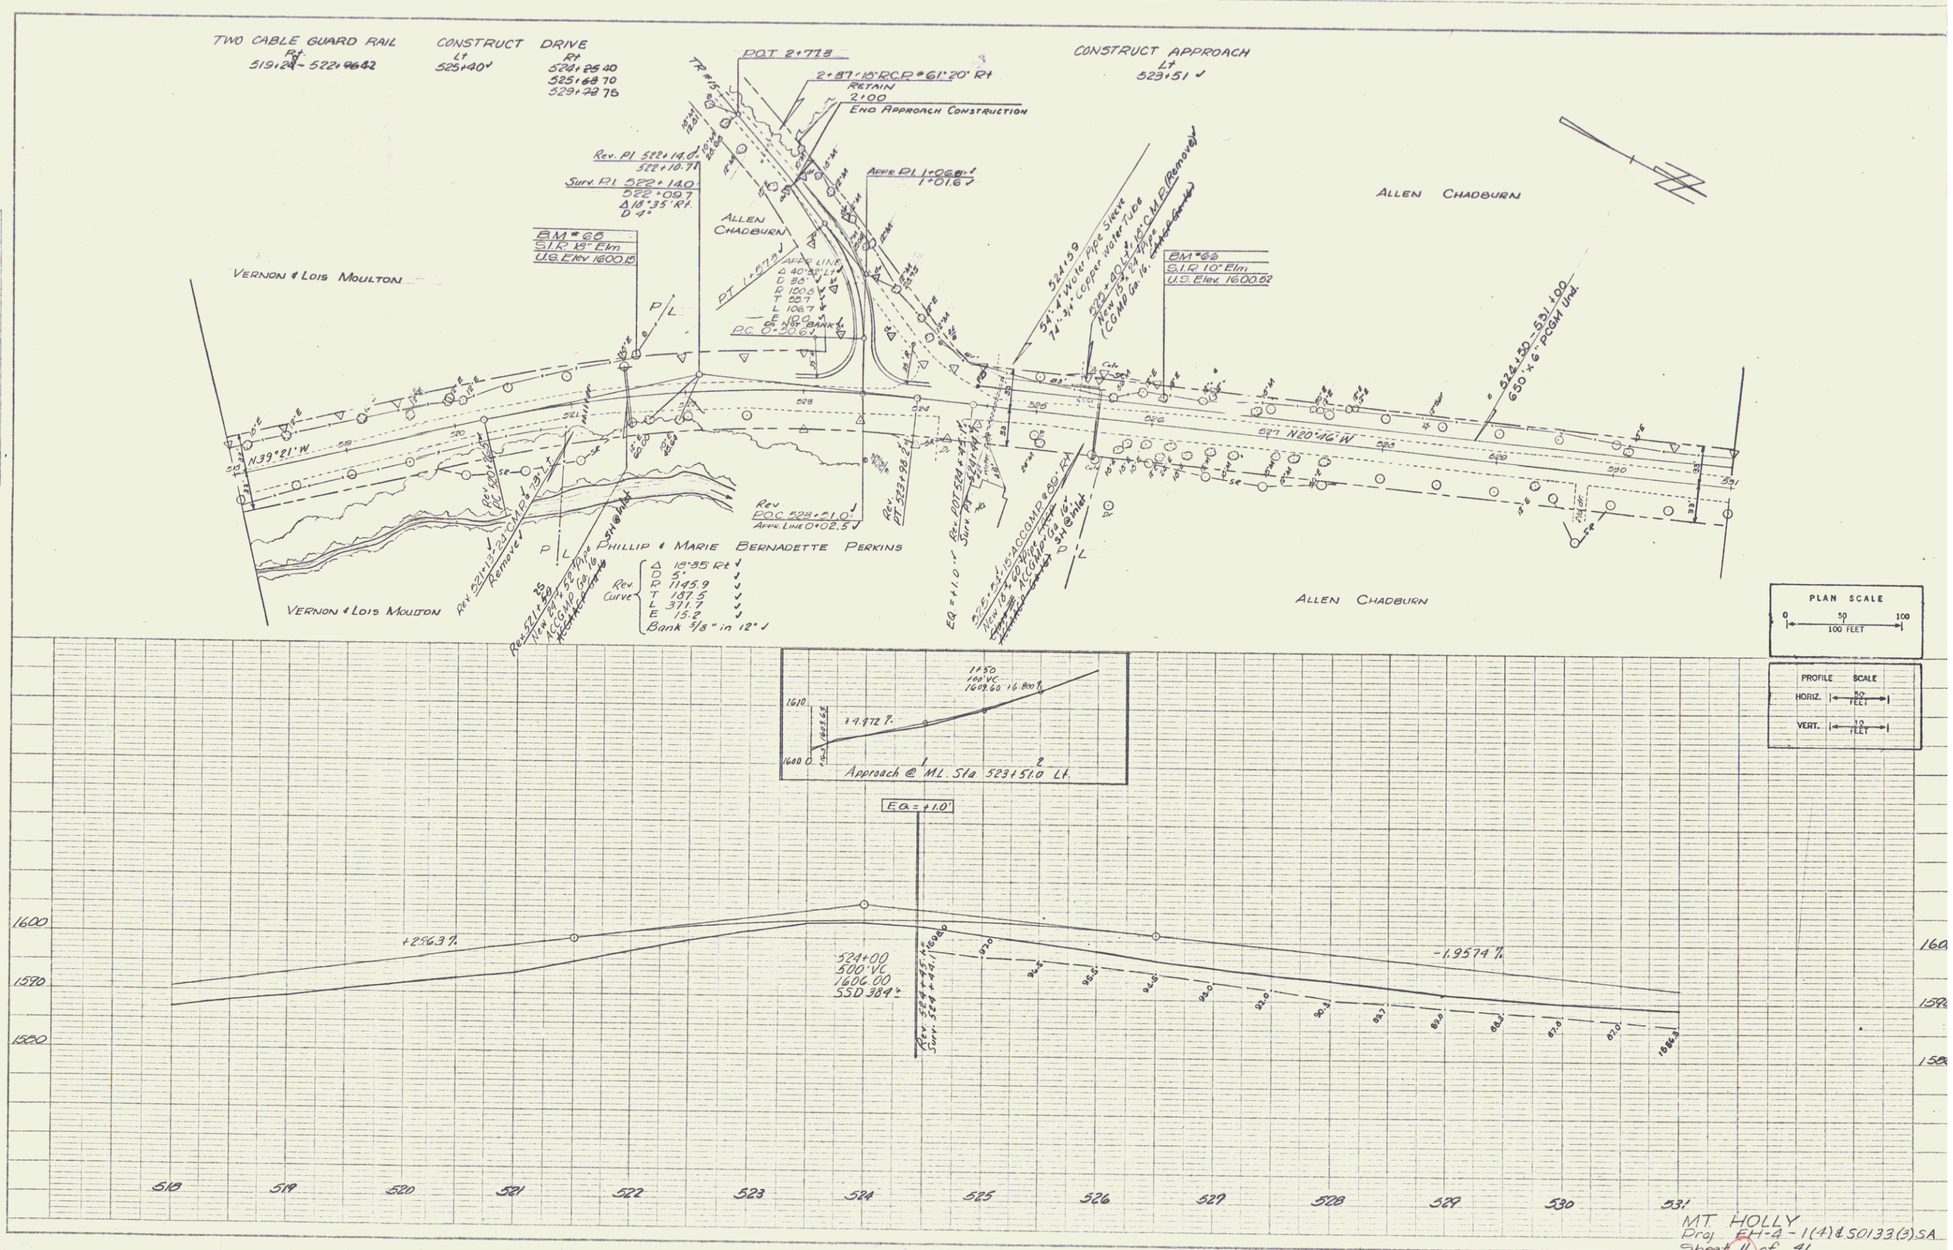

MT. HOLLY
Proj. BH-A-1(4) & 50133(3) SA
Sheet 11 of 41

6