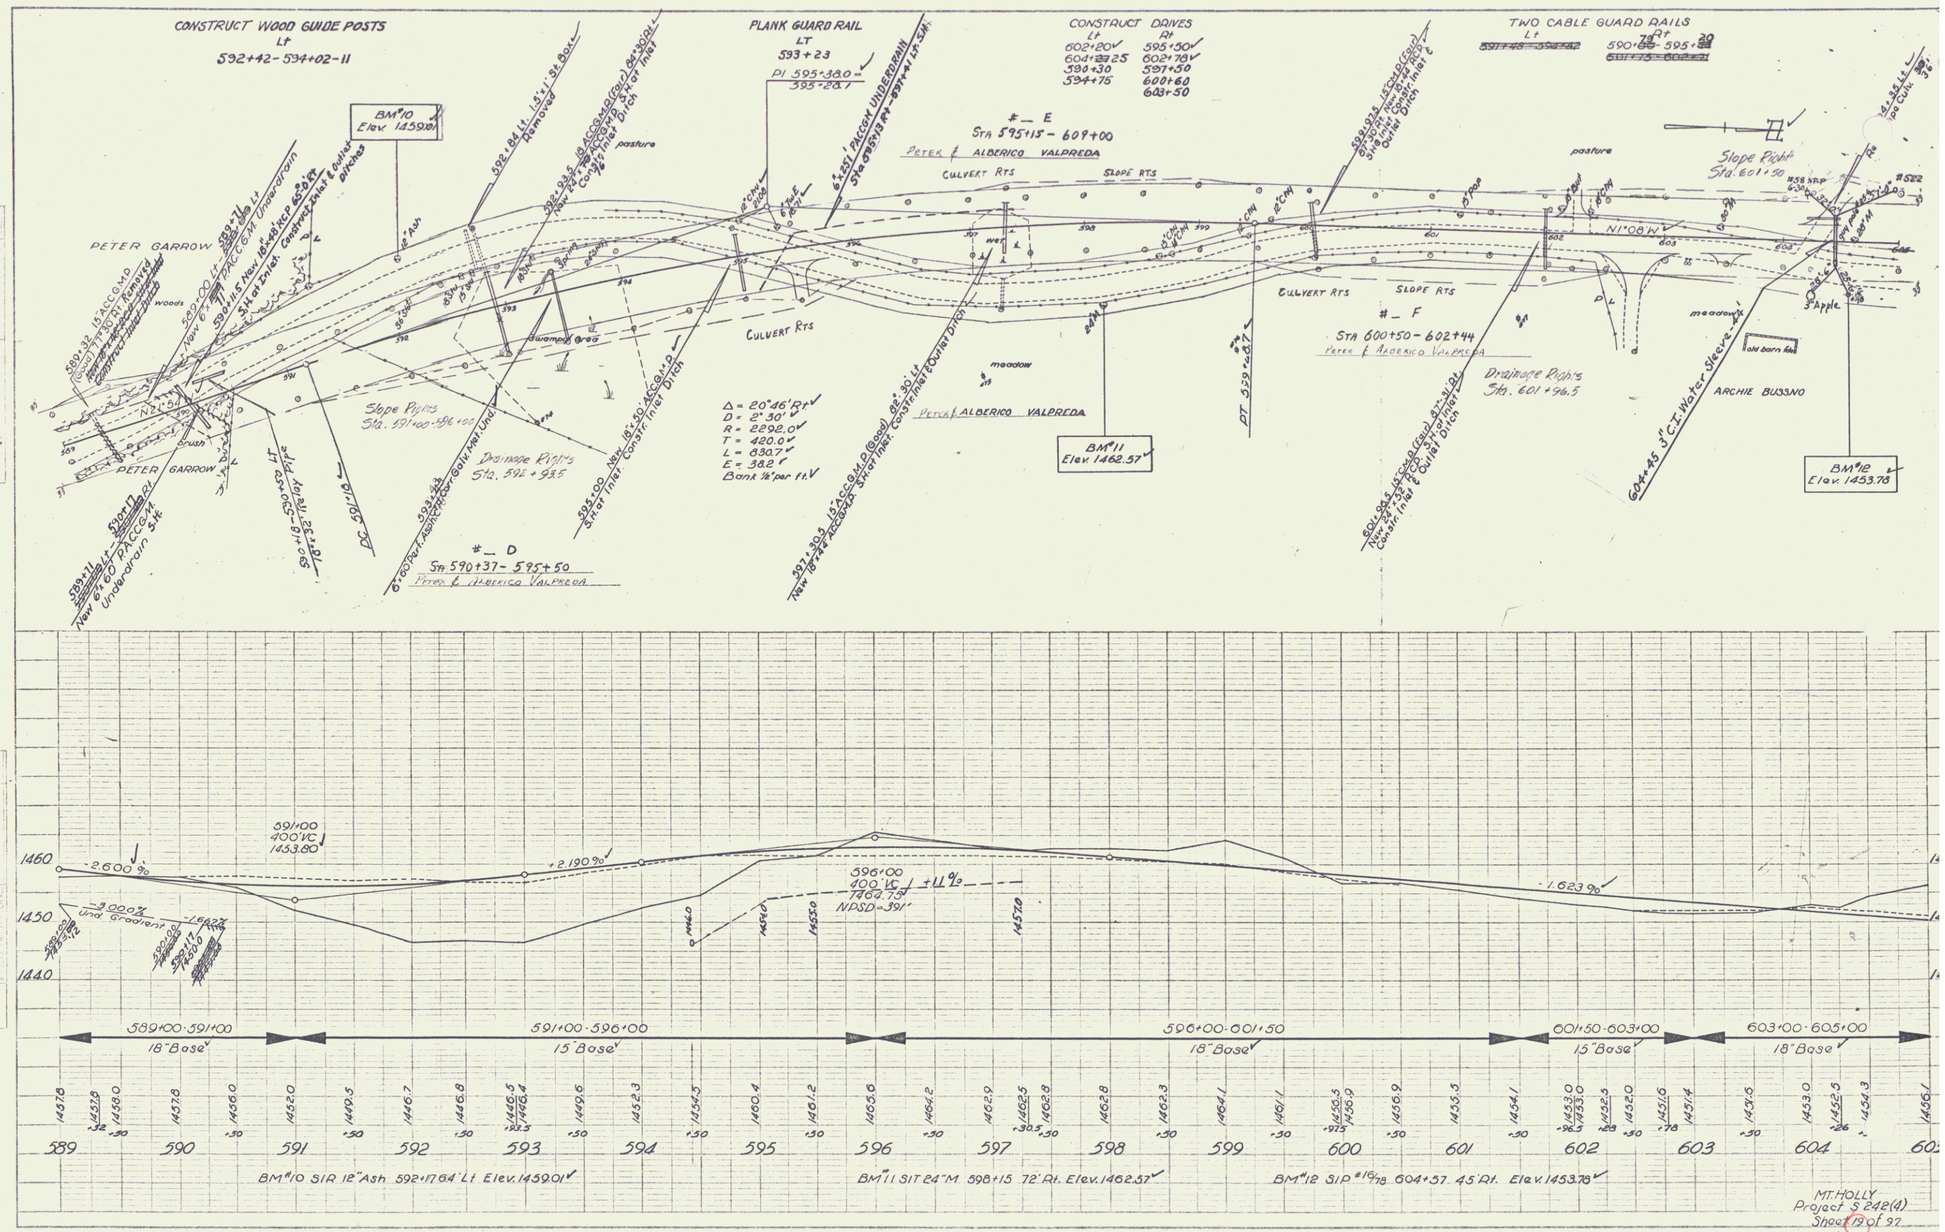

MT. HOLLY
Project S 242(4)
Sheet 19 of 92

6