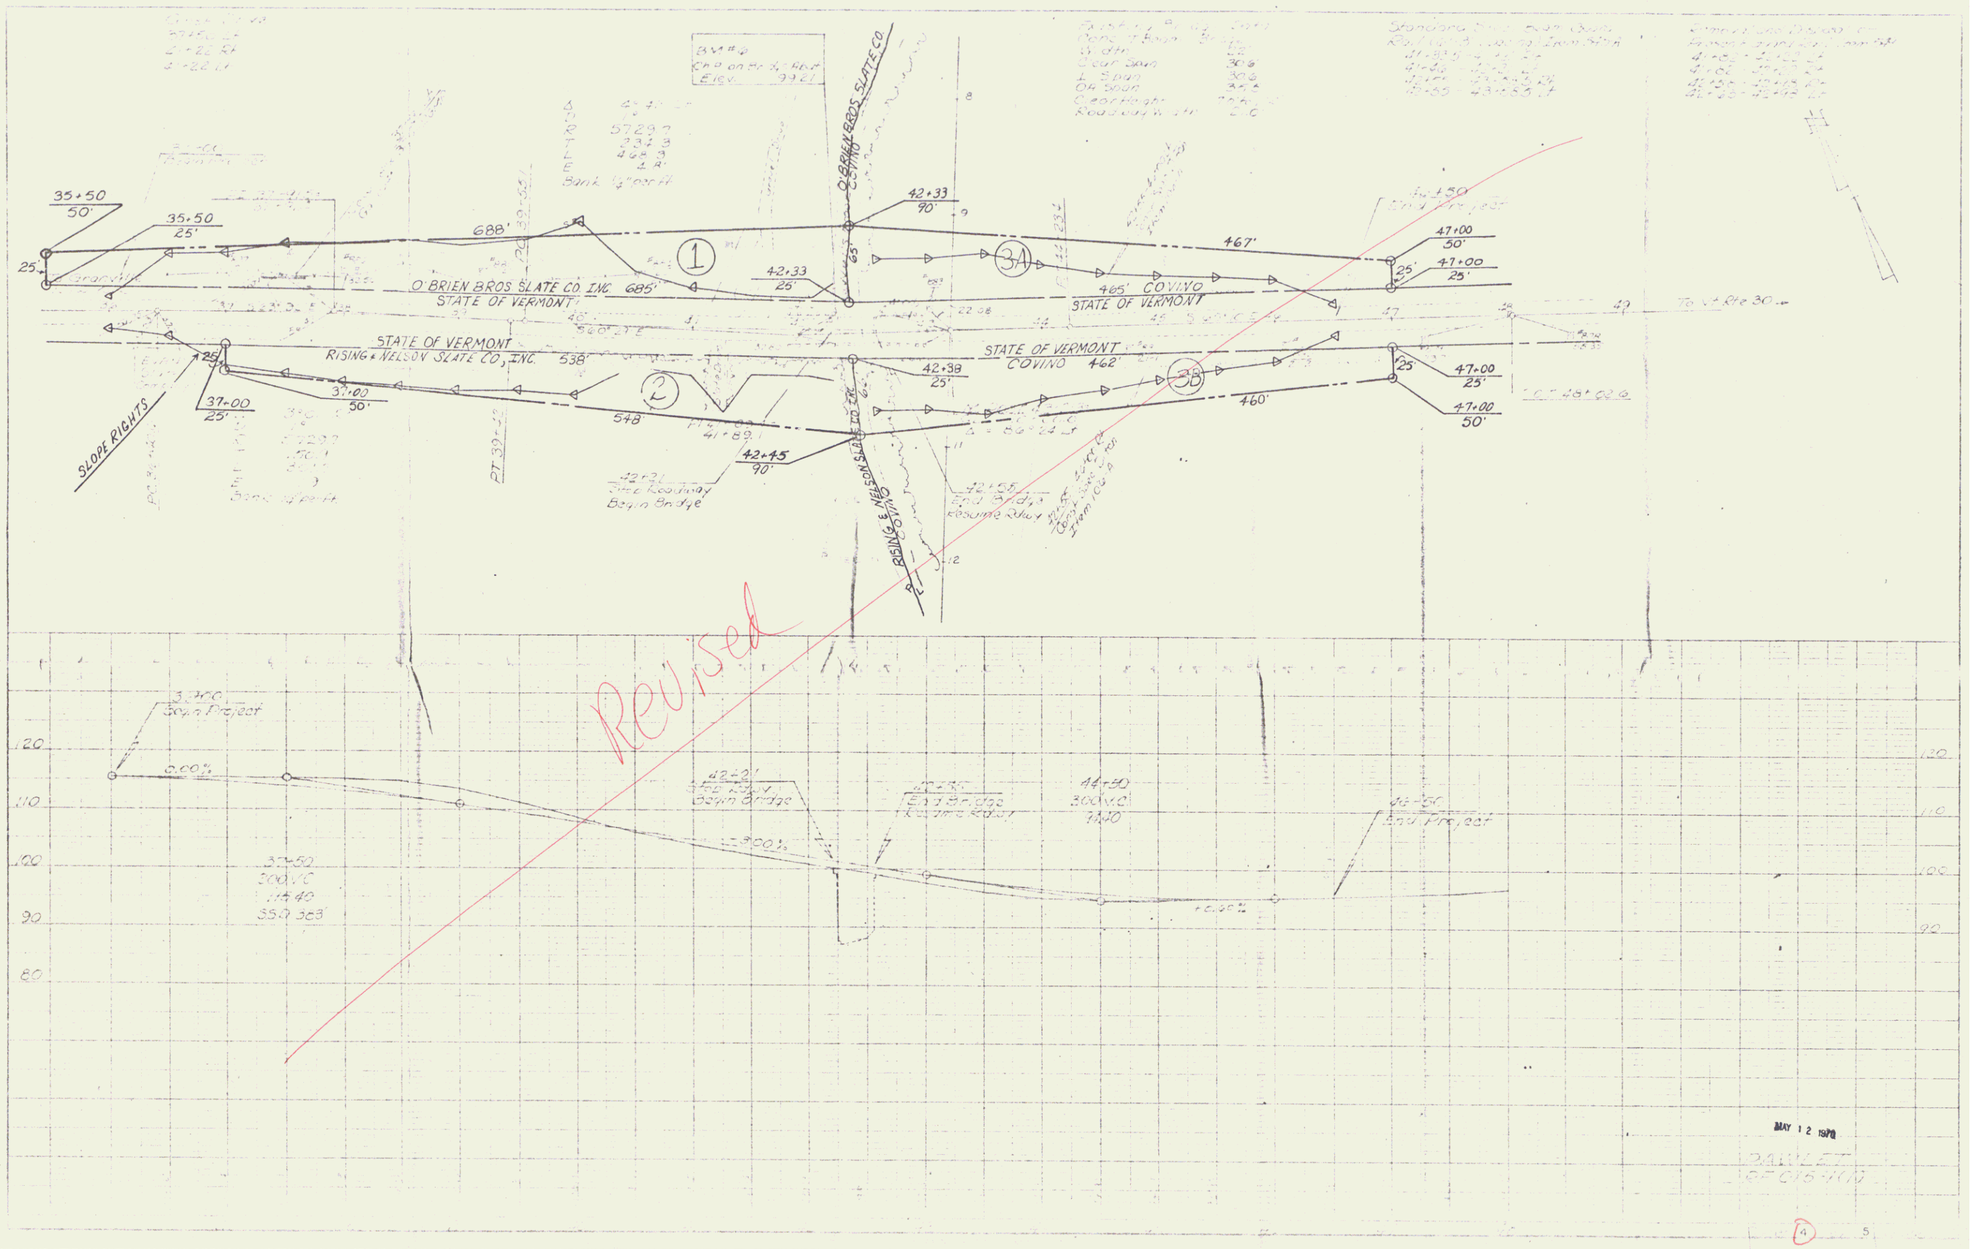
35+50
50'
35+50
25'
688'
1
42+33
90'
42+33
25'
O'BRIEN BROS SLATE CO INC 685'
STATE OF VERMONT
O'BRIEN BROS SLATE CO
3A
465' COVINO
STATE OF VERMONT
467'
47+00
50'
47+00
25'
STATE OF VERMONT
RISING & NELSON SLATE CO, INC. 538'
2
548
37+00
25'
37+00
50'
SLOPE RIGHTS
42+38
25'
STATE OF VERMONT
COVINO 462'
3B
460'
47+00
25'
47+00
50'
42+45
90'
RISING & NELSON SLATE CO
Revised
3+00
Begin Project
0.00%
42+21
End Project
Begin Bridge
-3.00%
44+50
End Bridge
Resume Roadway
+0.00%
46+50
End Project
MAY 12 1980

3