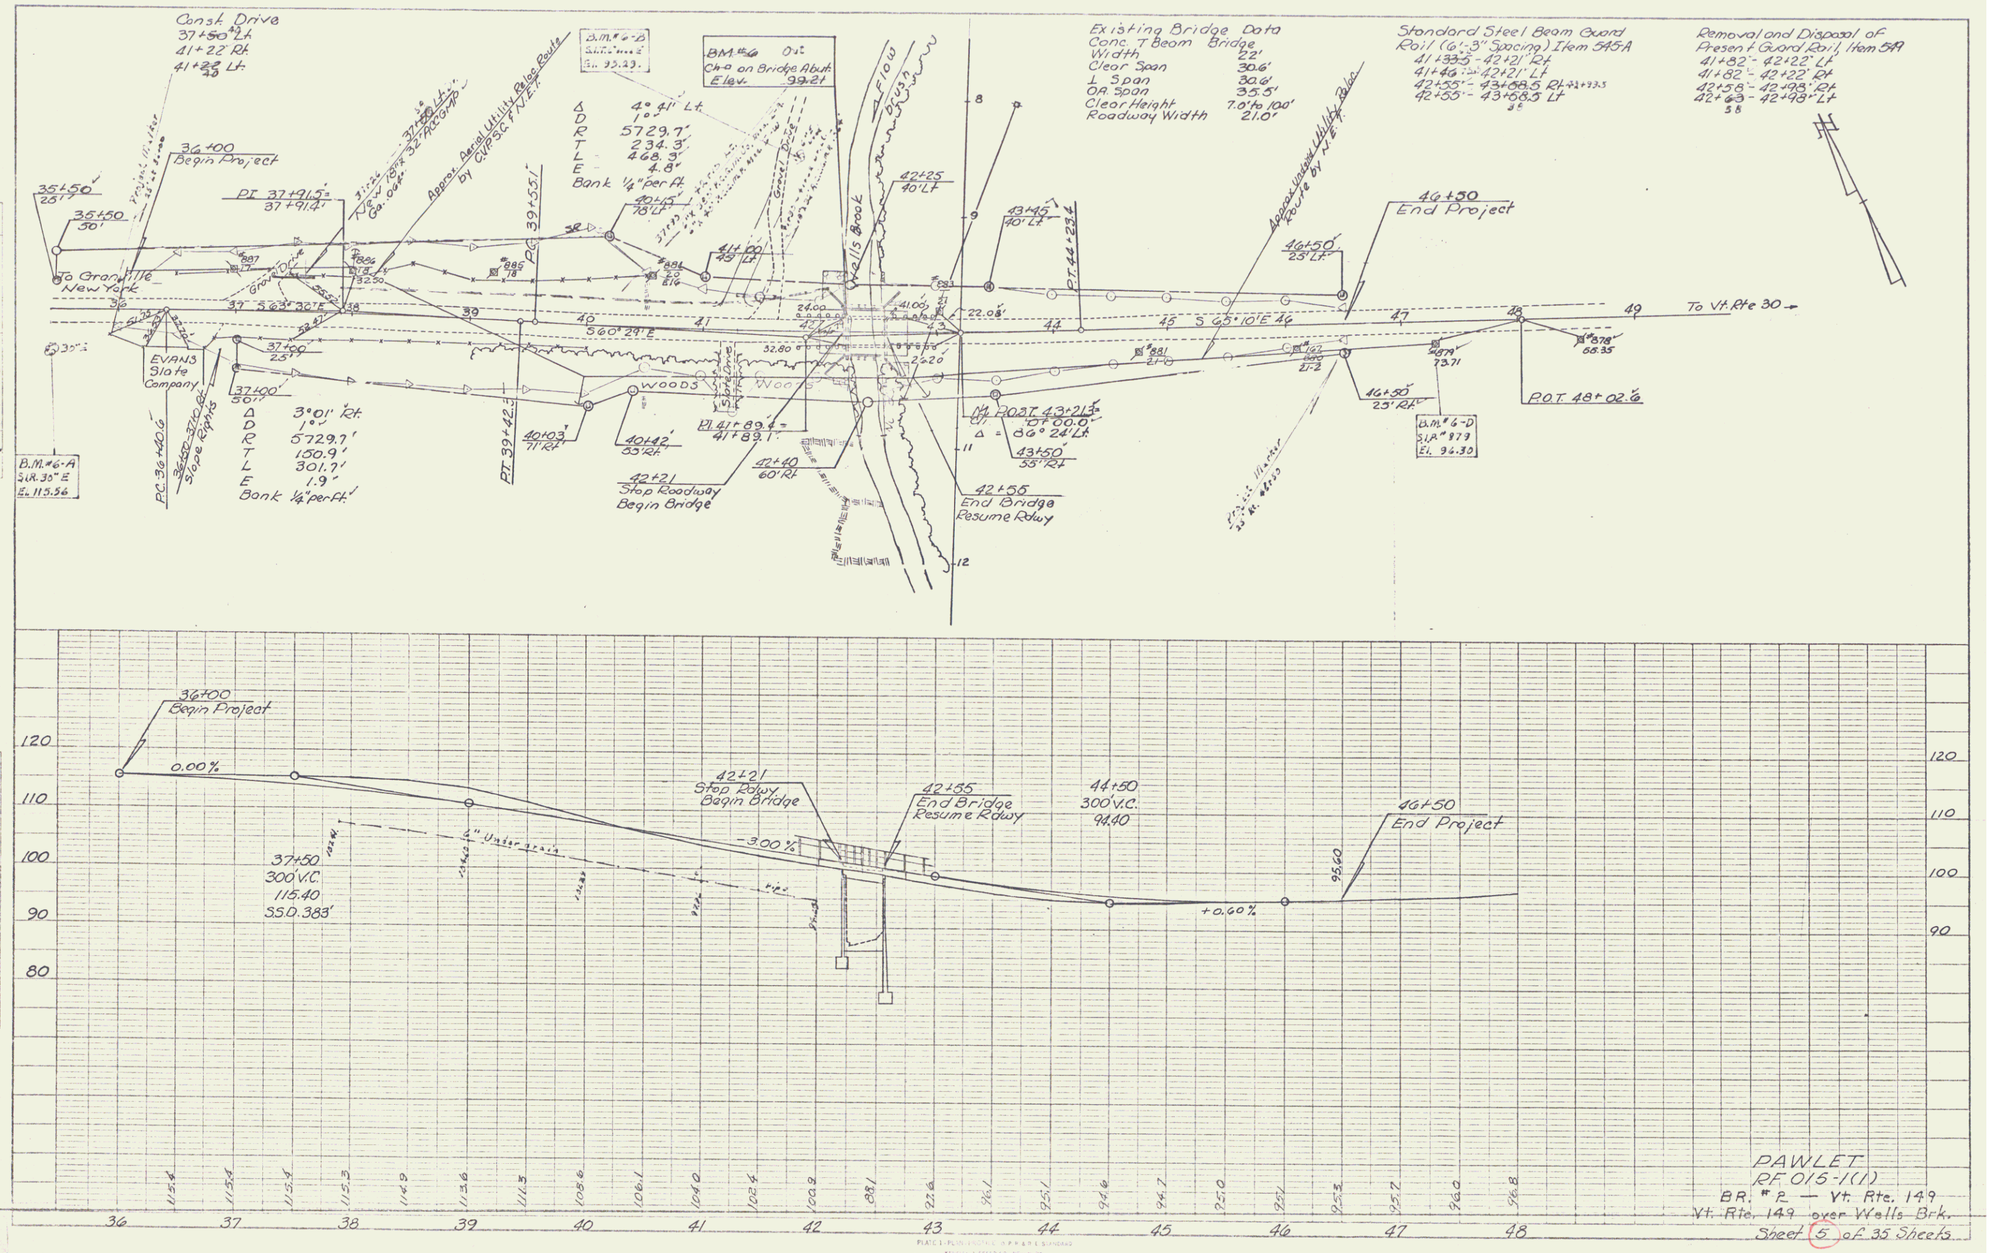

PAWLET
RF 015-1(1)
BR. #2 — Vt. Rte. 149
Vt. Rte. 149 over Wells Brk.
Sheet 5 of 35 Sheets

5