FED. ROAD DIST. NO.	STATE	N.R.S. PROJ. NO.	FISCAL YEAR	SHEET NO.	TOTAL SHEETS
9	VT.	154	1933	1	29

INDEX OF SHEETS

SHEET NO. 1 TITLE PAGE
" " 2 TYPICAL CROSS-SECTION OF IMPROVEMENT } BITUMINOUS MACADAM SURFACE COURSE
" " 3 BANKING AND WIDENING TABLES
" 4-9 PLAN AND PROFILE SHEETS
" " 10 STANDARD STRUCTURE SHEET S-28 PIPE CULVERTS
" " 11 " " " S-30 GUARD RAIL
" " 12 BARRICADES, SIGNS AND LIGHTS SB-11
" 13-29 CROSS SECTIONS

STANDARD SHEETS S-28 SUBMITTED TO THE CHIEF ENGINEER ON MAY 16, 1933.
STANDARD SHEET S-30 SUBMITTED TO THE CHIEF ENGINEER ON AUG. 15, 1933.

STATE OF VERMONT
STATE HIGHWAY DEPARTMENT

PLAN AND PROFILE OF PROPOSED STATE HIGHWAY

NATIONAL RECOVERY SECONDARY PROJECT

TOWN OF PAWLET

GRANVILLE - PAWLET ROAD

FROM THE NEW YORK - VERMONT STATE BOUNDARY LINE EASTERLY 1.311 MILES TO A POINT 100 FT. NORTH OF THE INTERSECTION WITH PAWLET-WELLS ROAD

LENGTH OF PROJECT = 6922.2 FT. = 1.311 MILES

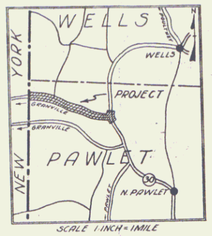

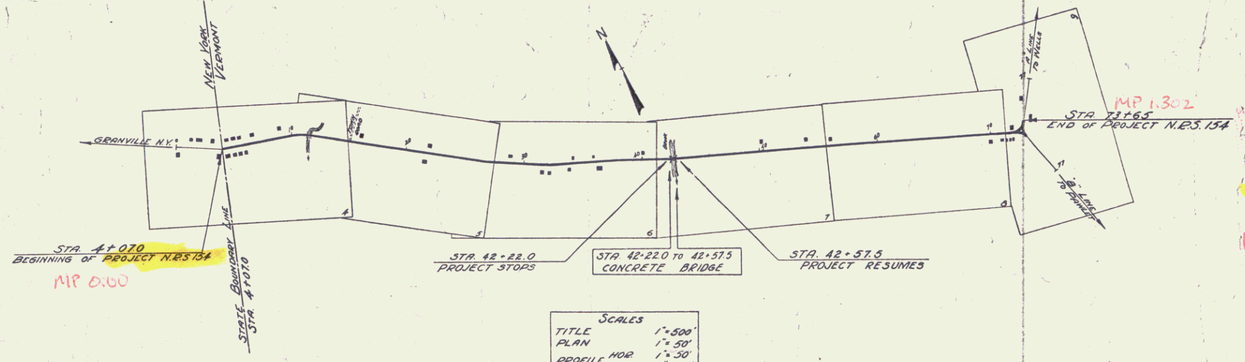

SCALES	
TITLE	1" = 500'
PLAN	1" = 50'
PROFILE HOR.	1" = 50'
PROFILE VERT.	1" = 10'
CROSS SECTIONS	1" = 5'

RIGHT-OF-WAY DIVISION
TOWN FILE
PERPETUAL
Town of U149
(To Be Returned To R.O.W. Division)

APPROVED: September 22, 1933
H. E. Vaugeot,
COMMISSIONER OF HIGHWAYS
SUBMITTED BY ORDER OF THE STATE HIGHWAY BOARD

Pin#992624

RECOMMENDED
DISTRICT ENGINEER — BUREAU OF PUBLIC ROADS
RECOMMENDED FOR APPROVAL
CHIEF ENGINEER — BUREAU OF PUBLIC ROADS
APPROVED
DIRECTOR, BUREAU OF PUBLIC ROADS

THESE PLANS ARE SUBJECT TO SUCH REVISIONS AS MAY BE REQUIRED BY THE BUREAU OF PUBLIC ROADS OR THE COMMISSIONER OF HIGHWAYS.
CONSTRUCTION IS TO BE CARRIED ON IN ACCORDANCE WITH THE STANDARD ROAD AND BRIDGE SPECIFICATIONS OF 1930 WITH ALL SUBSEQUENT APPROVED REVISIONS AND SUCH SPECIFICATIONS AND SPECIAL PROVISIONS AS ARE SUBMITTED WITH THE PLANS.

CONVENTIONAL SIGNS

COUNTY LINE
TOWN LINE
FENCE LINE
STONE WALL
UNFENCED PROPERTY
GUARD RAIL
TRAVELED WAY
RAILROAD
RETAINING WALL
CENTER LINE
SURVEY LINE
CULVERT
DROP INLET
TROLLEY POLE
POWER POLE
TELEPHONE POLE
TREES
HEDGE

GROUND ELEVATION ..... DATUM ..... 1000 LINE
GRADE ELEVATION ..... DATUM ..... 1000 LINE

CURVE DATA

DEFLECTION ANGLE ..... Δ
DEGREE OF CURVE ..... D.
RADIUS OF CURVE ..... R.
TANGENT DISTANCE ..... T.
LENGTH OF CURVE ..... L.
EXTERNAL DISTANCE ..... E.
POINT OF INTERSECTION ..... P. I.
POINT OF CURVE ..... P. C.
POINT OF TANGENT ..... P. T.
POINT ON TANGENT ..... P.O.T.

APPROVED: Sept 22, 1933
ASSISTANT ROAD ENGINEER

SERIES N.R.S. NO. 154 FILED
SHEET 1 OF 29

DIST. #1 PLANS