FED. ROAD DIST. NO.	STATE	W.P.G.S. PROJ. NO.	FISCAL YEAR	SHEET NO.	TOTAL SHEETS
1	VT.	153B	1936	8	26

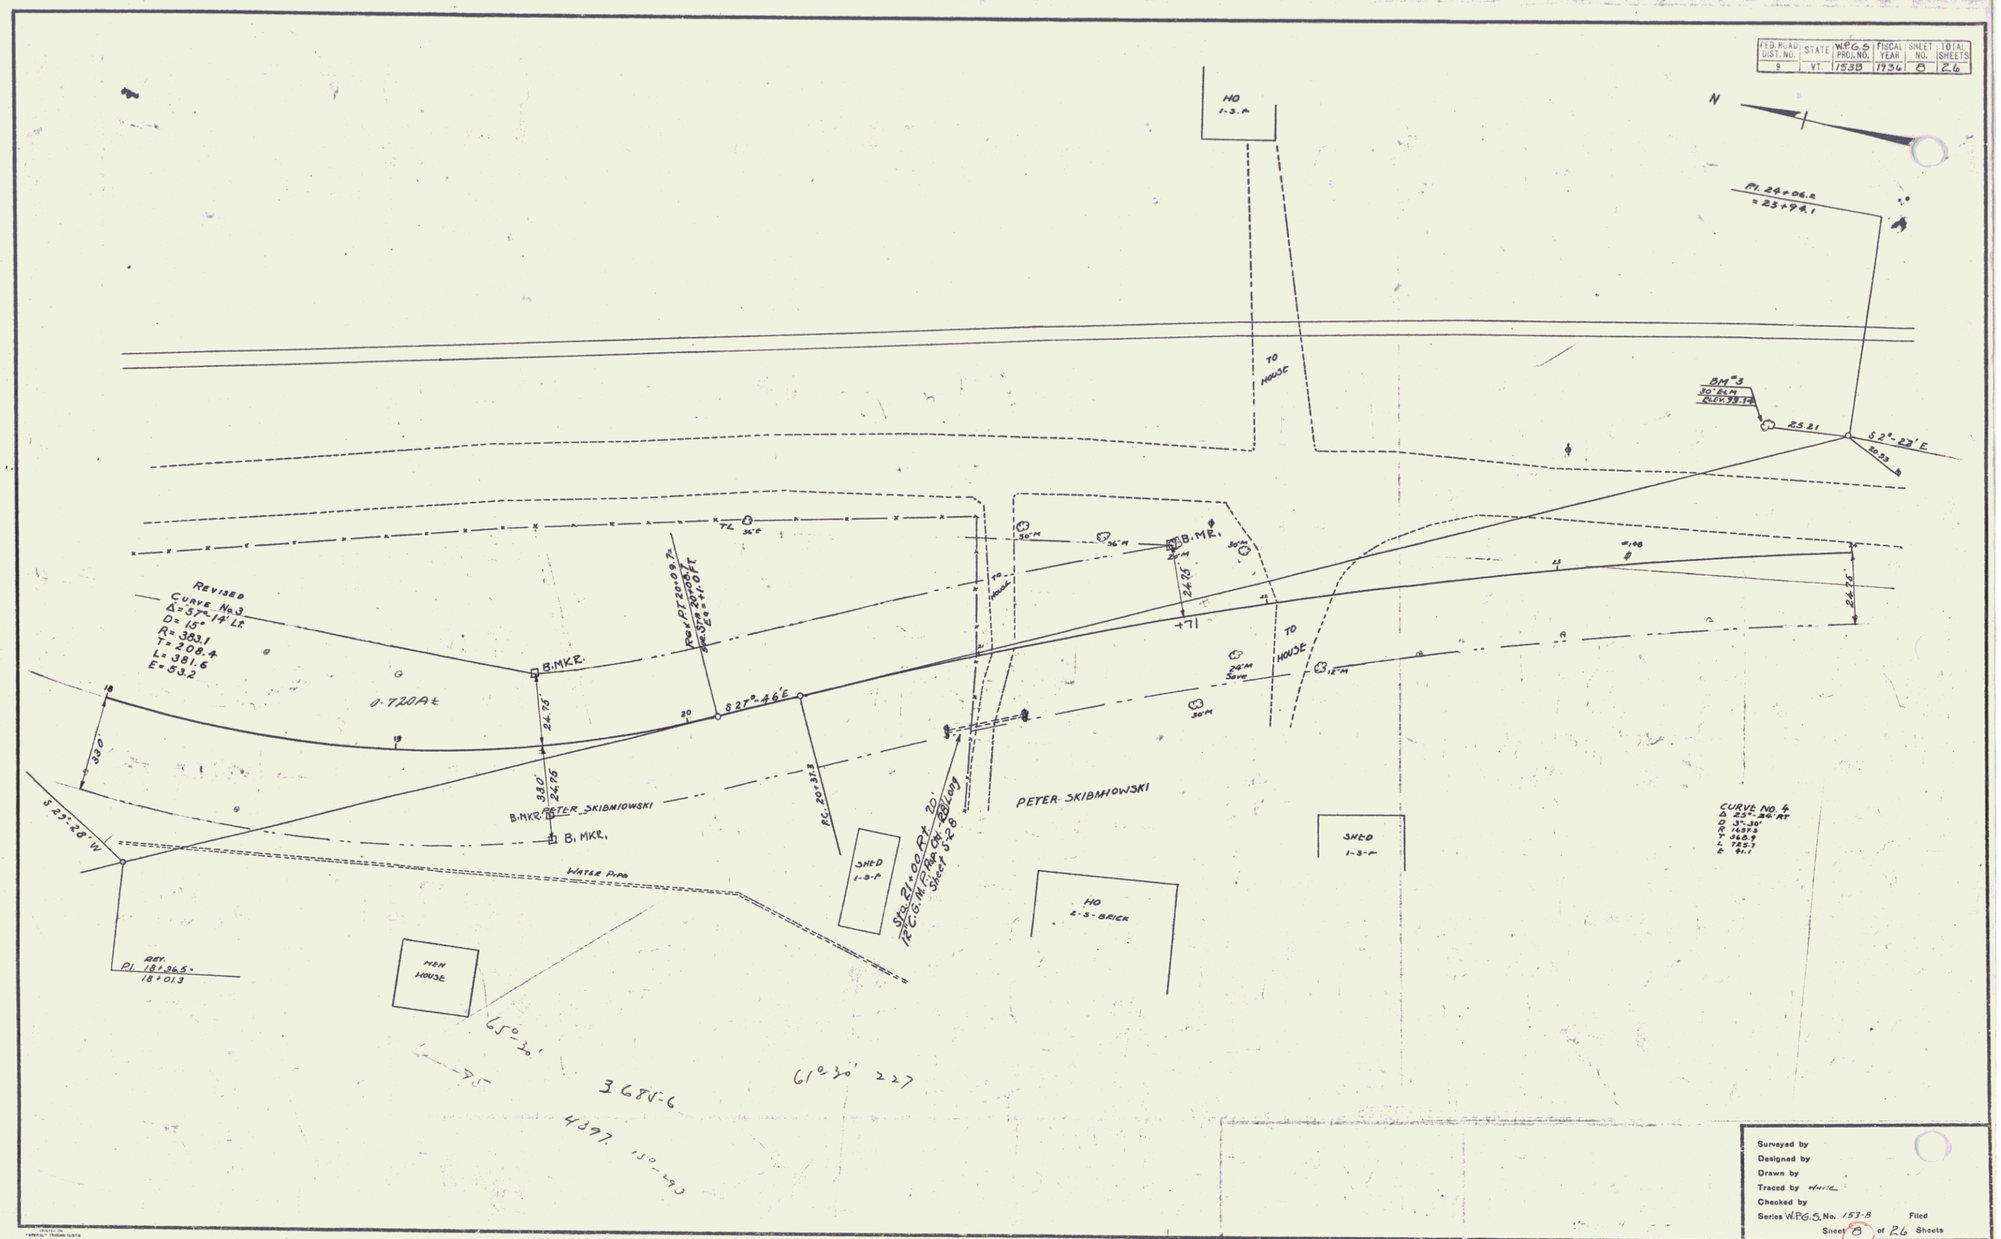

Surveyed by
Designed by
Drawn by
Traced by HWC
Checked by
Series W.P.G.S. No. 153-B Filed
Sheet 8 of 26 Sheets

5