STA.	CULVERT QUANTITIES DIAM.	LENG.	C.R.M.	EXCAVATION	GUIDE POSTS LT.	RT	CULV. QUANTITIES CONC.	STEEL
48+30	24"	46'	2.8	63		2		
49+70	18"	44'	3.7	27		1	0.6	60
52+79	12"	8'	—	1		1		
47+00-53+16					78			
51+50-60+66					512			

Removing + Resetting CGR

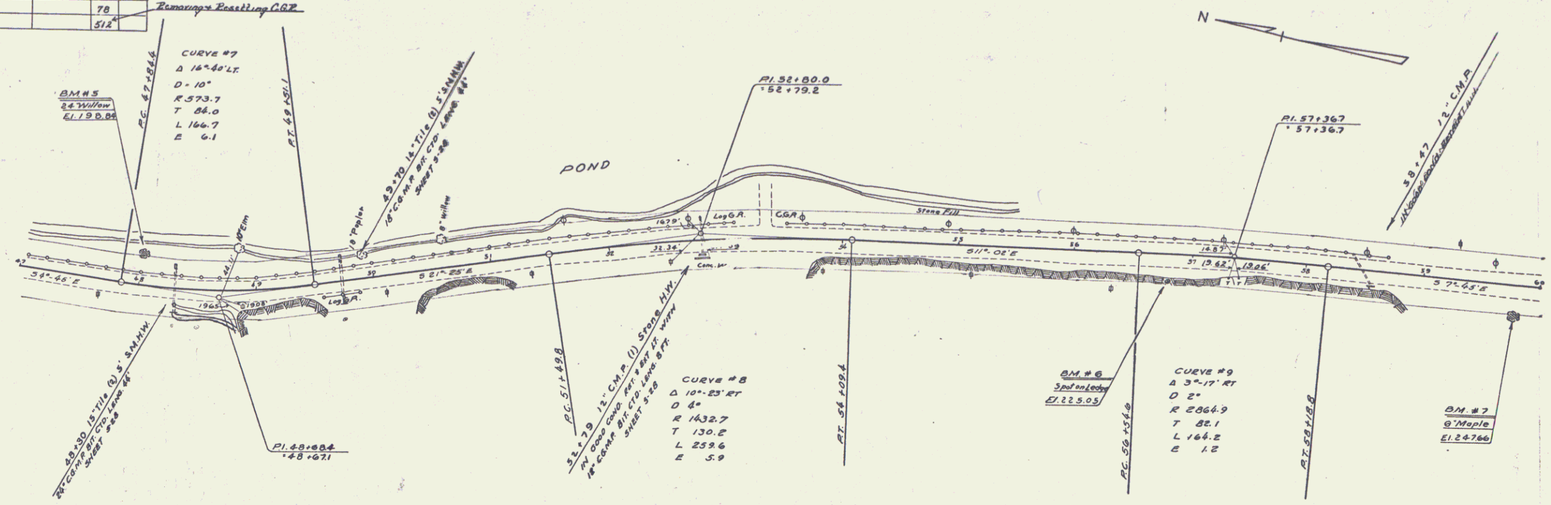

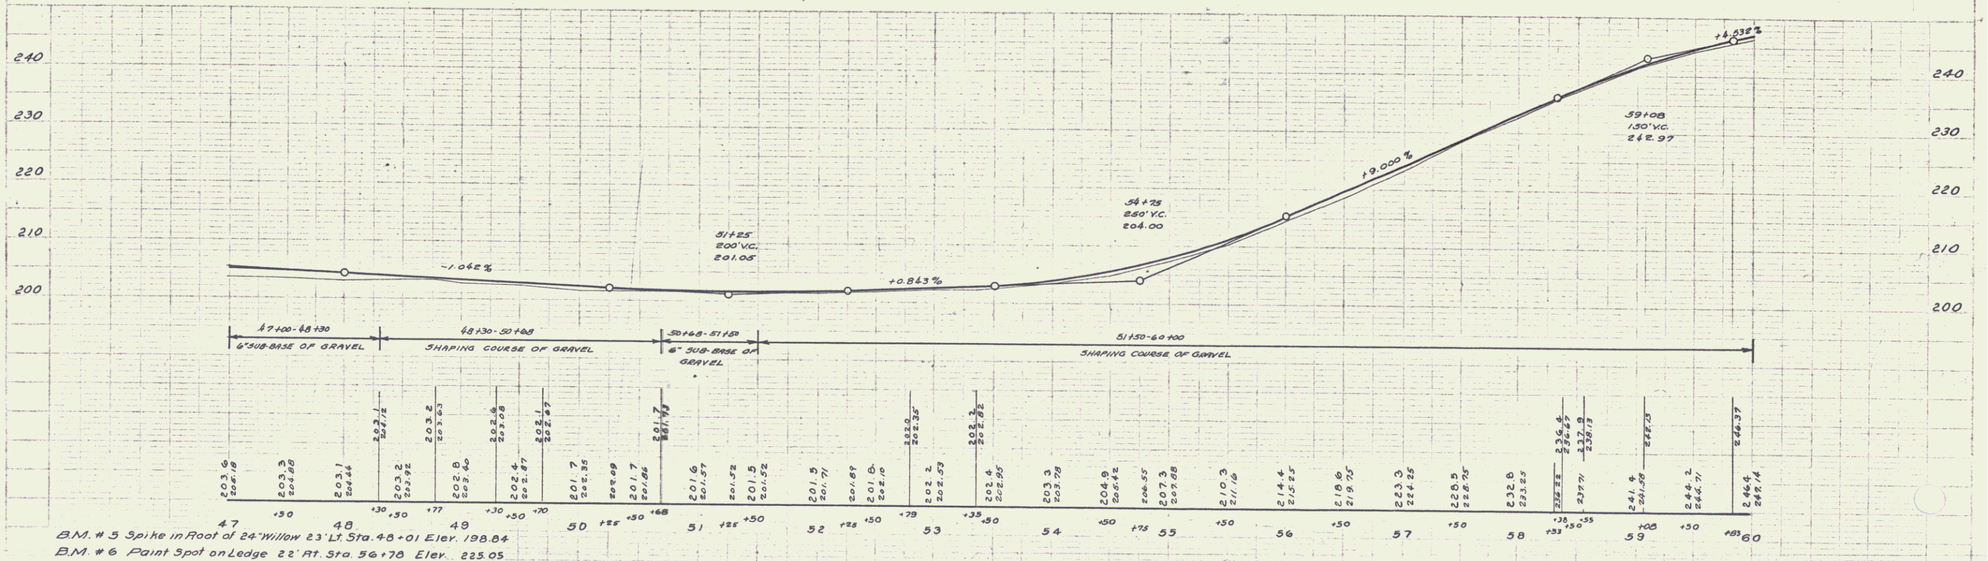

B.M. # 5 Spike in Root of 24" Willow 23' Lt. Sta. 48+01 Elev. 198.84
B.M. # 6 Paint Spot on Ledge 22' Rt. Sta. 56+78 Elev. 225.05
B.M. # 7 Spike in Root of 8" Maple 23' Rt. Sta. 59+81 Elev. 247.66

SERIES N.R.S. NO. 153
SHEET 7 OF 54

5