FED. ROAD DIST. NO.	STATE	PROJ. NO.	FISCAL YEAR	SHEET NO.	TOTAL SHEETS
5	VT.				

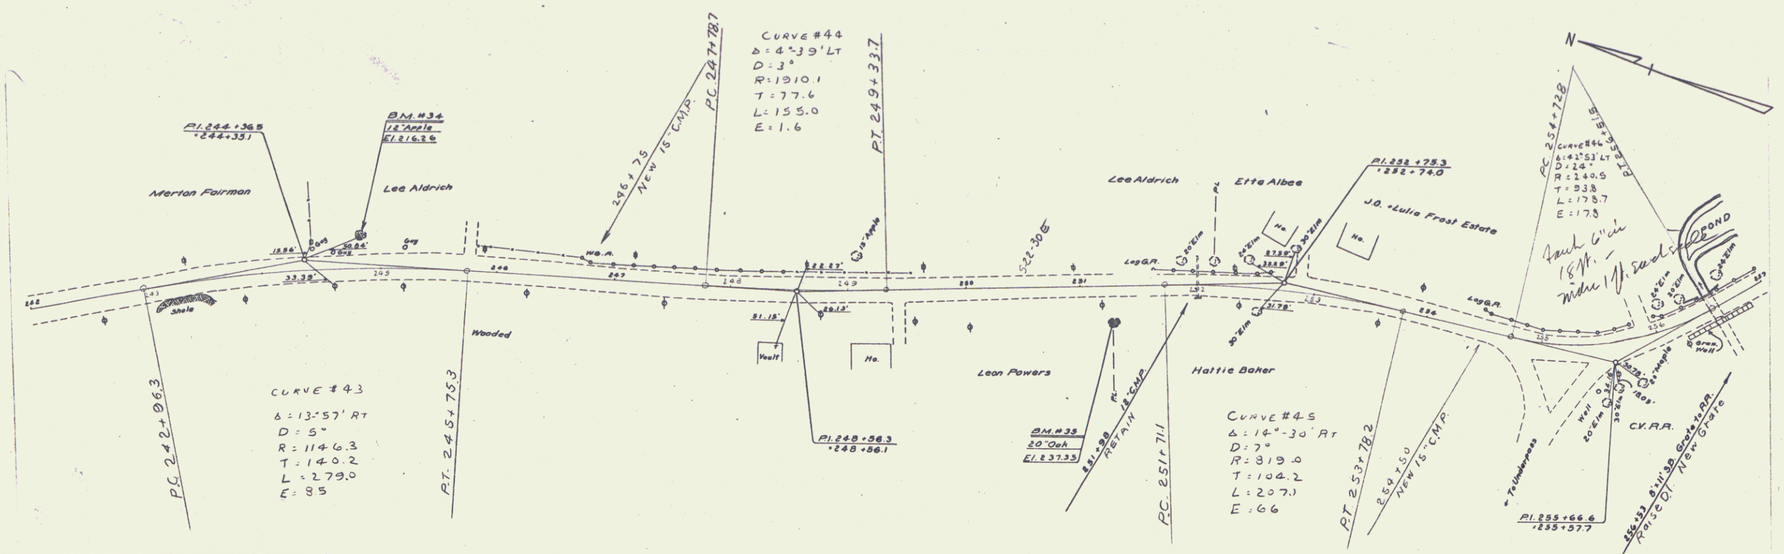

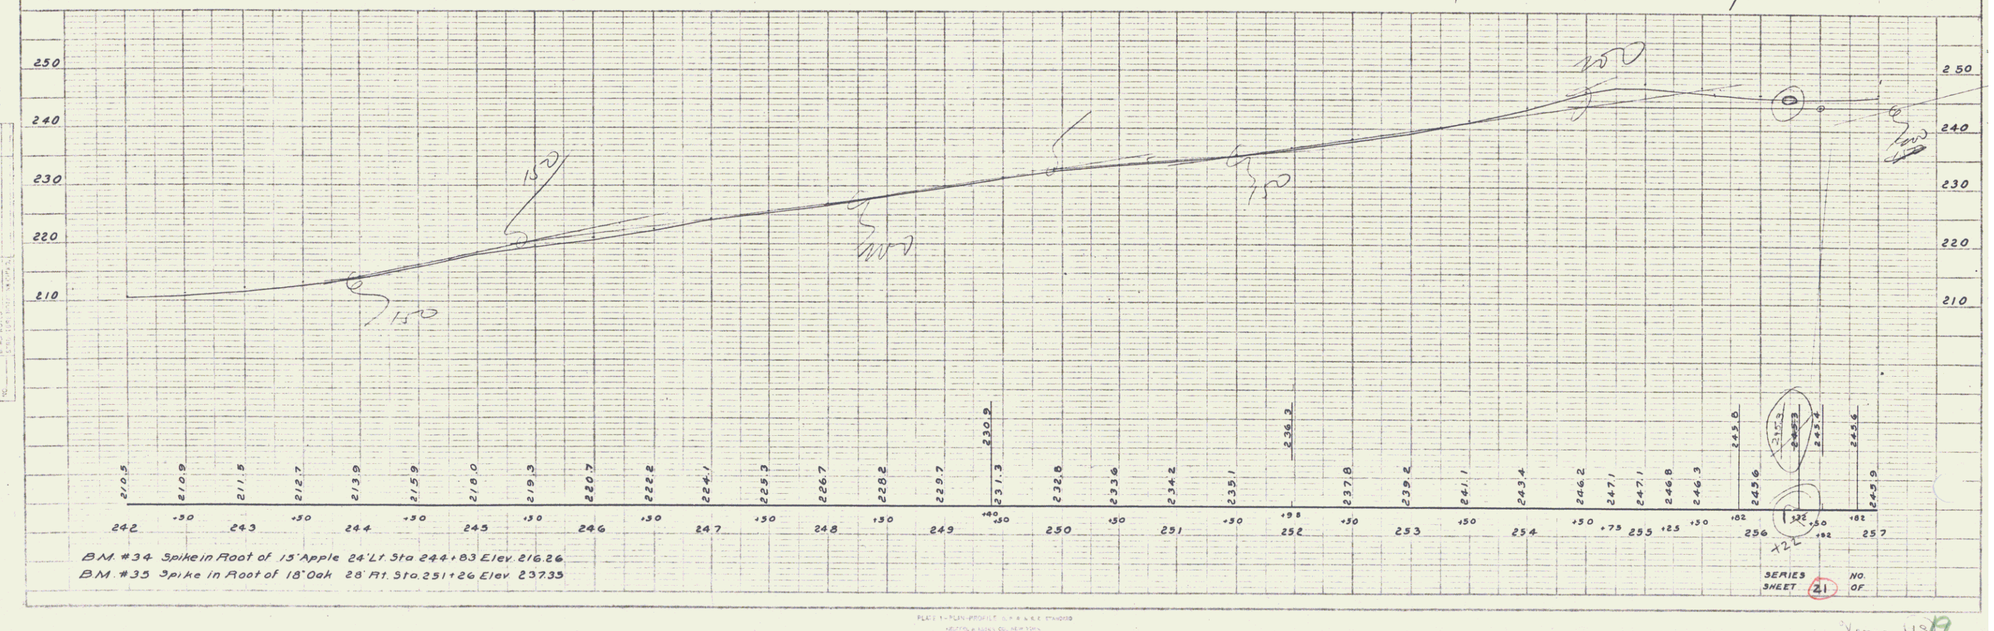

PLAN
SURVEYED A.D. Hoag 9/7/33
NOTE BOOK ALTAMIRO CHECKED R.W. Hammond
NO.

PROFILE
SURVEYED A.D. Hoag 9/7/33
NOTE BOOK FIGURES CHECKED R.W. Hammond
NO.

FILE 1 - PLAN-PROFILE 5 x 5 & 5 x 5 STANDARD
KEUFFEL & ESSER CO. NEW YORK

Vernon 1939