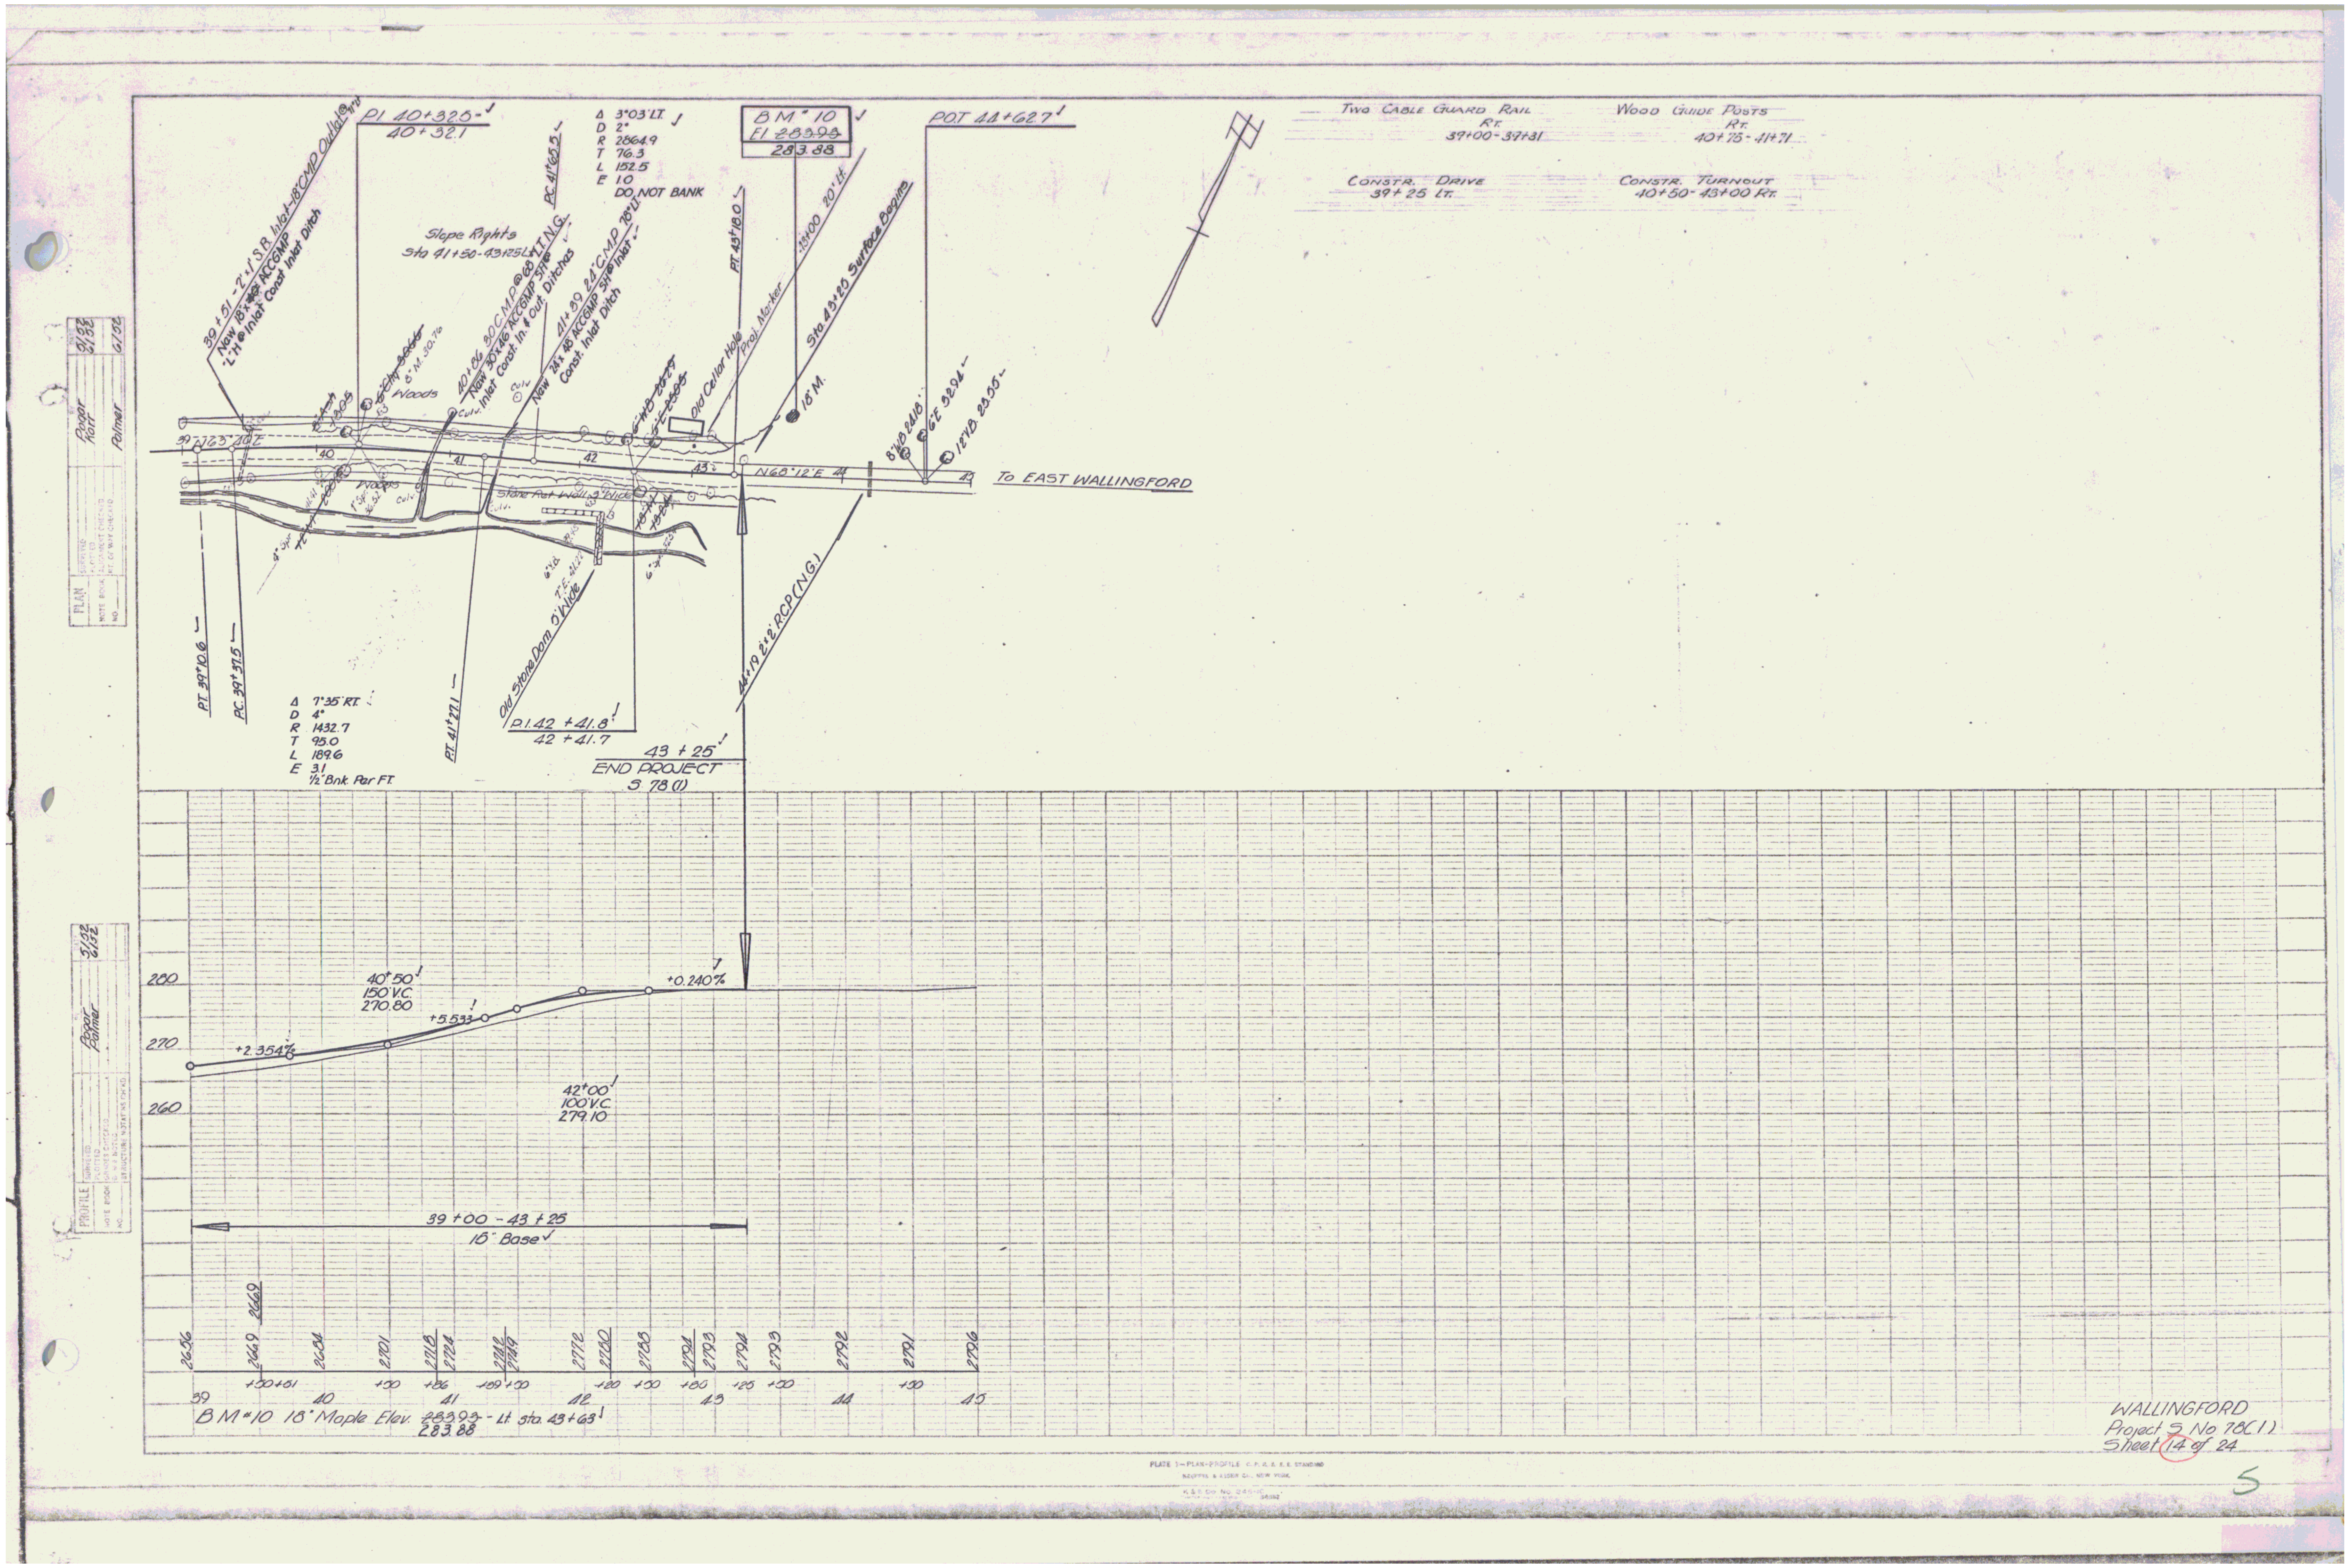
PI 40+32.5
40+32.1
BM # 10
El 283.98
283.88
POT 44+62.7
Two Cable Guard Rail
Rt.
39+00 - 39+31
Wood Guide Posts
Rt.
40+75 - 41+71
Constr. Drive
39+25 Lt.
Constr. Turnout
40+50 - 43+00 Rt.
Slope Rights
Woods
DO NOT BANK
Old Cellar Hole
To EAST WALLINGFORD
N60°12'E
P.I. 42+41.8
42+41.7
43+25
END PROJECT
S 78 (1)
39+00 - 43+25
18" Base
150 V.C.
270.80
100 V.C.
279.10
+0.240%
280
270
260
BM #10 18" Maple Elev. 283.98 - Lt. sta. 43+63
283.88
WALLINGFORD
Project S No 78(1)
Sheet 14 of 24