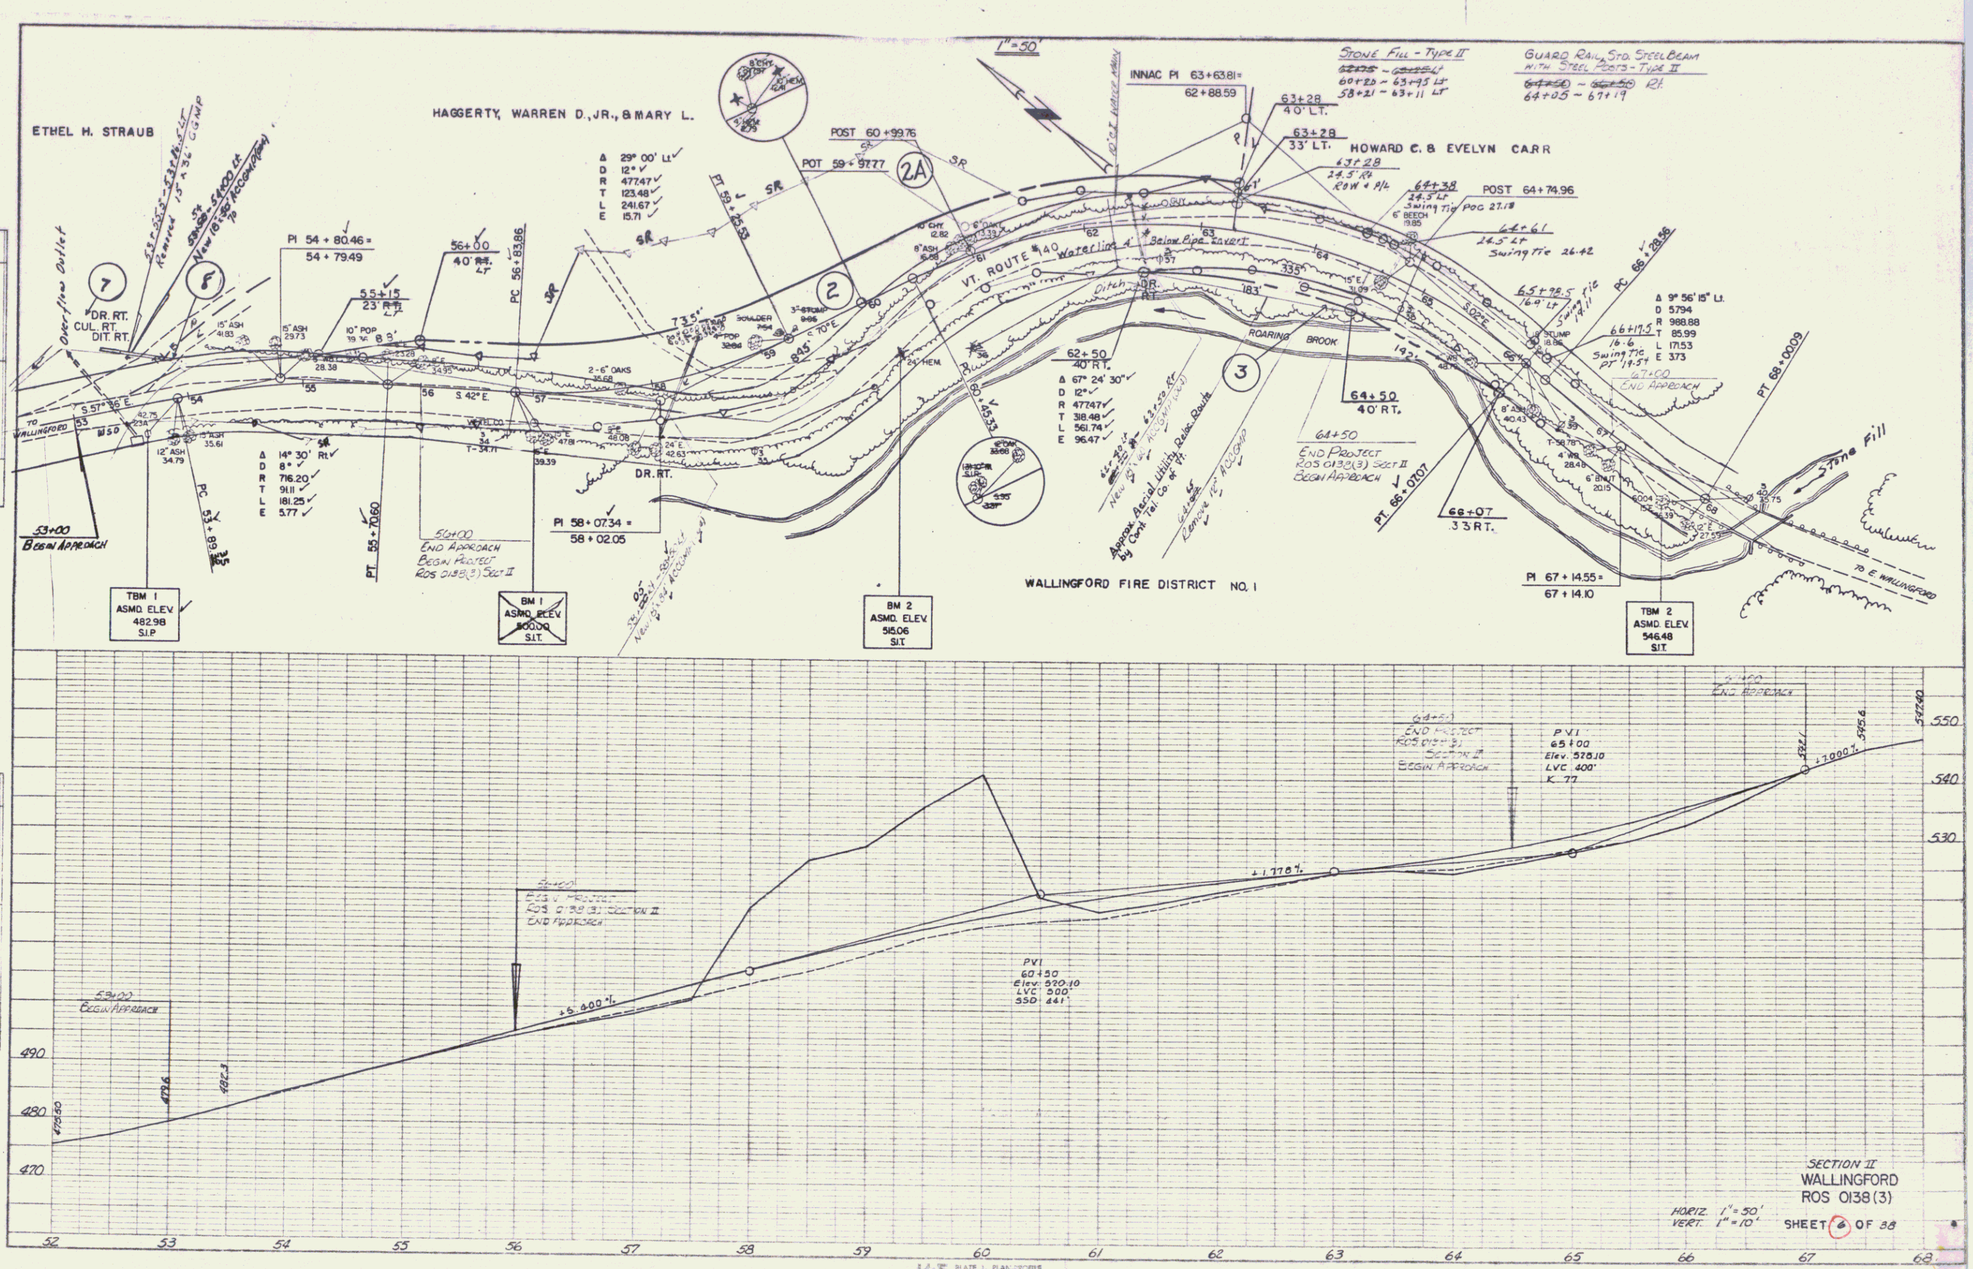
1" = 50'
ETHEL H. STRAUB
HAGGERTY, WARREN D., JR., & MARY L.
HOWARD C. & EVELYN CARR
VT. ROUTE #140
ROARING BROOK
WALLINGFORD FIRE DISTRICT NO. 1
TO WALLINGFORD
TO E. WALLINGFORD
Overflow Outlet
Stone Fill
Stone Fill - Type II
Guard Rail, Std. Steel Beam with Steel Posts - Type II
Approx. Aerial Utility Poles Route by Cont. Tel. Co.
Waterline 4' Below Pipe Invert
Ditch
Remove 12" Culvert
