FED. ROAD EST. NO.	STATE	STATE NO.	FISCAL YEAR	SHEET NO.	TOTAL SHEETS
		3	29(1) 1946	9	34

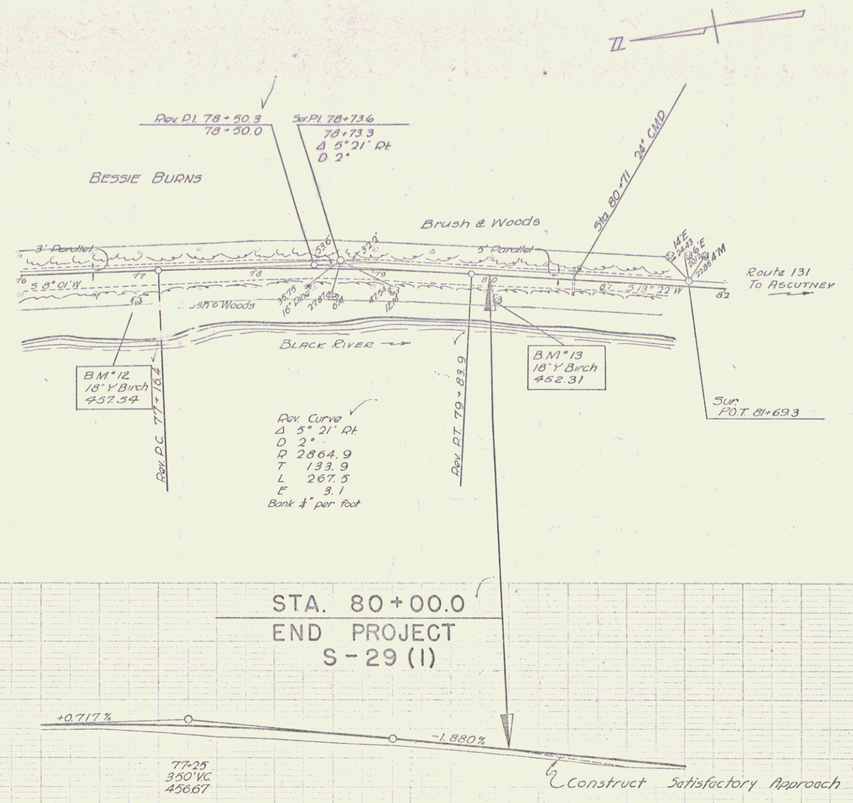

Series 5 no. 29(1)
Sheet 9 of 34 sheets
CAVENDISH

7