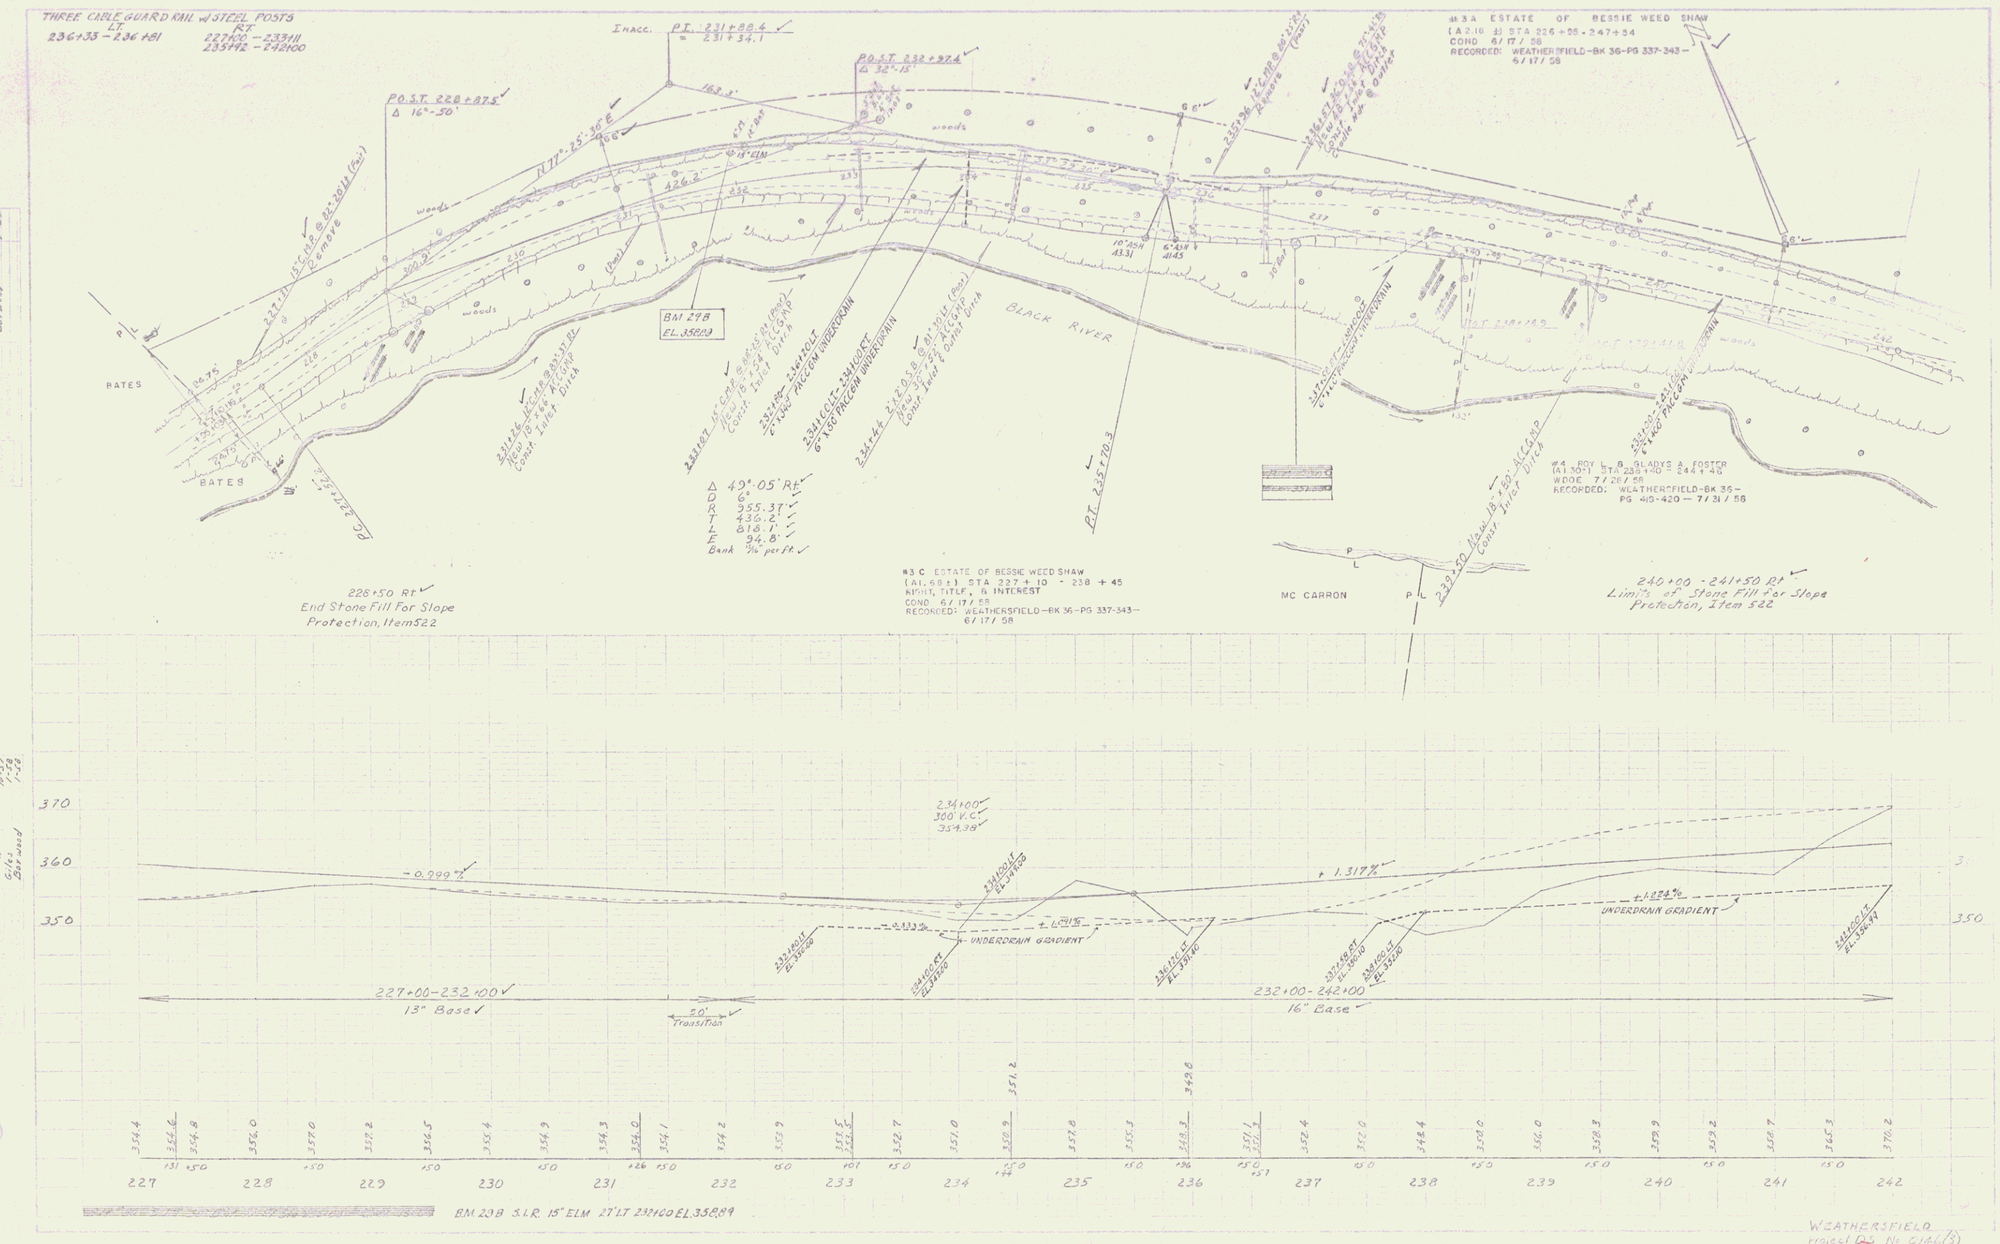

WEATHERSFIELD
Project No. 0146(3)
Sheet 9 of 63 Sheets

4

4