POOR ORIGINAL COPY

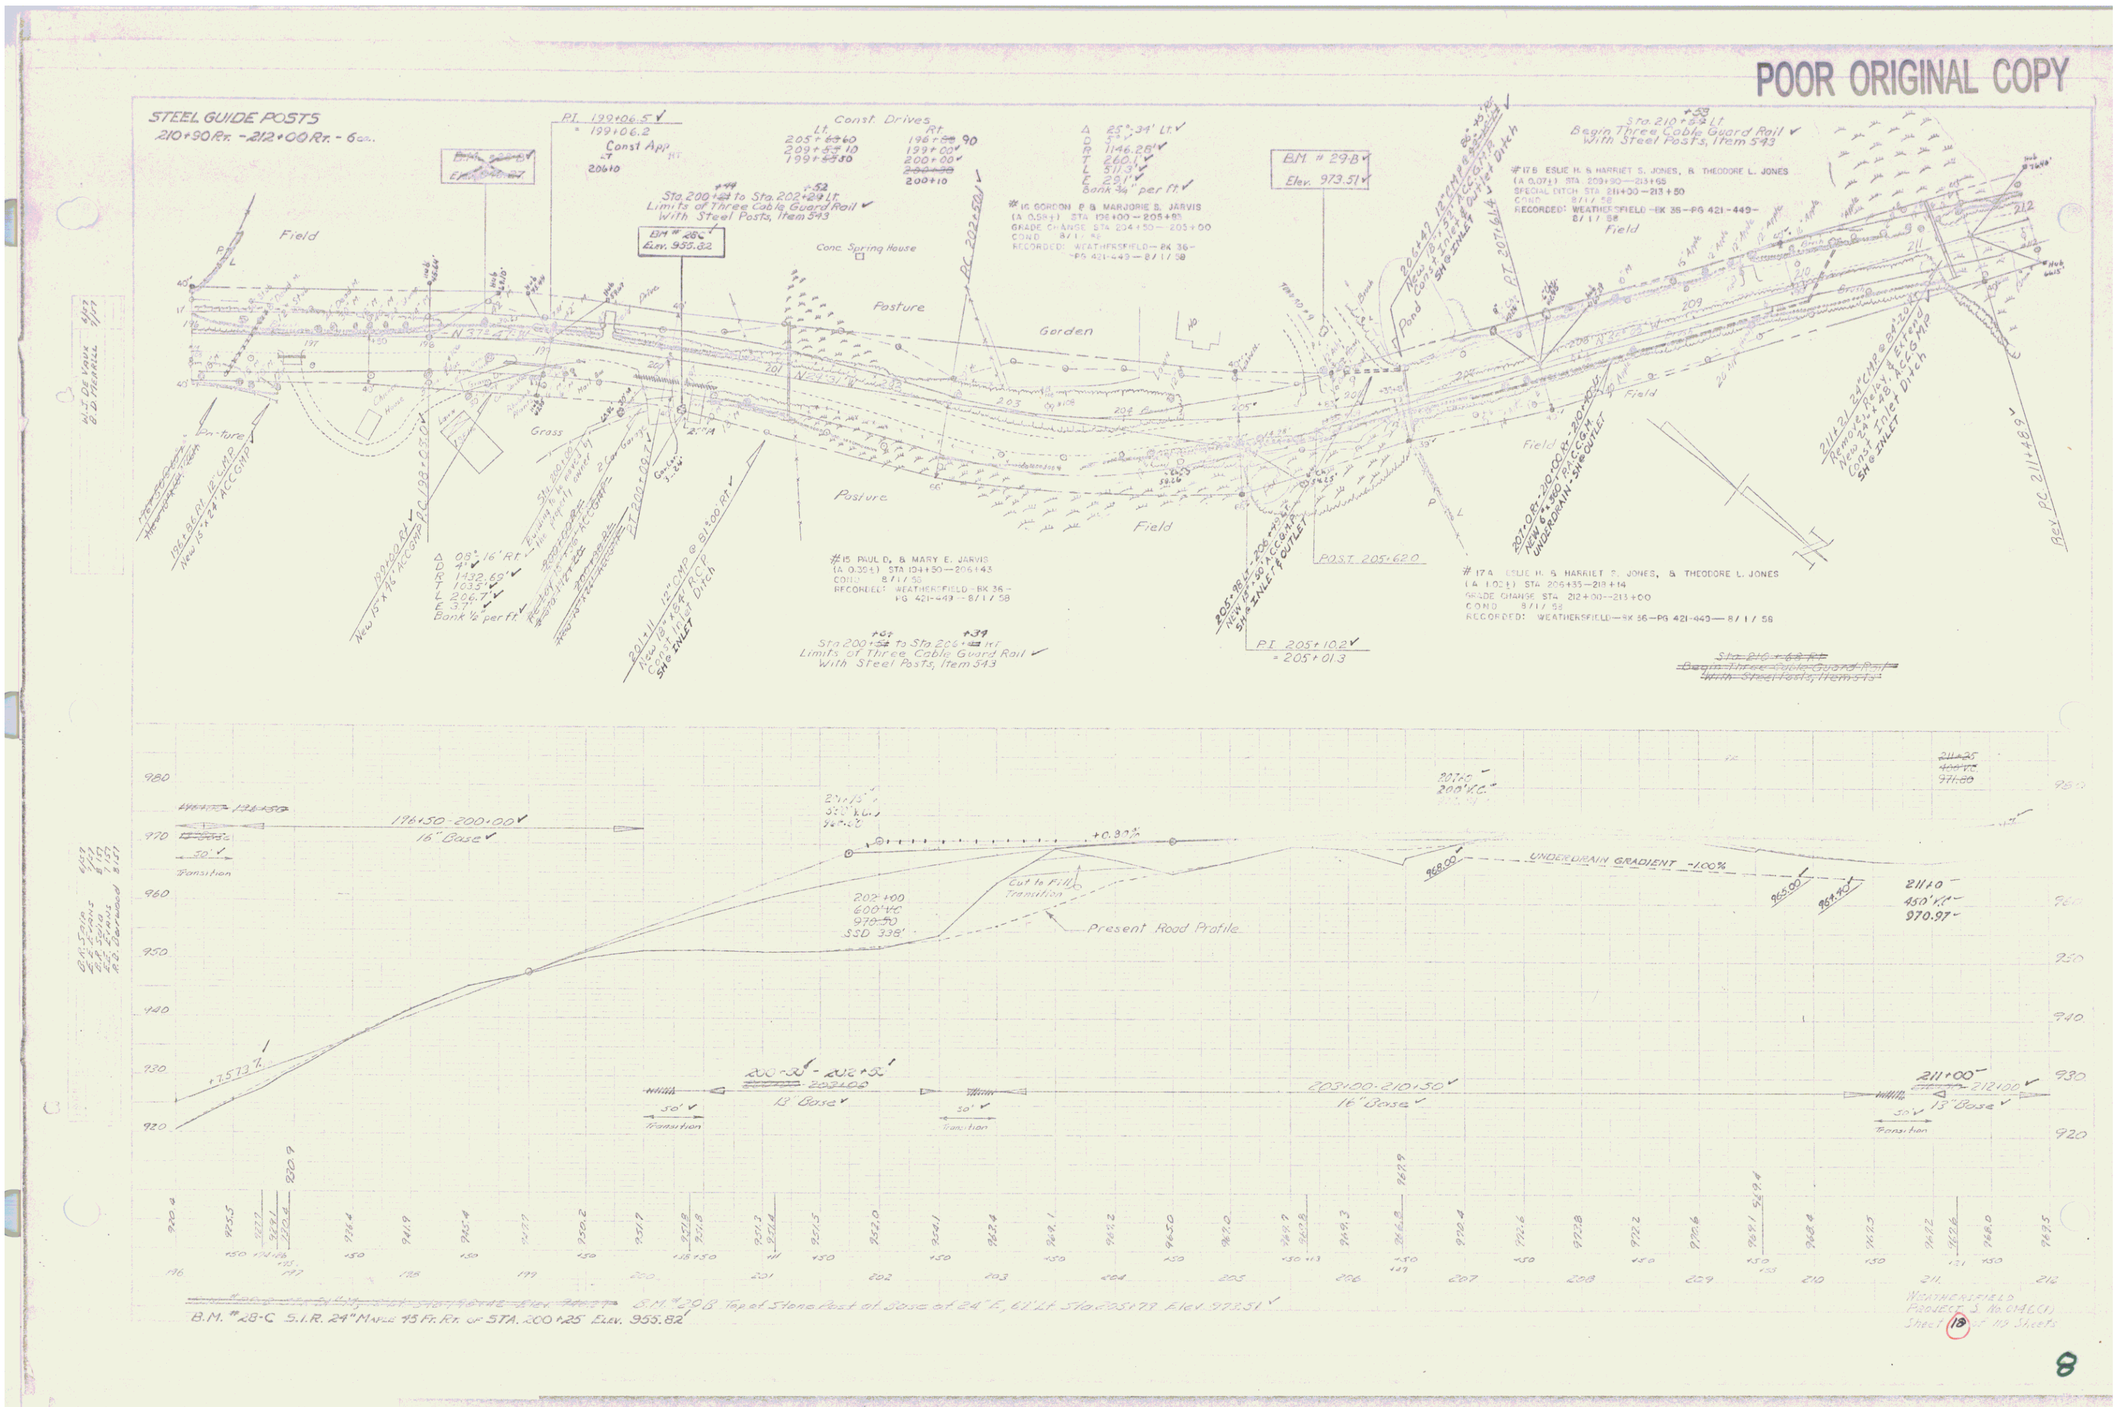
STEEL GUIDE POSTS
210+90 Rt. - 212+00 Rt. - 6 ea.
PI 199+06.5
= 199+06.2
Const App
20610
Const. Drives
Lt. Rt.
205+60 196+90
209+50 199+00
199+80 200+00
200+10
Sta. 200+44 to Sta. 202+29 Lt.
Limits of Three Cable Guard Rail
With Steel Posts, Item 543
BM # 28C
Elev. 955.82
Conc. Spring House
Field
Pasture
Garden
Grass
Pond
Ditch
Δ 25°-34' Lt.
D 5°
R 1146.28'
T 262.1'
L 511.3'
E 29.1'
Bank ¾" per ft.
BM # 29B
Elev. 973.51
PC 202+50
PT 206+14
Begin Three Cable Guard Rail
With Steel Posts, Item 543
#17B ESLIE H. & HARRIET S. JONES, & THEODORE L. JONES
(A 0.07±) STA. 209+90—213+65
SPECIAL DITCH STA. 211+00—213+50
COND 8/1/58
RECORDED: WEATHERSFIELD—BK 36—PG 421-449—8/1/58
#16 GORDON P. & MARJORIE S. JARVIS
(A 0.54±) STA. 196+00—205+65
GRADE CHANGE STA. 204+50—205+00
COND 8/1/58
RECORDED: WEATHERSFIELD—BK 36—PG 421-449—8/1/58
D 4°
R 1432.69'
Bank ½" per ft.
New 15" x 24" ACCGMP
1984 BCRA 18" CMP
In-ture
PC 198+82.0
PT 200+69.7
New 12" x 24" ACCGMP
Sta. 200+11 12" CMP @ 81.00 Rt.
Clean 18" x 24" RCP
Sta. 200+11 Inlet Ditch
#15 PAUL D. & MARY E. JARVIS
(A 0.39±) STA 194+50—206+43
COND 8/1/58
RECORDED: WEATHERSFIELD—BK 36—PG 421-449—8/1/58
Sta. 200+44 to Sta. 206+43 Rt.
Limits of Three Cable Guard Rail
With Steel Posts, Item 543
New 15" x 24" ACCGMP
Sta. 205+99 Lt. 205.00'
New 15" x 24" ACCGMP