POOR ORIGINAL COPY

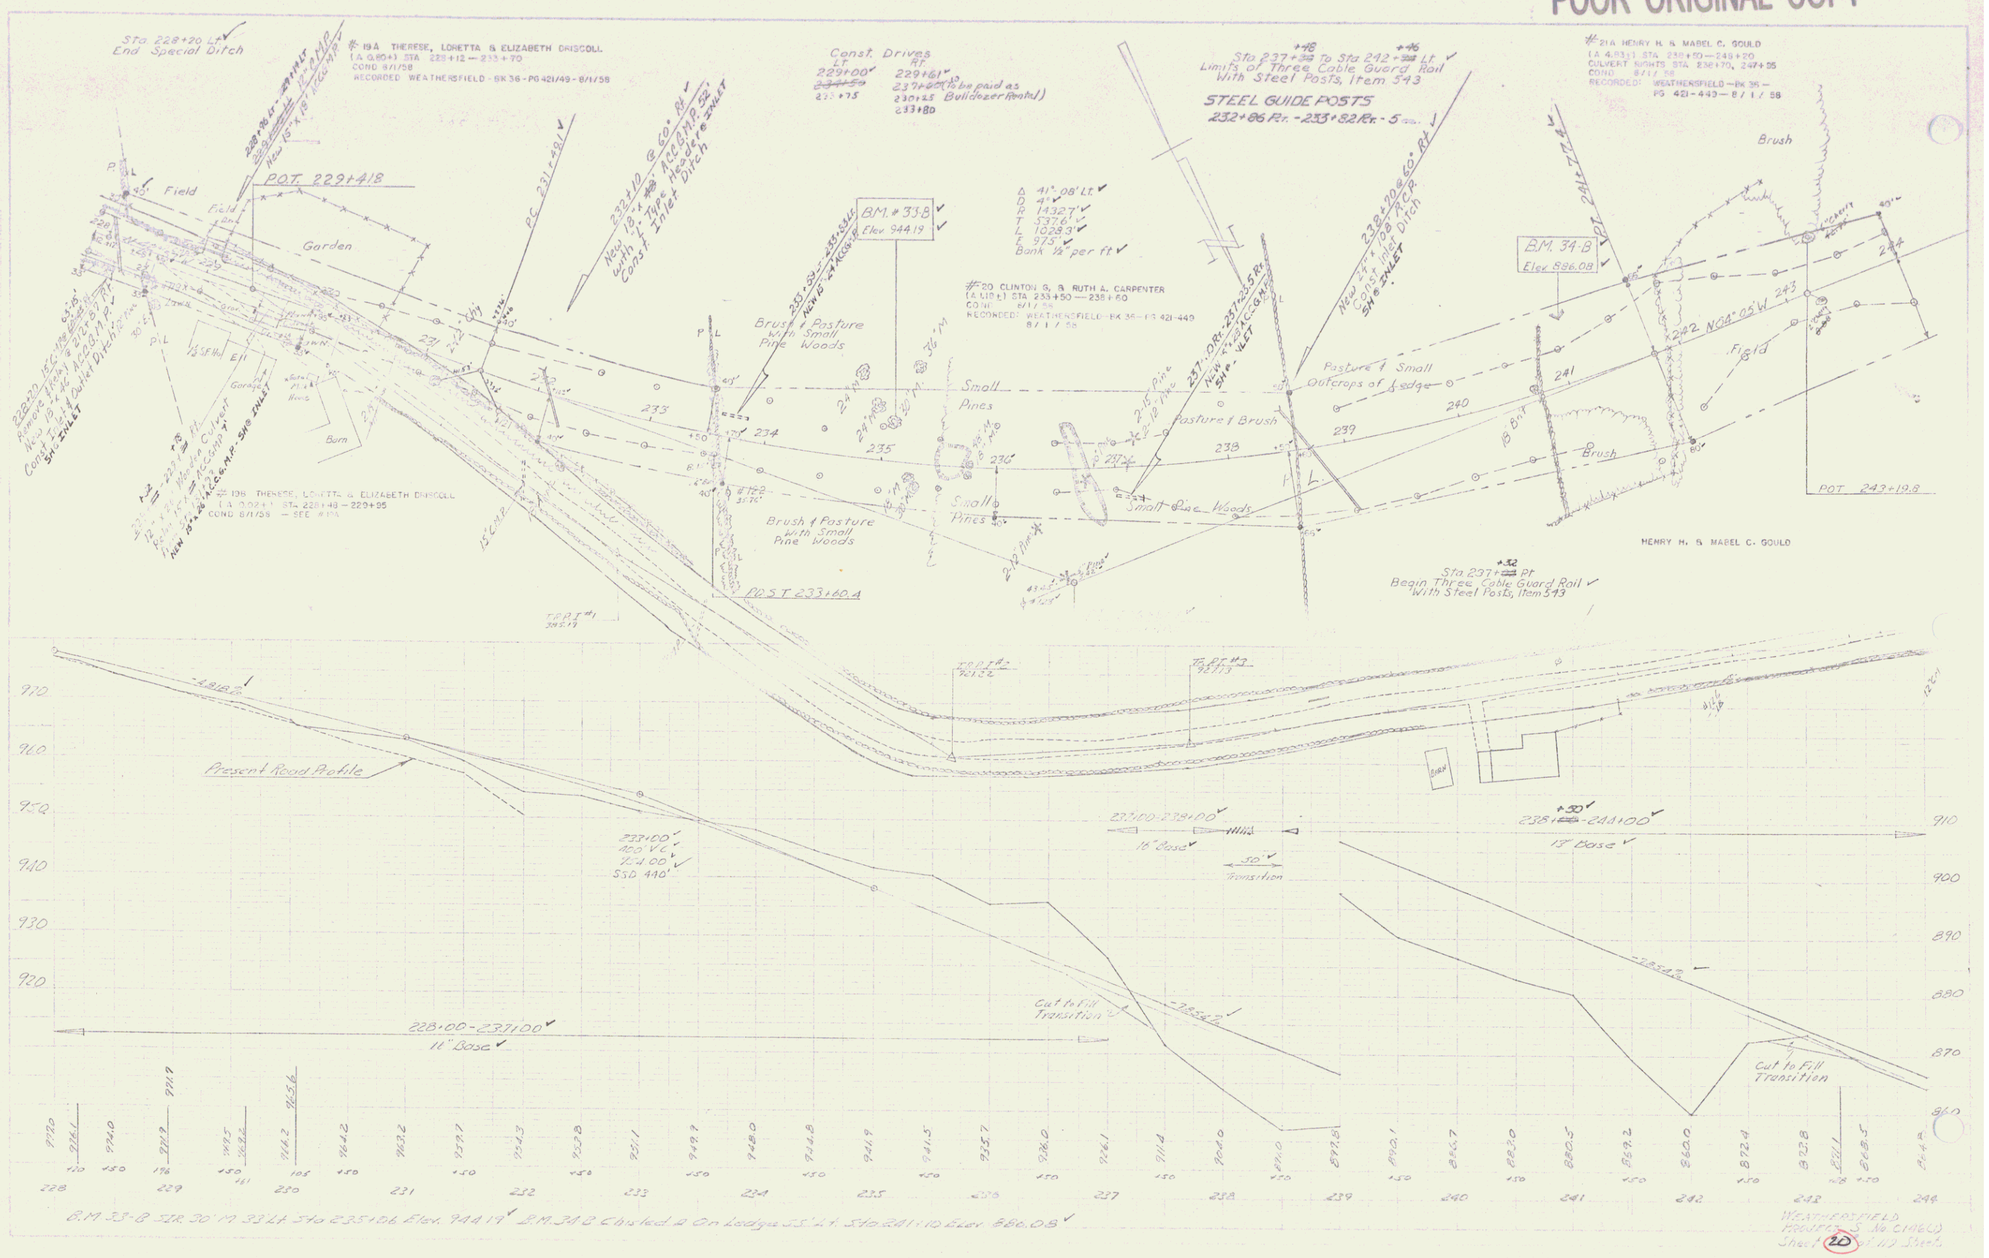

10