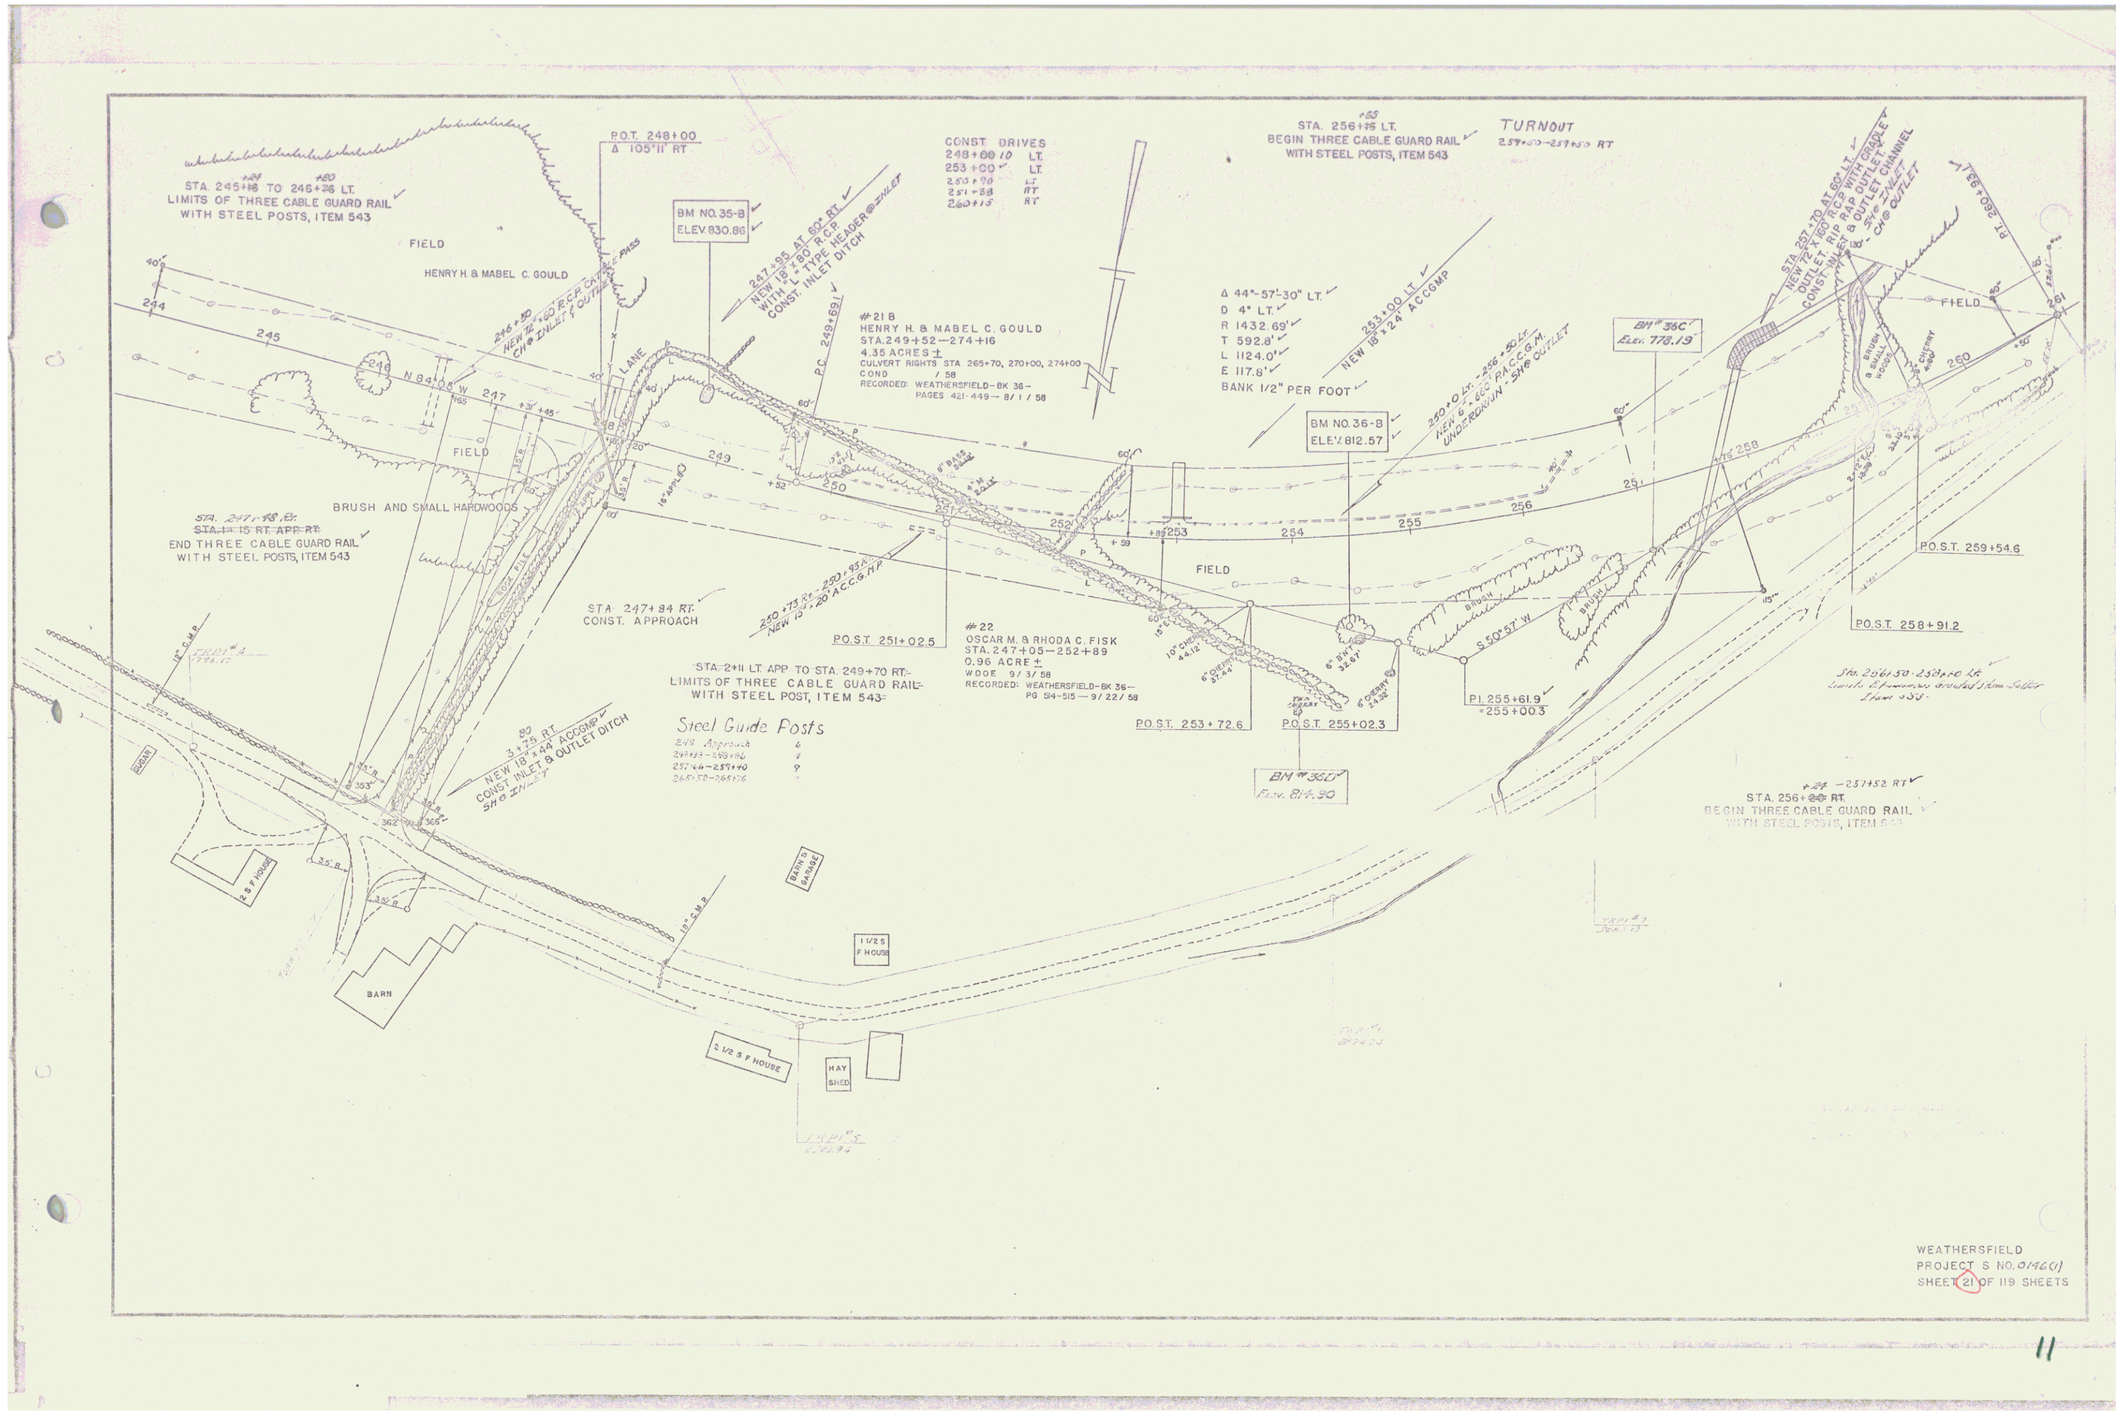
STA 245+18 TO 246+26 LT.
LIMITS OF THREE CABLE GUARD RAIL
WITH STEEL POSTS, ITEM 543
FIELD
HENRY H. & MABEL C. GOULD
P.O.T. 248+00
Δ 105°11' RT
BM NO. 35-B
ELEV. 830.86
CONST DRIVES
248+00 LT.
253+00 LT.
STA. 256+15 LT.
BEGIN THREE CABLE GUARD RAIL
WITH STEEL POSTS, ITEM 543
TURNOUT
#21 B
HENRY H. & MABEL C. GOULD
STA. 249+52—274+16
4.35 ACRES ±
CULVERT RIGHTS STA 265+70, 270+00, 274+00
COND / 58
RECORDED: WEATHERSFIELD-BK 36-
PAGES 421-449 — 8/1/58
Δ 44°-57'-30" LT.
D 4° LT.
R 1432.69'
T 592.8'
L 1124.0'
E 117.6'
BANK 1/2" PER FOOT
NEW 18" x 24' ACCGMP
BM NO. 36-B
ELEV. 812.57
BM # 36C
Elev. 778.19
BM # 36D
Elev. 814.90
FIELD
BRUSH AND SMALL HARDWOODS
STA. 247+18 Rt.
END THREE CABLE GUARD RAIL
WITH STEEL POSTS, ITEM 543
STA 247+84 RT.
CONST. APPROACH
P.O.S.T. 251+02.5
#22
OSCAR M. & RHODA C. FISK
STA. 247+05—252+89
0.96 ACRE ±
WDOE 9/3/58
RECORDED: WEATHERSFIELD-BK 36-
PG 514-515 — 9/22/58
STA. 2+11 LT. APP TO STA. 249+70 RT.
LIMITS OF THREE CABLE GUARD RAIL
WITH STEEL POST, ITEM 543
Steel Guide Posts
P.O.S.T. 253+72.6
P.O.S.T. 255+02.3
P.I. 255+61.9
=255+00.3
P.O.S.T. 259+54.6
P.O.S.T. 258+91.2
STA. 256+80 RT.
BEGIN THREE CABLE GUARD RAIL
WITH STEEL POSTS, ITEM 543
BARN
2 S F HOUSE
BARN'S GARAGE
1 1/2 S F HOUSE
2 1/2 S F HOUSE
HAY SHED
WEATHERSFIELD
PROJECT S NO. 0196(1)
SHEET 21 OF 119 SHEETS

11