INDEX OF SHEETS ADDED IN FINALS

SHEET NO. 66-72 REVISED CROSS SECTION SHEETS
73-76 BORROW PIT
77 GRAVEL COMPUTATIONS ROUTE 12
78+82 DRAINAGE
5-A FINAL EARTHWORKS

SHEET NO.

1. Title Page
2. Typical Sections
3. Quantity Sheet
4. Item Detail and Drainage Sheet
5. Earthworks
6-7. Plan and Profile Sheets
8-9. Intersection Detail Sheets
10-11. Traffic Signals
12-13. Overhead Traffic Sign Supports
14-18. Traffic Signs
19-20. Details of 102" Pipe 6507.00
21. Blank
22. Blank
23. A-61 Solid Rock Excavation
24. D-1 Blanking Tables
25. D-5 Typical Slope Grading
26. D-6 Muck Excavation
27. C-1 Curbs
28. C-1A Curbs
29. D-2 Headwalls
30. D-3 Gutters
31. D-4 Erosion & Flushing Basins
32. D-8 Drop Inlets
33. D-9 Drop Inlet Tops
34. D-10 Drop Inlet Tops
35. D-11 Grates
36. E-1 Barricades, Lights & Signs
37. E-5A Sign Post Footings
38. E-11 Interstate Route Markers
39. E-12 U.S. Route Markers
40. E-13 State Route Markers
41. E-15 Regulatory Signs
42. E-16 Warning Signs
43. E-18 Guide Signs
44. E-19 Standard Sign Placement
45. E-21 Identification Signs
46. G-3 Guard Rail
47. G-4 Marker Posts
48. J-1 Project Markers
49. Blank
50-65. Cross Section Sheets

PROJECT NAME & NUMBER TYPE PAVMT AREA
WEATHERSFIELD S 0146(4) BIT.CONC. 7,572 S.Y.

RECORD PLANS

MATERIALS

SUBBASE OF GRAVEL - BARTON PIT, PERKINSVILLE, VERMONT
SHOULDER GRAVEL - CHILDS PIT, PERKINSVILLE, VERMONT
CRUSHED GRAVEL PLANT MIXED BASE COURSE
L.M. PIKE & SON PLANT, W. LEBANON, NEW HAMPSHIRE
BIT. CONC. - L.M. PIKE & SON PLANT, W. LEBANON, N. HAMP.
CONCRETE - MILLER READY MIX, W. LEBANON, N. HAMP.
REINF. STEEL - REPUBLIC STEEL CORP. BUFFALO, NEW YORK
TAR - WITCO CHEMICAL CO., WORCESTER, MASS.
ASPHALT - MOBIL OIL, E. PROVIDENCE, RHODE ISLAND
PEA STONE - COLE RIVER SAND & GRAVEL, E. WALPOLE, N.H.
STONE GRITS - VERMONT MARBLE CO., FLORENCE, VERMONT
REINF. CONCRETE PIPE - HUME PIPE OF NEW ENGLAND, INC.
METAL PIPE CULVERTS - NORTHEASTERN CULVERT CORP. WESTMINSTER, VERMONT
GUARD RAIL - S.T. GRISWOLD & CO., INC., ESSEX JUNCTION, VT.
GRANITE CURB & SLOPE EDGING - NATIONAL FENCE & GRANITE CO., INC. CONCORD, N. HAMP.
TRAFFIC SIGNALS - R.W. LEBRON, WALTHAM, MASS.
JUTE MATTING - SELTON BAGGING CO., FARMINGTON, N.H.
TRAFFIC SIGNS & DELIMEATORS - STANDARD SIGN & SIGNAL CO., CLINTON, MASS.

CONTRACTOR: CALEDONIA SAND & GRAVEL, INC. ST JOHNSBURY, VT.
RESIDENT ENGINEER: H.K. MACLAY
RECORD PLANS: R.P. RUSSELL, J.F.

CONTRACT DATED: NOV 20, 64
STARTED: NOV. 30, 1964
COMPLETED: SEPT. 14, 1965
ACCEPTED: SEPT. 14, 1965

STATE OF VERMONT
DEPARTMENT OF HIGHWAYS

PROPOSED IMPROVEMENT

SECONDARY PROJECT

TOWN OF WEATHERSFIELD
COUNTY OF WINDSOR
VT. ROUTE 131
LUDLOW, VT.—CLAREMONT, N.H. ROAD

BEGINNING AT A POINT 0.004 MILE NORTH WESTERLY OF THE INTERSECTION OF VERMONT ROUTE 131 AND U.S. ROUTE 5 AND EXTENDING WESTERLY 0.269 MILE

LENGTH OF PROJECT 1420.00 FEET = 0.269 MILE

ADT	1960	1050
ADT	1984	6750
DHV	1984	1050
D		60 %
T		7 %
V		50 M.P.H.

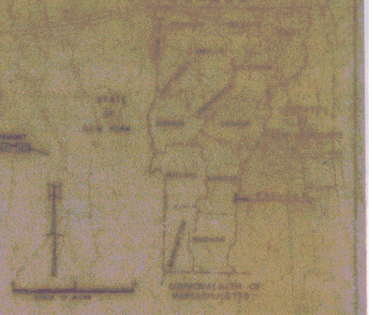

PROJECT: WEATHERSFIELD S 0146(4)
CONTRACTOR: CALEDONIA SAND & GRAVEL, INC.
ST JOHNSBURY, VERMONT
SURFACE: BITUMINOUS CONCRETE

PROJECT WEATHERSFIELD LENGTH 0.269 MI.
PROJECT NO. S 0146(4)
TYPE BITUMIOUS CONCRETE
CONTRACTOR CALEDONIA SAND & GRAVEL, INC. YEAR 1965
ST JOHNSBURY, VERMONT
LOCATION Beginning at a point 0.004 mile northwesterly of the intersection of Vermont Route 131 and U.S. Route 5 and extending westerly 0.269 mile.

0 1000 2000
SCALE IN FEET

D.L. Case 7-24-62	E.V. Stickney 12/10/62	Lee Bjorn 12/20/62	F.S. Chase 12/20/62	L.M. Lane 12/20/62	A.D. Bishop 12/10/62

Pin # 99R649

S 0146(4)

65