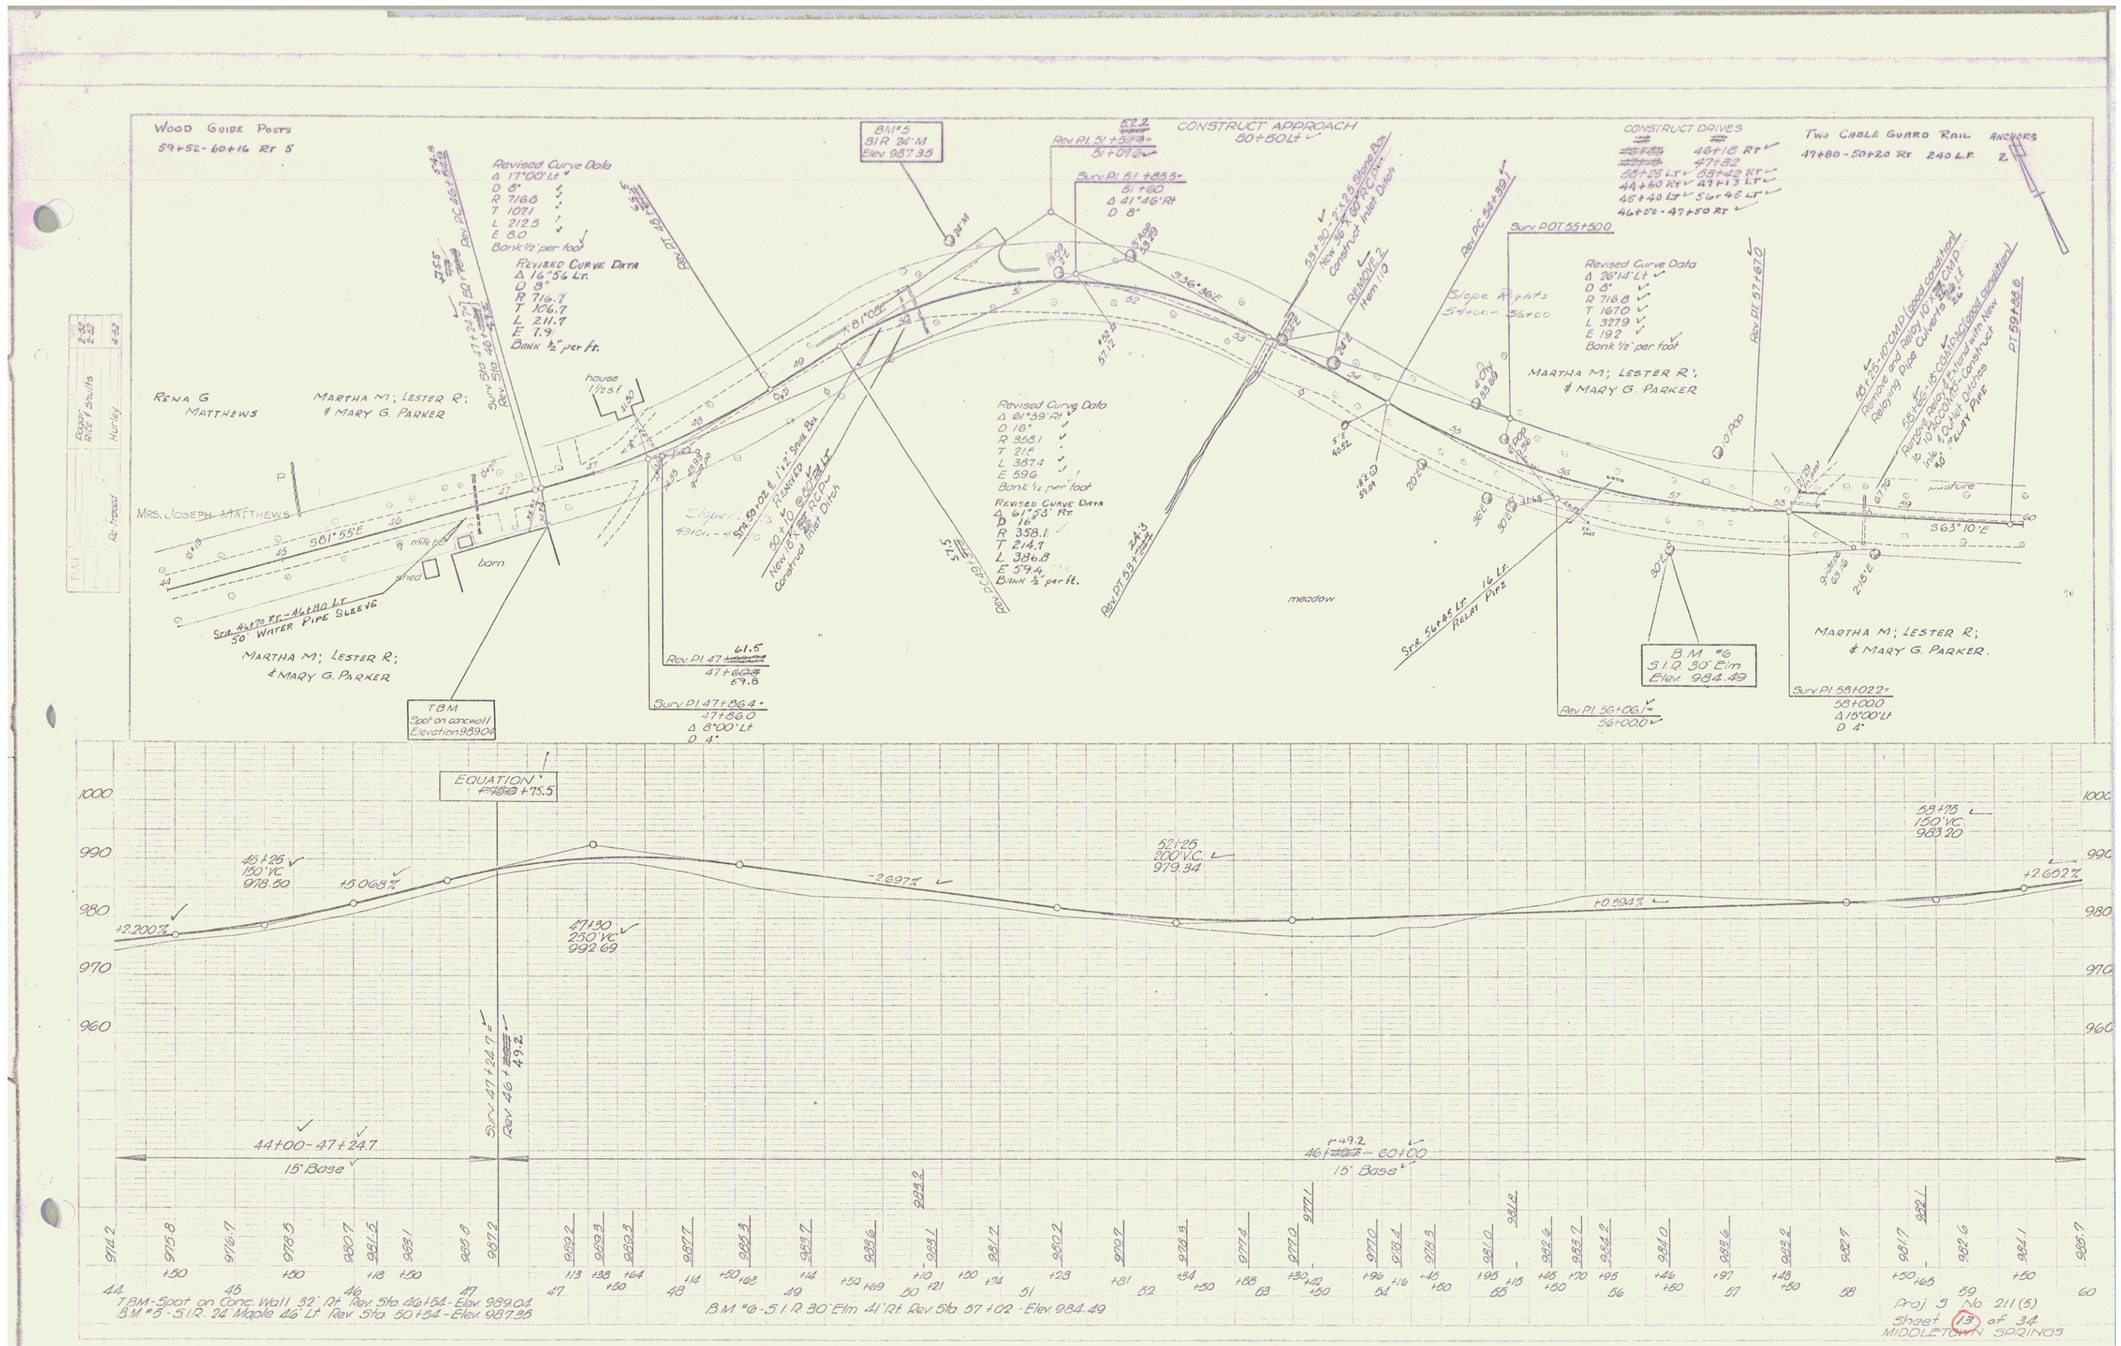

Proj. S No. 211(5)
Sheet 13 of 34
MIDDLETOWN SPRINGS

4