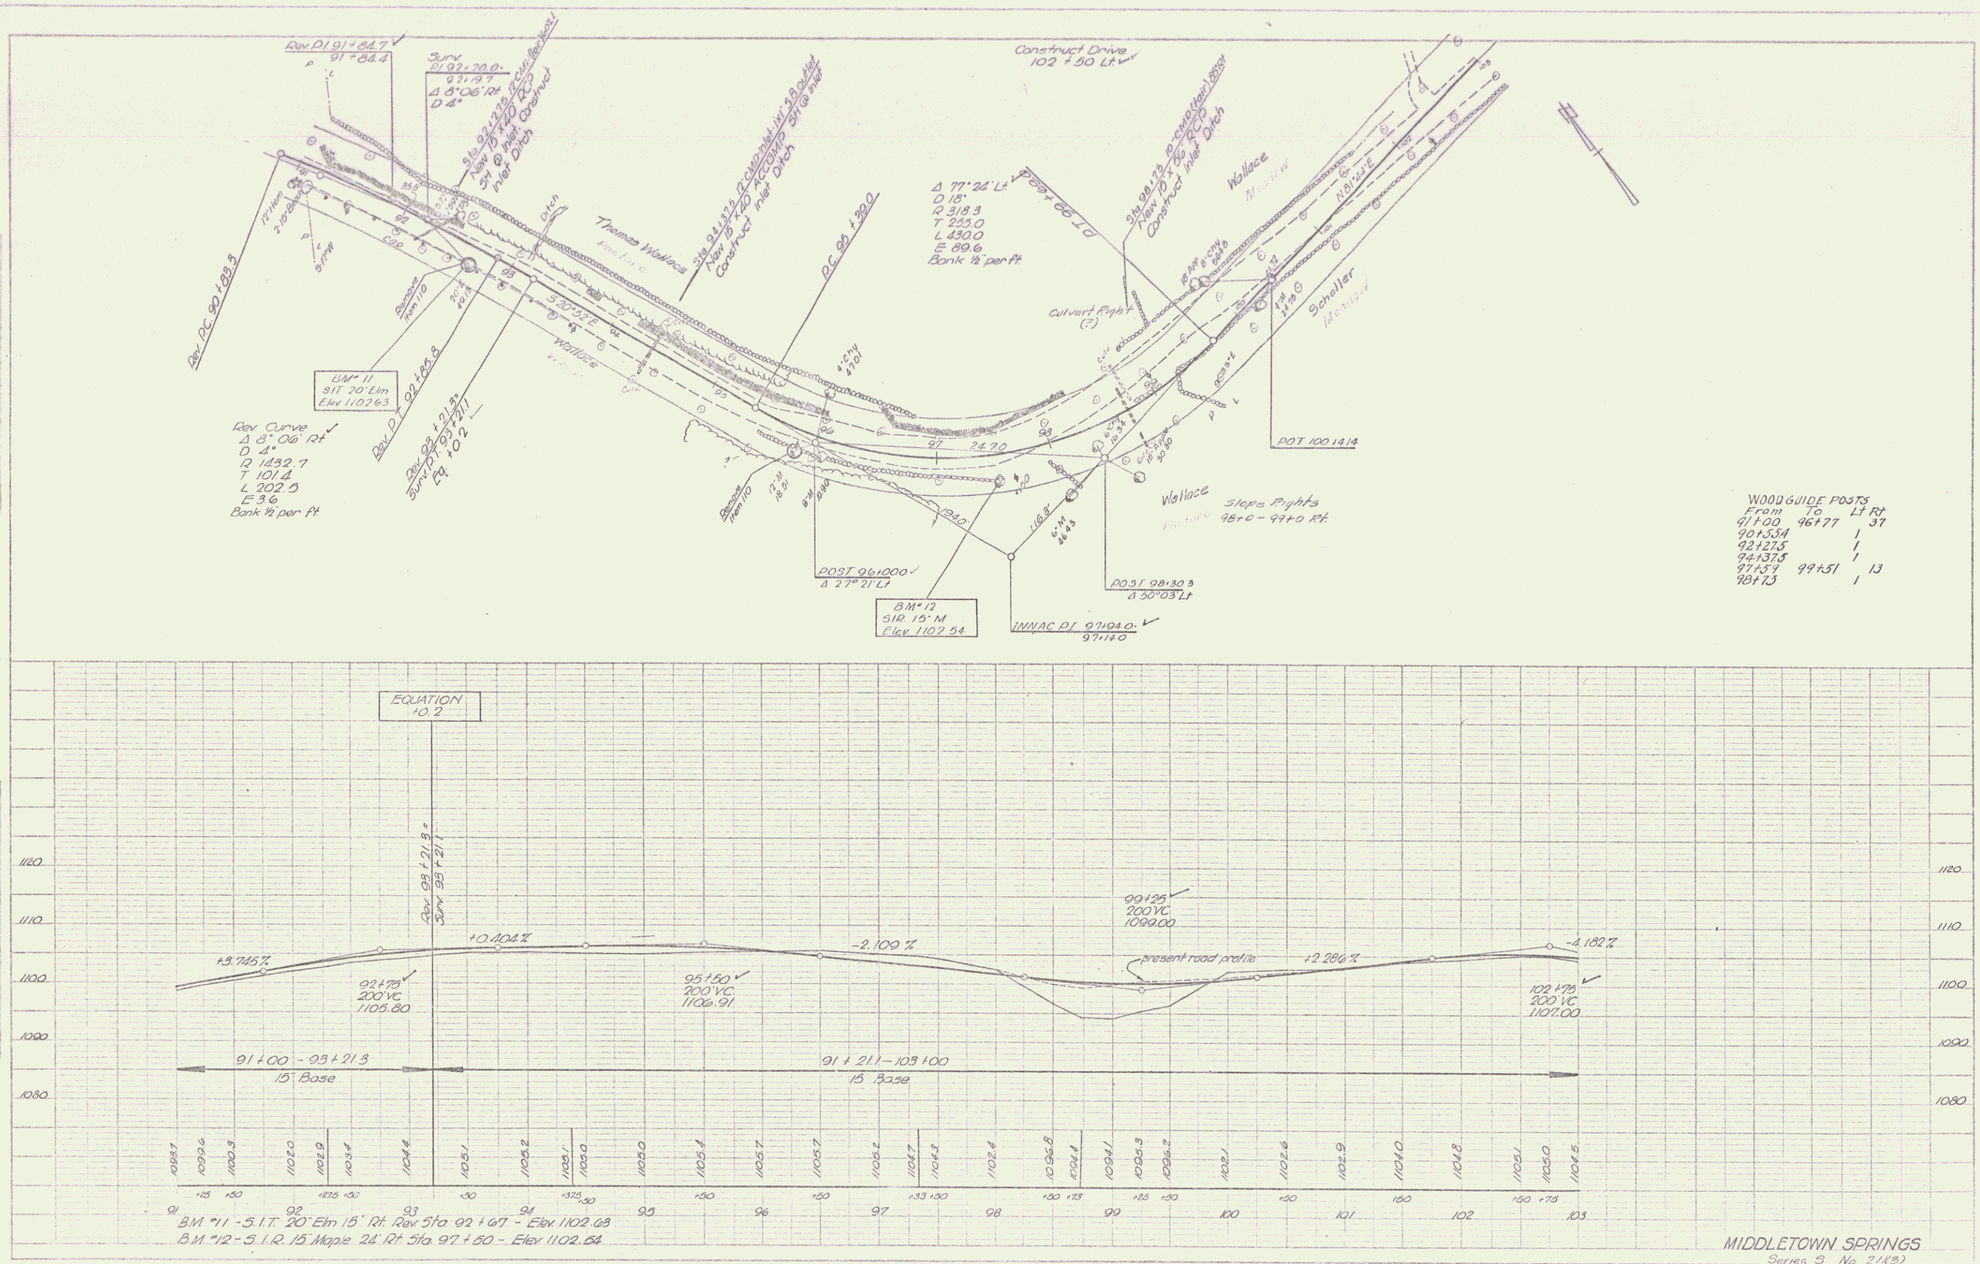

MIDDLETOWN SPRINGS
Series 9 No. 21(3)
Sheet 11 of 28

3