WOOD GUIDE POSTS
LT 331+00 - 335+25
RT 345+24 - 347+00

CONSTRUCT DRIVES
LT 340+0
RT 340+25

TWO CABLE GUARD RAIL
LT. ~~334+00 - 335+50~~ ~~343+00 - 345+56~~
RT. ~~340+50 - 347+00~~

REMOVAL & DISPOSAL OF PRESENT GUARD RAIL
LT.
RT. 340+60' - 342+96'

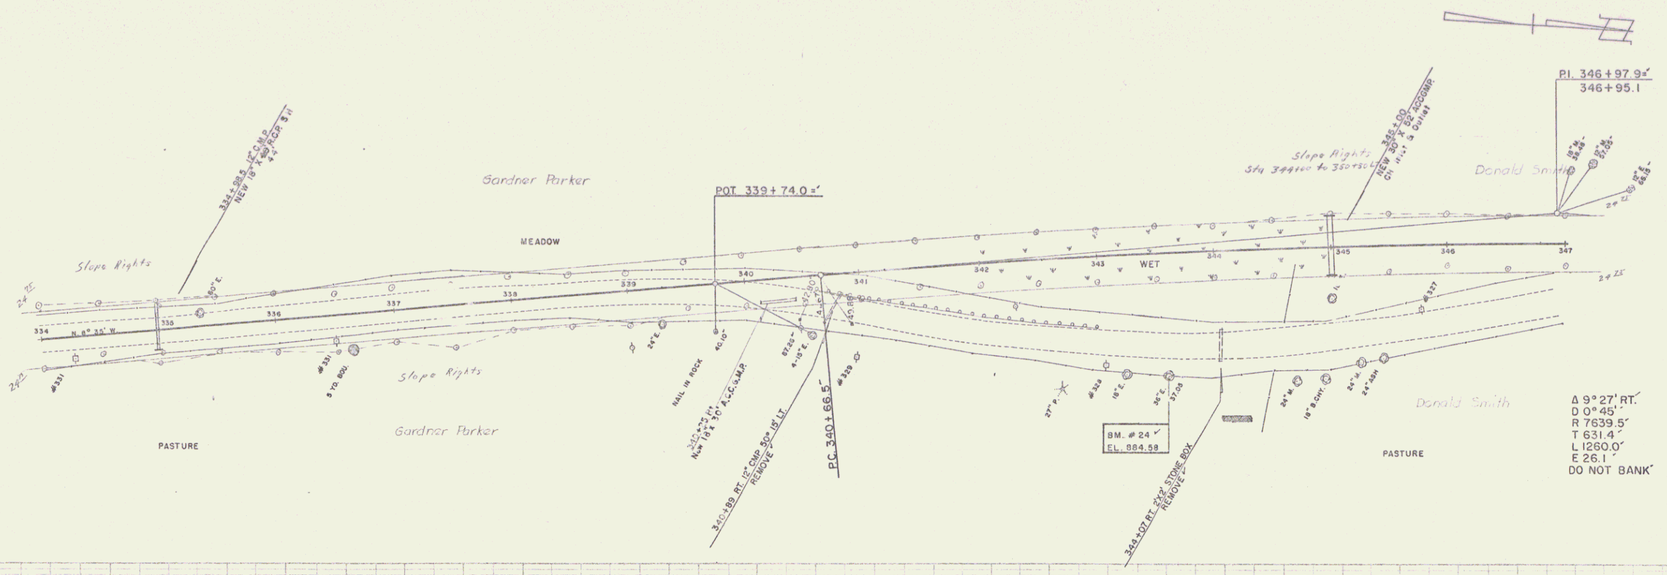

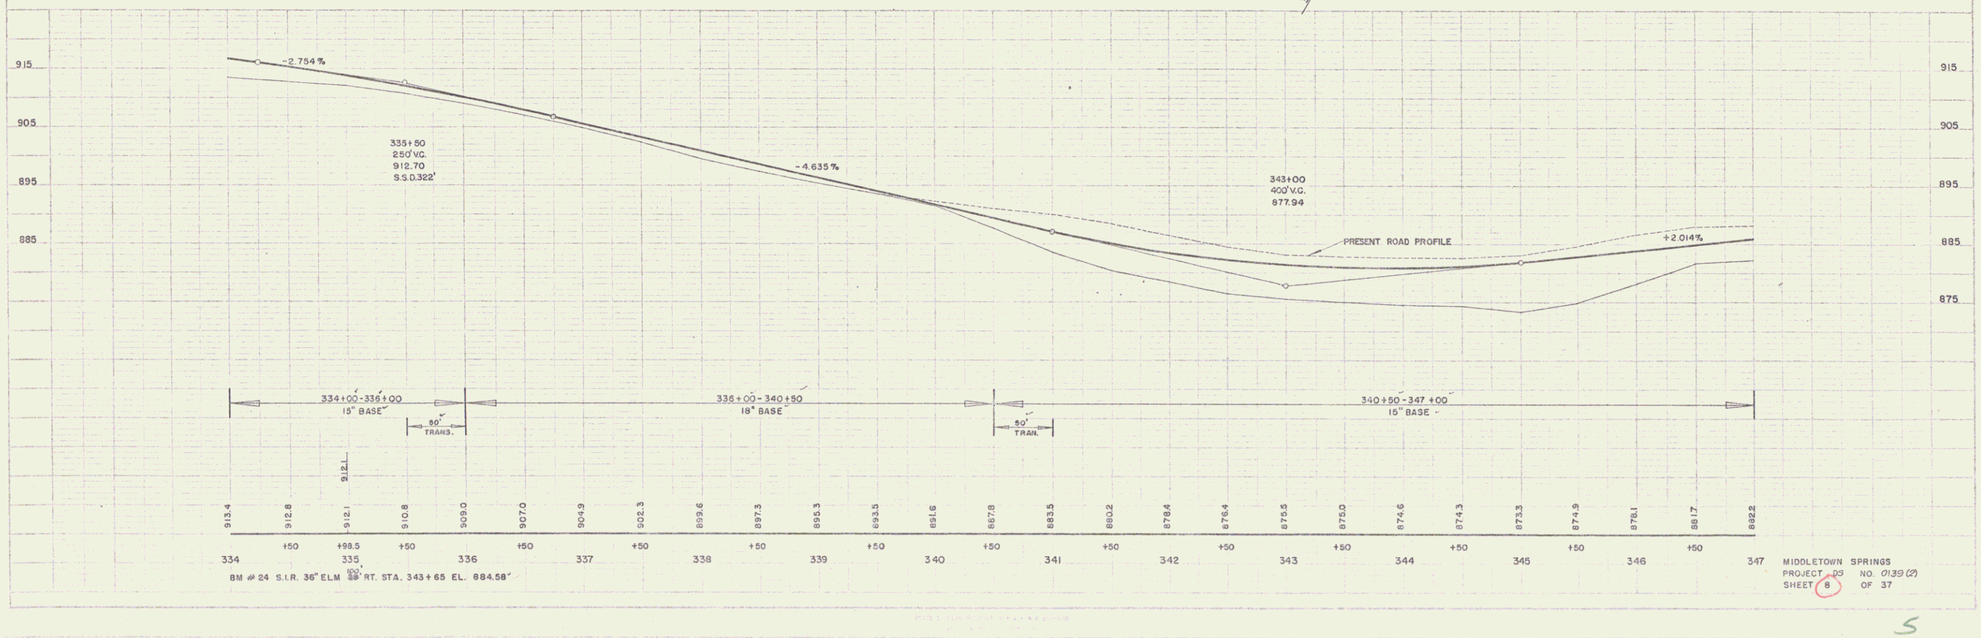

MIDDLETOWN SPRINGS
PROJECT D3 NO. 0139 (2)
SHEET 8 OF 37

5