FED. ROAD DIV.	STATE	ROUTE NO.	PROJECT NO.	FISCAL YEAR	SHEET NO.	TOTAL SHEETS
1	VT		WPSO 211A	1936	6	16

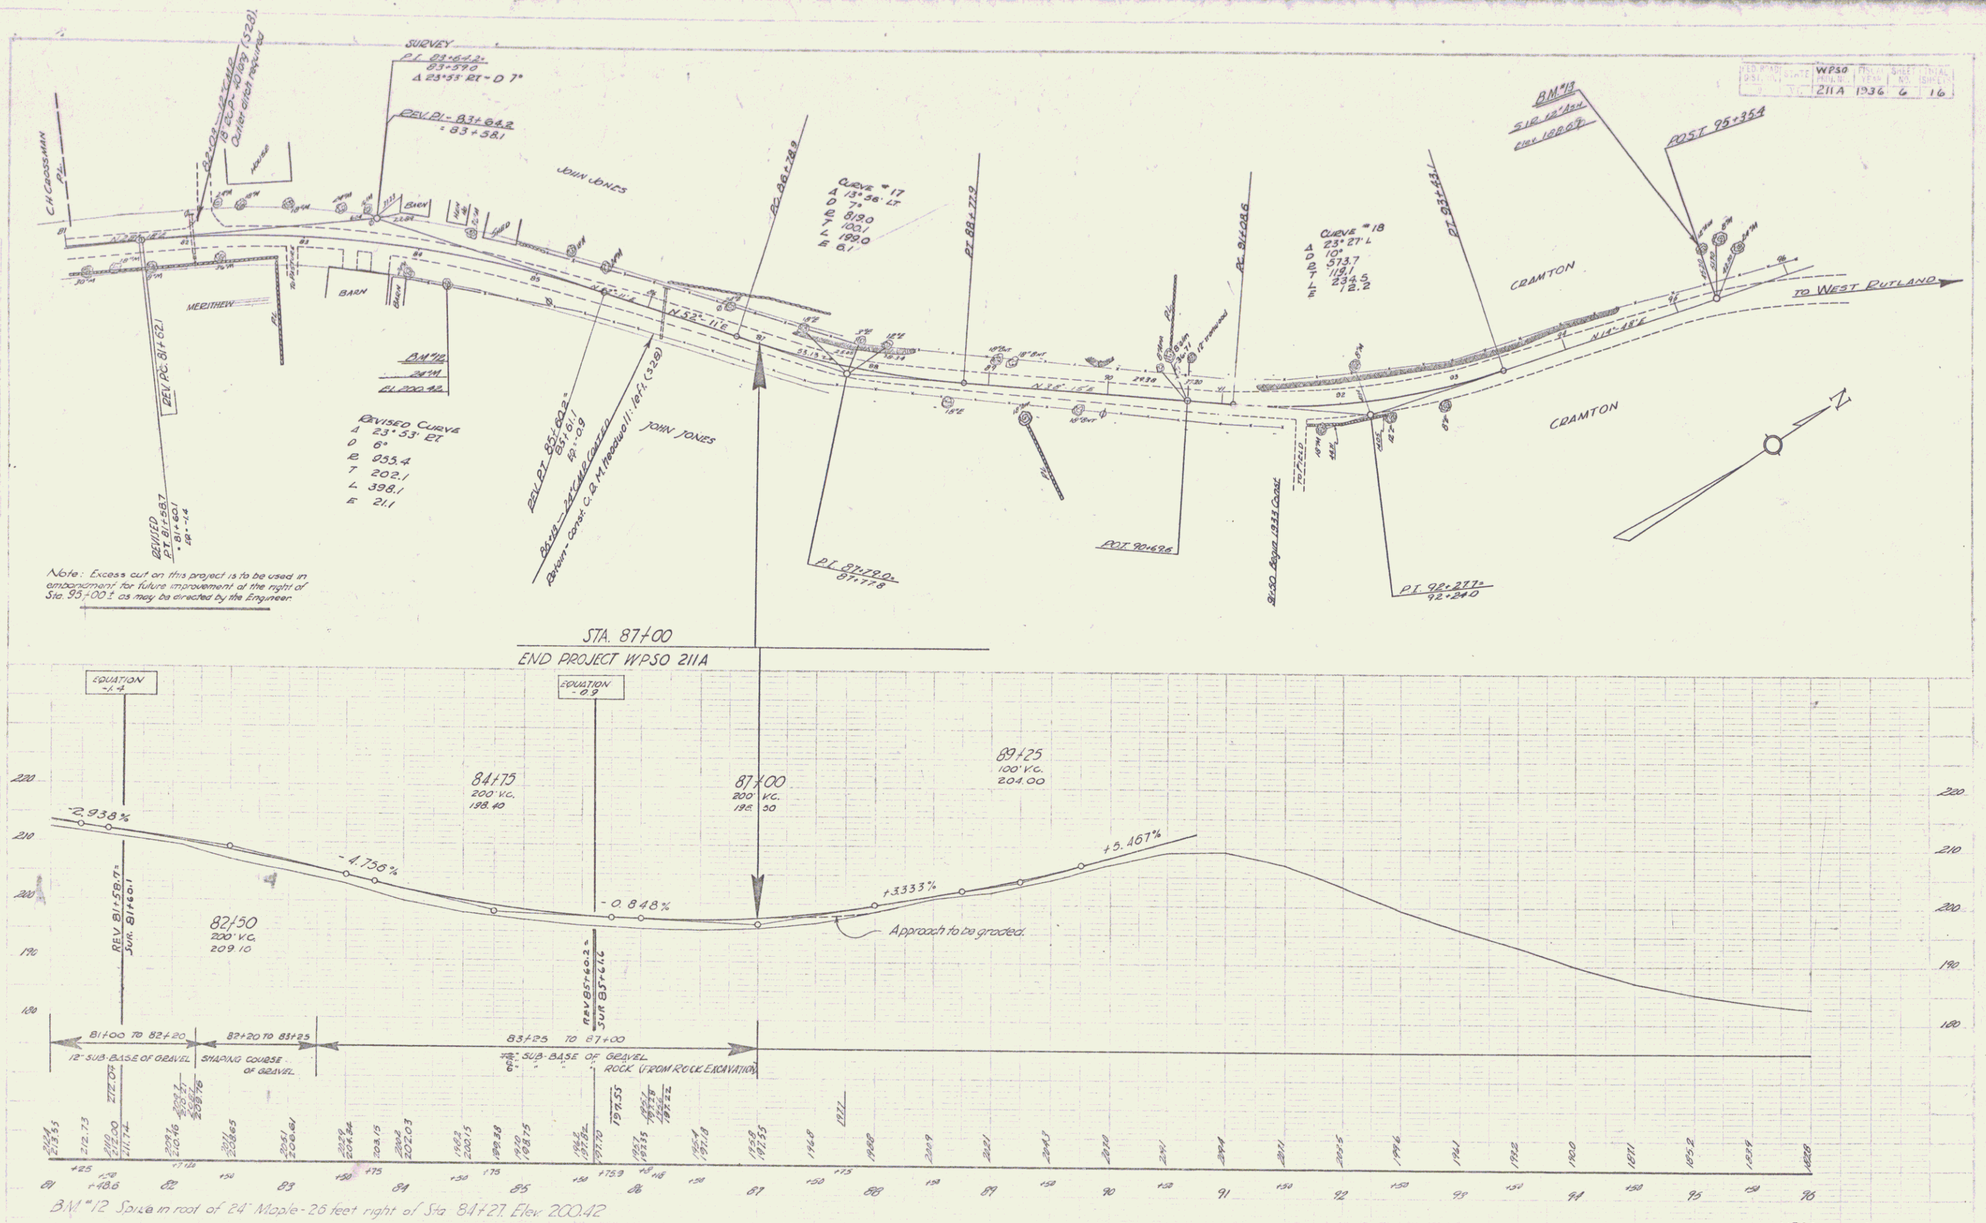

SERIES WPSO No 211A
SHEET 6 OF 16

4