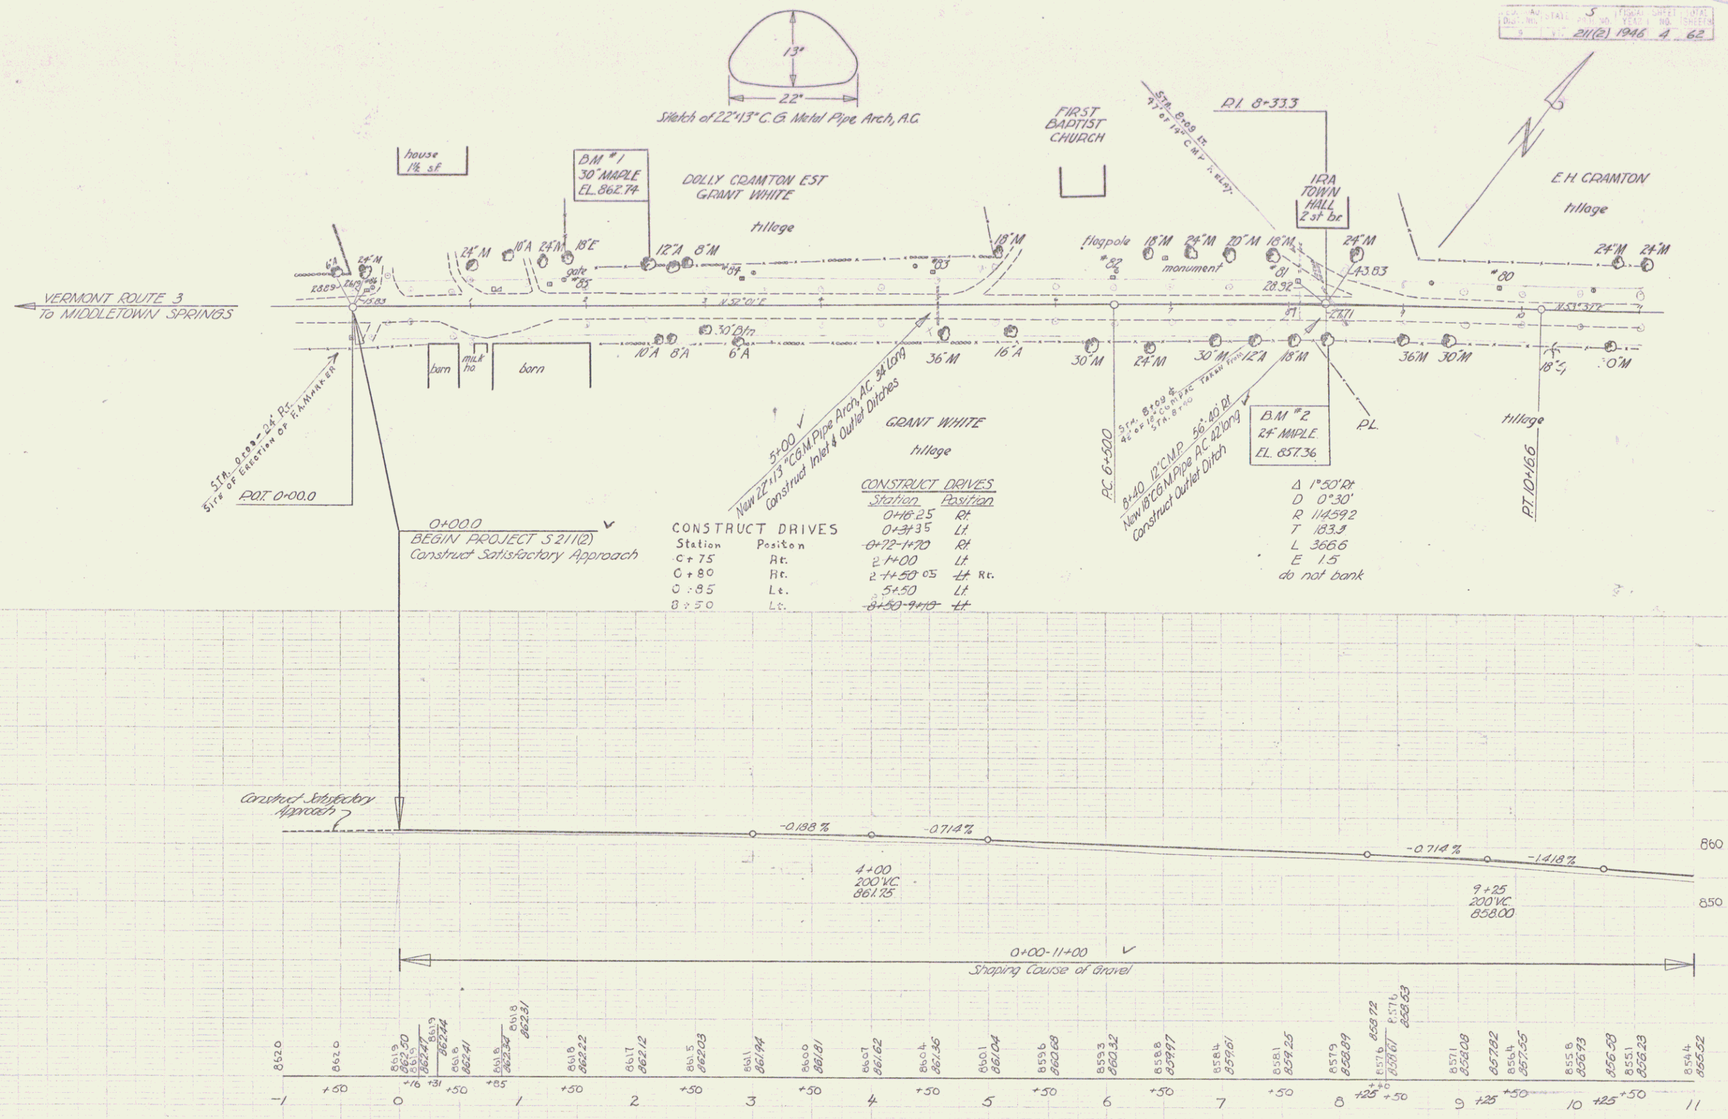
S 211(2) 1946 4 62
13"
22"
Sketch of 22"x13" C.G. Metal Pipe Arch, A.C.
house 1½ st.
B.M. #1 30" MAPLE EL. 862.74
DOLLY CRAMTON EST
GRANT WHITE
tillage
FIRST BAPTIST CHURCH
P.I. 8+33.3
IRA TOWN HALL 2 st. br
E.H. CRAMTON
tillage
VERMONT ROUTE 3 TO MIDDLETOWN SPRINGS
flagpole
monument
barn
milk ho
barn
P.O.T. 0+00.0
0+00.0
BEGIN PROJECT S 211(2)
Construct Satisfactory Approach
5+00
New 22"x13" C.G.M. Pipe Arch, AC 34' long
Construct Inlet & Outlet Ditches
GRANT WHITE
tillage
P.C. 6+50
B.M. #2 24" MAPLE EL. 857.36
P.I.
tillage
P.T. 10+66
Δ 1°50' Rt.
D 0°30'
R 1145.92
T 18.33
L 36.66
E 1.5
do not bank
CONSTRUCT DRIVES
Station Position
0+75 Rt.
0+80 Rt.
0+85 Lt.
8+50 Lt.
CONSTRUCT DRIVES
Station Position
0+16.25 Rt
0+31.35 Lt
~~0+72-1+70~~ Rt
2+00 Lt
2+50.05 Lt Rt.
5+50 Lt
~~8+50-9+10~~ Lt
Construct Satisfactory Approach
-0.188%
-0.714%
-0.714%
-1.418%
4+00 200' VC 861.75
9+25 200' VC 858.00
860
850
0+00-11+00
Shaping Course of Gravel
BM #1 S.I.R. 30" Maple 31' Lt. Sta. 2+51 El. 862.74
BM #2 S.I.R. 24" Maple 26.5' Rt. Sta. 8+33 El. 857.36
IRA-CLARENDON S 211(2)
sheet 4 of 62 sheets

2