FED. ROAD DIST. NO.	STATE	PROJ. NO.	FISCAL YEAR	SHEET NO.	TOTAL SHEETS
9	VA.	211(2)	1946	14	62

CONSTRUCT DRIVES

Station	Position
144+15.10	Rt.
~~147+40-147+80~~	~~Rt.~~
~~148+92-150+30~~	~~Rt.~~
151+75.00	Rt.
154+80.50	Rt.
~~155+75~~	~~Lt.~~
157+88.50	Lt. & Rt.
~~158+33.5~~	~~Rt.~~
159+00	Rt.
159+68.50	Rt.

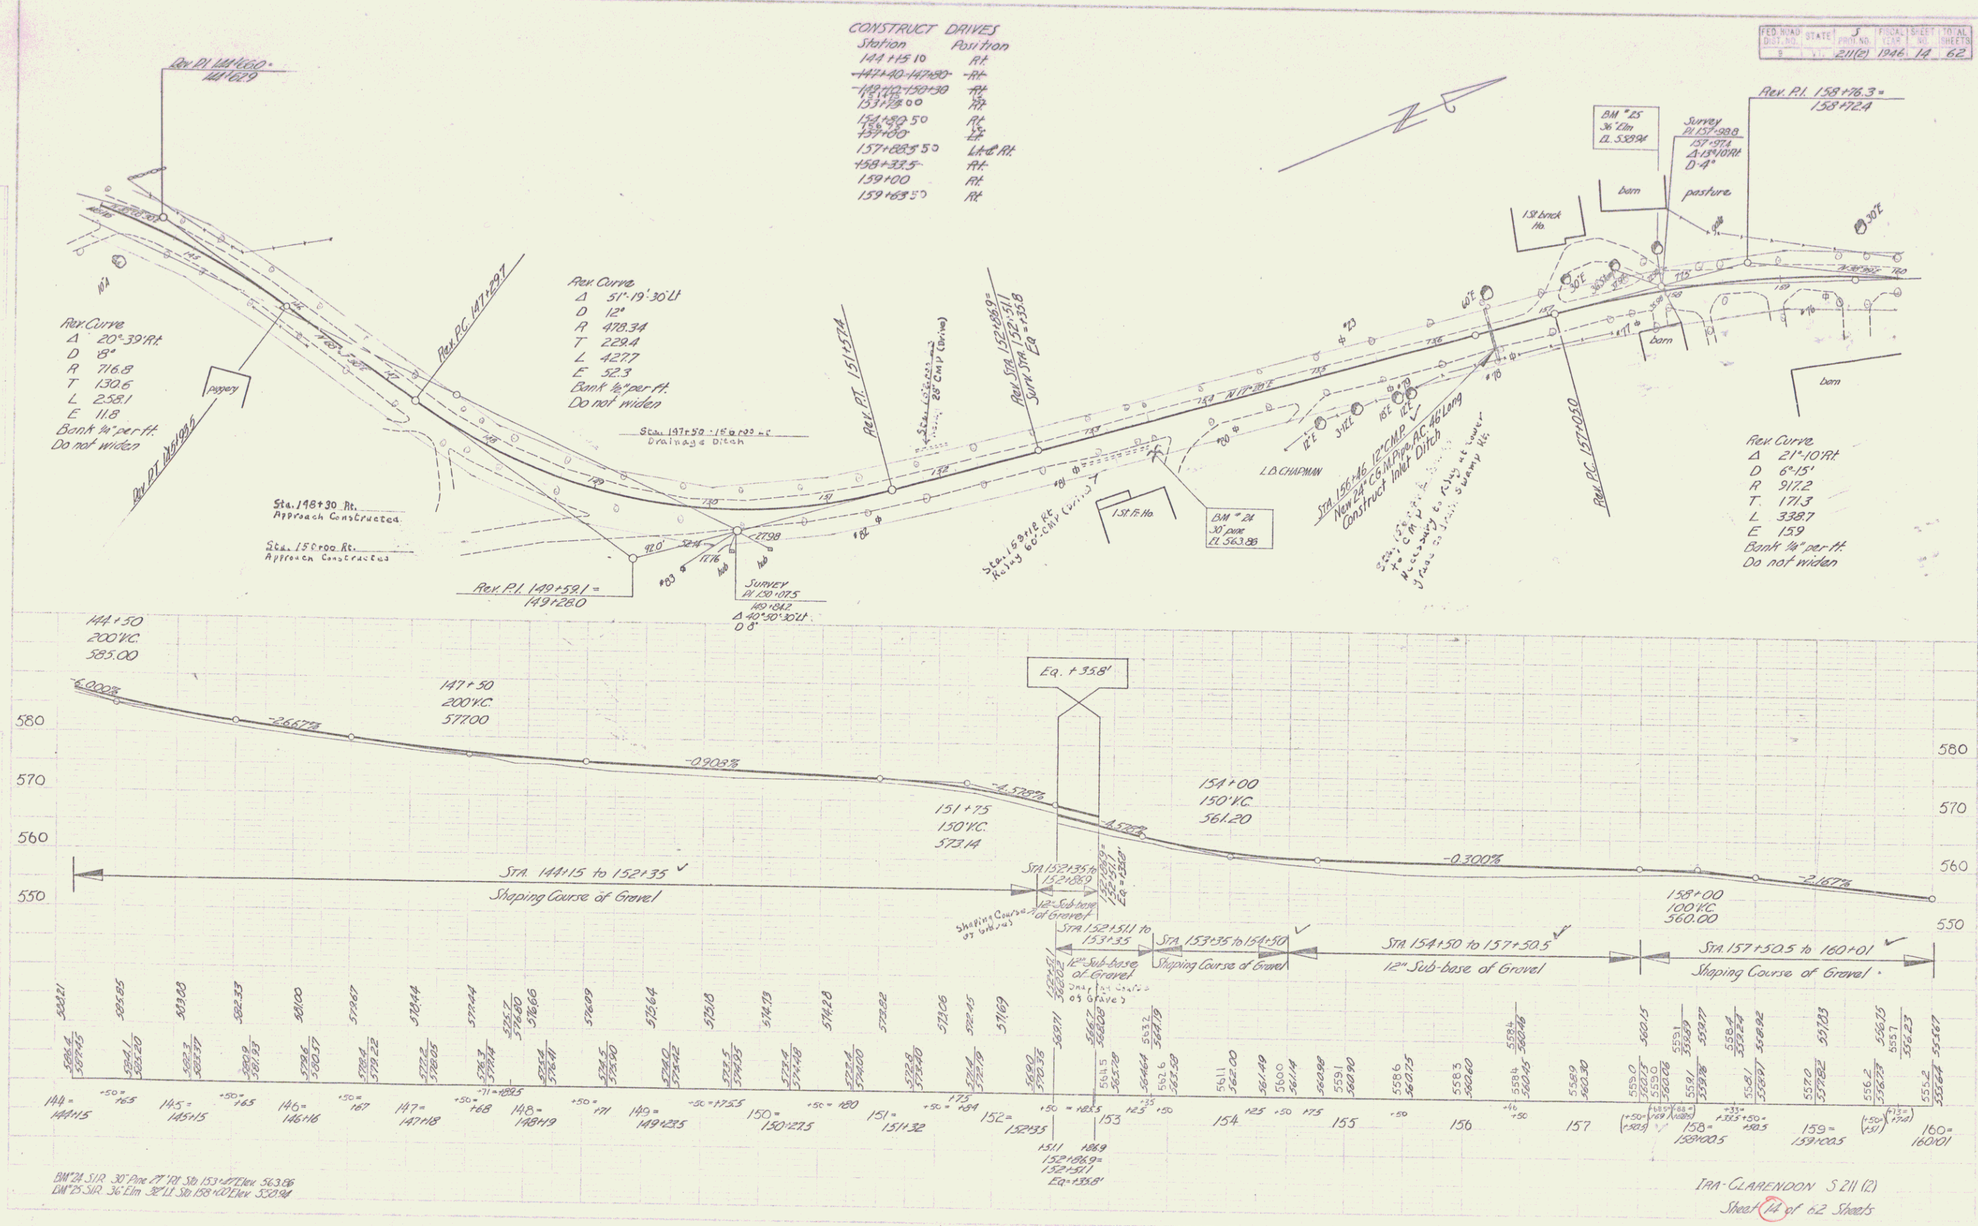


Sheet 14 of 62 Sheets

12