F.P. ROAD DIST. NO.	STATE	FED. AID PROJ. NO.	FISCAL YEAR	SHEET NO.	TOTAL SHEETS
9	VT.	211(2)	1946	15	62

CONSTRUCT DRIVES

Sta.	Posit.
163+60	Lt.
175+60	Lt.
178+60	Rt.

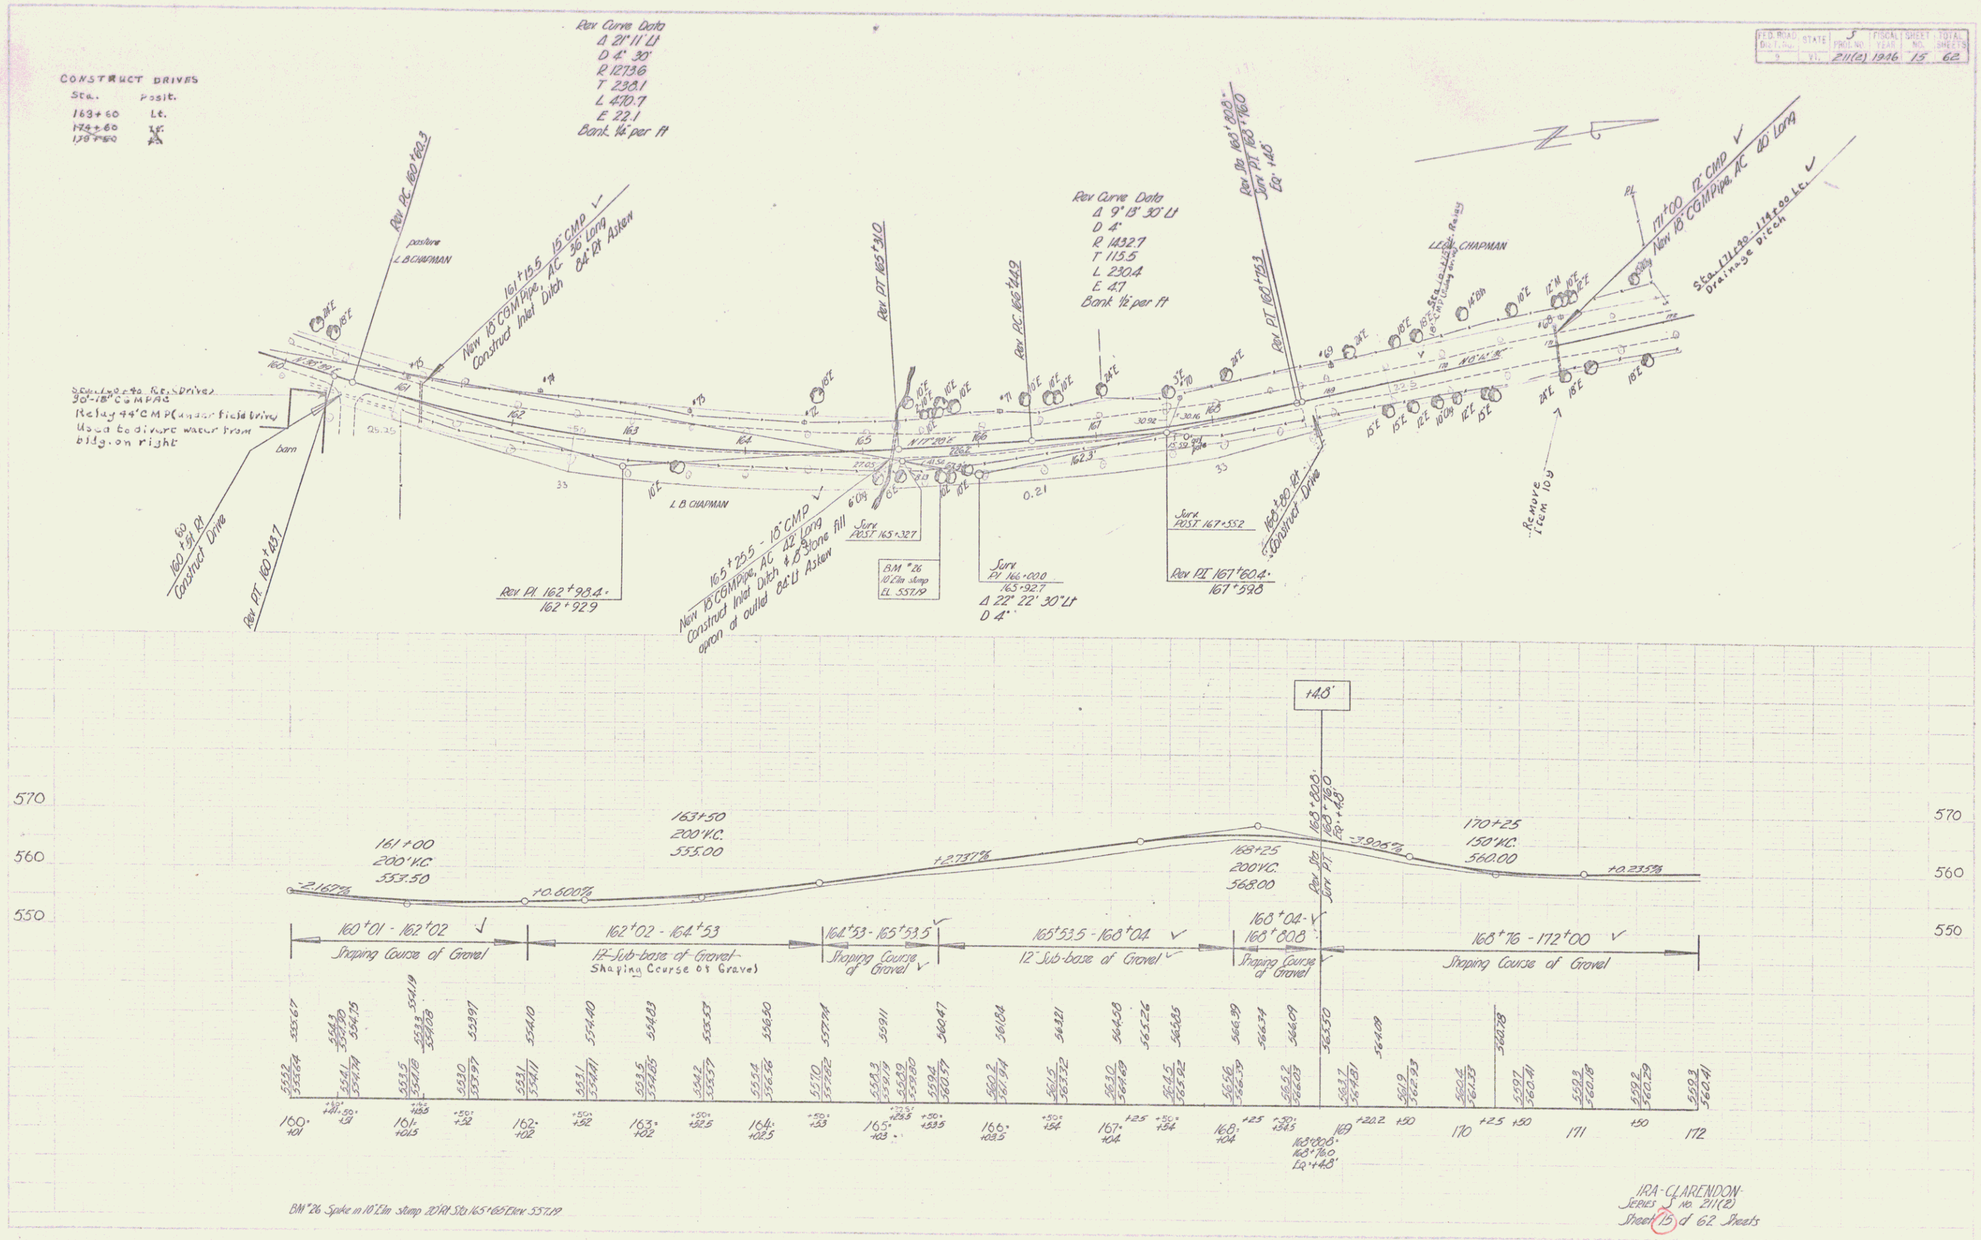

BM #26 Spike in 10" Elm stump 20' Rt. Sta. 165+65 Elev. 557.19

IRA-CLARENDON
Series J No. 211(2)
Sheet 15 of 62 Sheets