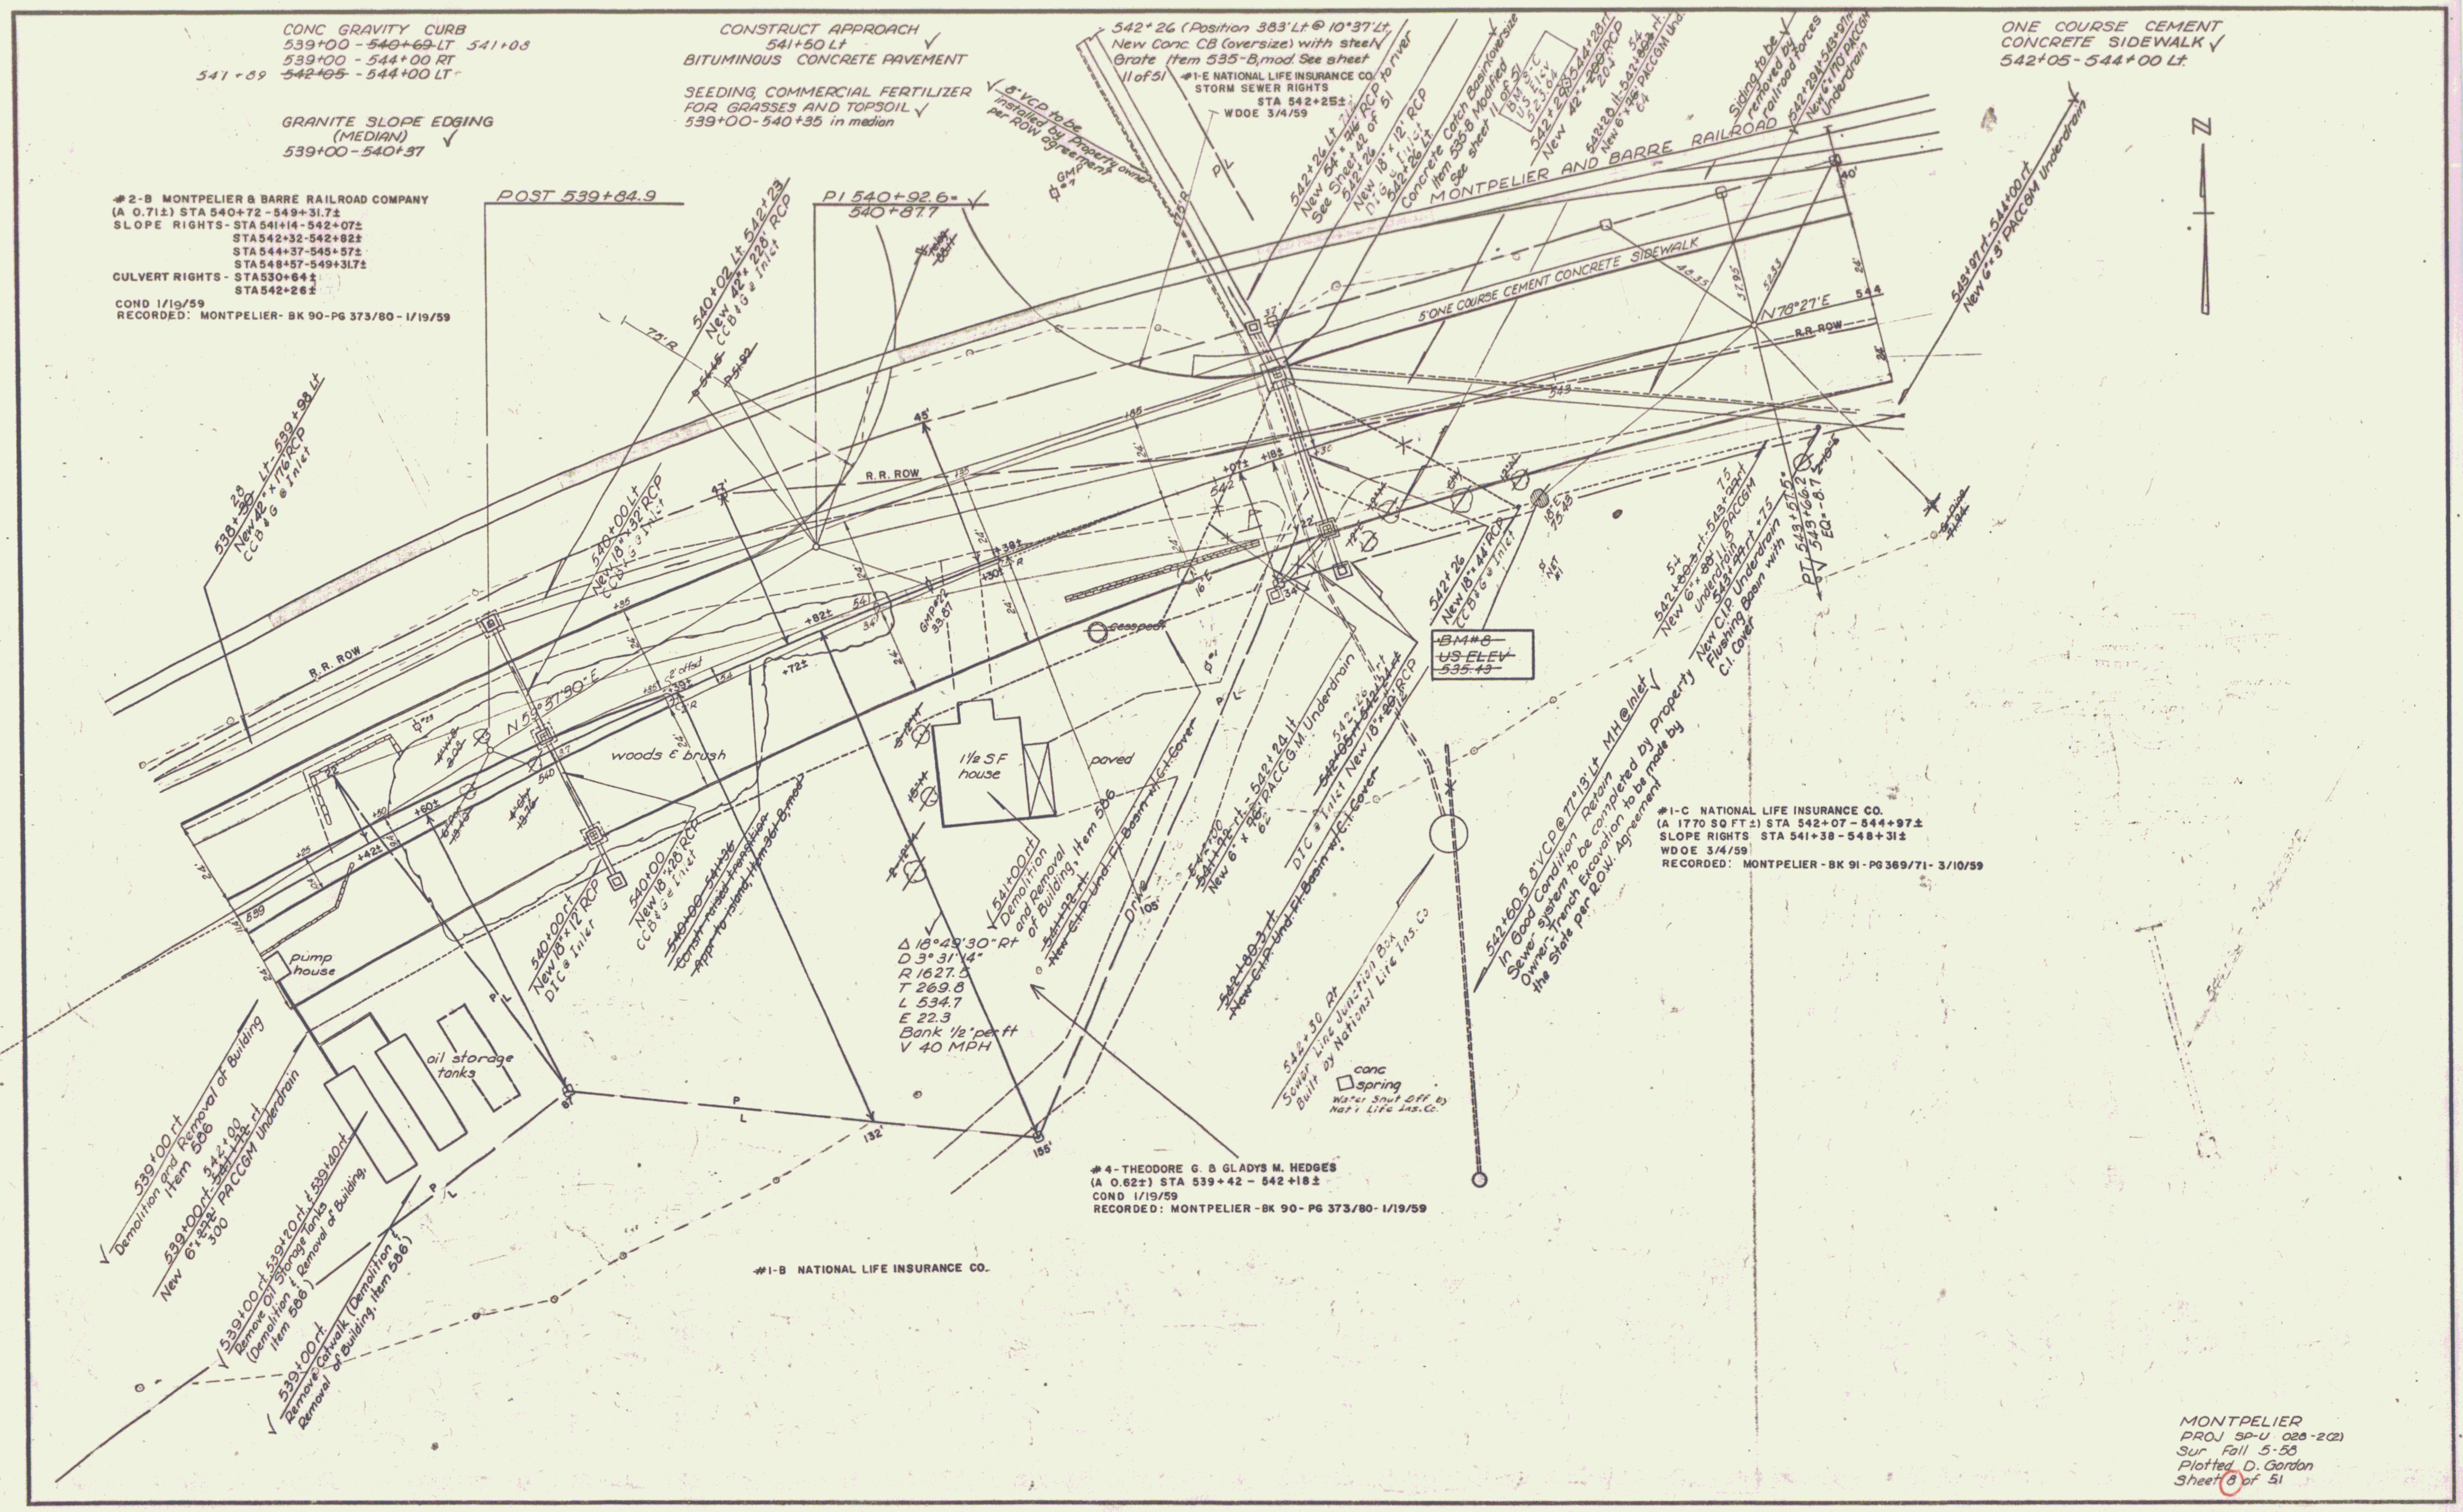
CONC GRAVITY CURB
539+00 - 540+69 LT 541+08
539+00 - 544+00 RT
541+89 542+05 - 544+00 LT
GRANITE SLOPE EDGING
(MEDIAN)
539+00 - 540+37
CONSTRUCT APPROACH
541+50 Lt
BITUMINOUS CONCRETE PAVEMENT
SEEDING, COMMERCIAL FERTILIZER
FOR GRASSES AND TOPSOIL
539+00 - 540+35 in median
8" VCP to be installed by Property owner per ROW agreement
542+26 (Position 383' Lt @ 10°37' Lt.
New Conc. CB (oversize) with steel
Grate Item 535-B, mod. See sheet
11 of 51
#1-E NATIONAL LIFE INSURANCE CO.
STORM SEWER RIGHTS
STA 542+25±
WDOE 3/4/59
ONE COURSE CEMENT
CONCRETE SIDEWALK
542+05 - 544+00 Lt.
#2-B MONTPELIER & BARRE RAILROAD COMPANY
(A 0.71±) STA 540+72 - 549+31.7±
SLOPE RIGHTS - STA 541+14 - 542+07±
STA 542+32 - 542+82±
STA 544+37 - 545+57±
STA 548+57 - 549+31.7±
CULVERT RIGHTS - STA 530+64±
STA 542+26±
COND 1/19/59
RECORDED: MONTPELIER - BK 90 - PG 373/80 - 1/19/59
POST 539+84.9
PI 540+92.6 = 540+87.7
540+02 Lt. 542+23 New 42" x 228' RCP CCB & G2 Inlet
MONTPELIER AND BARRE RAILROAD
Siding to be removed by railroad forces
5' ONE COURSE CEMENT CONCRETE SIDEWALK
R.R. ROW
woods & brush
1½ SF house
paved
pump house
oil storage tanks
Δ 18°49'30" Rt
D 3°31'14"
R 1627.5
T 269.8
L 534.7
E 22.3
Bank ½" per ft
V 40 MPH
541+00 rt Demolition and Removal of Building, Item 506
BM #8 US ELEV 535.43
542+60.5 8" VCP @ 77°13' Lt MH @ Inlet
In Good Condition Retain
Sewer system to be completed by Property
Owner - Trench Excavation to be made by
the State per R.O.W. Agreement
542+30 Rt Sewer Line Junction Box Built by National Life Ins. Co
conc spring
Water Shut Off by Nat'l Life Ins. Co.
539+00 rt Demolition and Removal of Building Item 506
#1-C NATIONAL LIFE INSURANCE CO.
(A 1770 SQ FT±) STA 542+07 - 544+97±
SLOPE RIGHTS STA 541+38 - 548+31±
WDOE 3/4/59
RECORDED: MONTPELIER - BK 91 - PG 369/71 - 3/10/59
#4 - THEODORE G. & GLADYS M. HEDGES
(A 0.62±) STA 539+42 - 542+18±
COND 1/19/59
RECORDED: MONTPELIER - BK 90 - PG 373/80 - 1/19/59
#1-B NATIONAL LIFE INSURANCE CO.
MONTPELIER
PROJ SP-U 028-2(2)
Sur Fall 5-58
Plotted D. Gordon
Sheet 8 of 51