




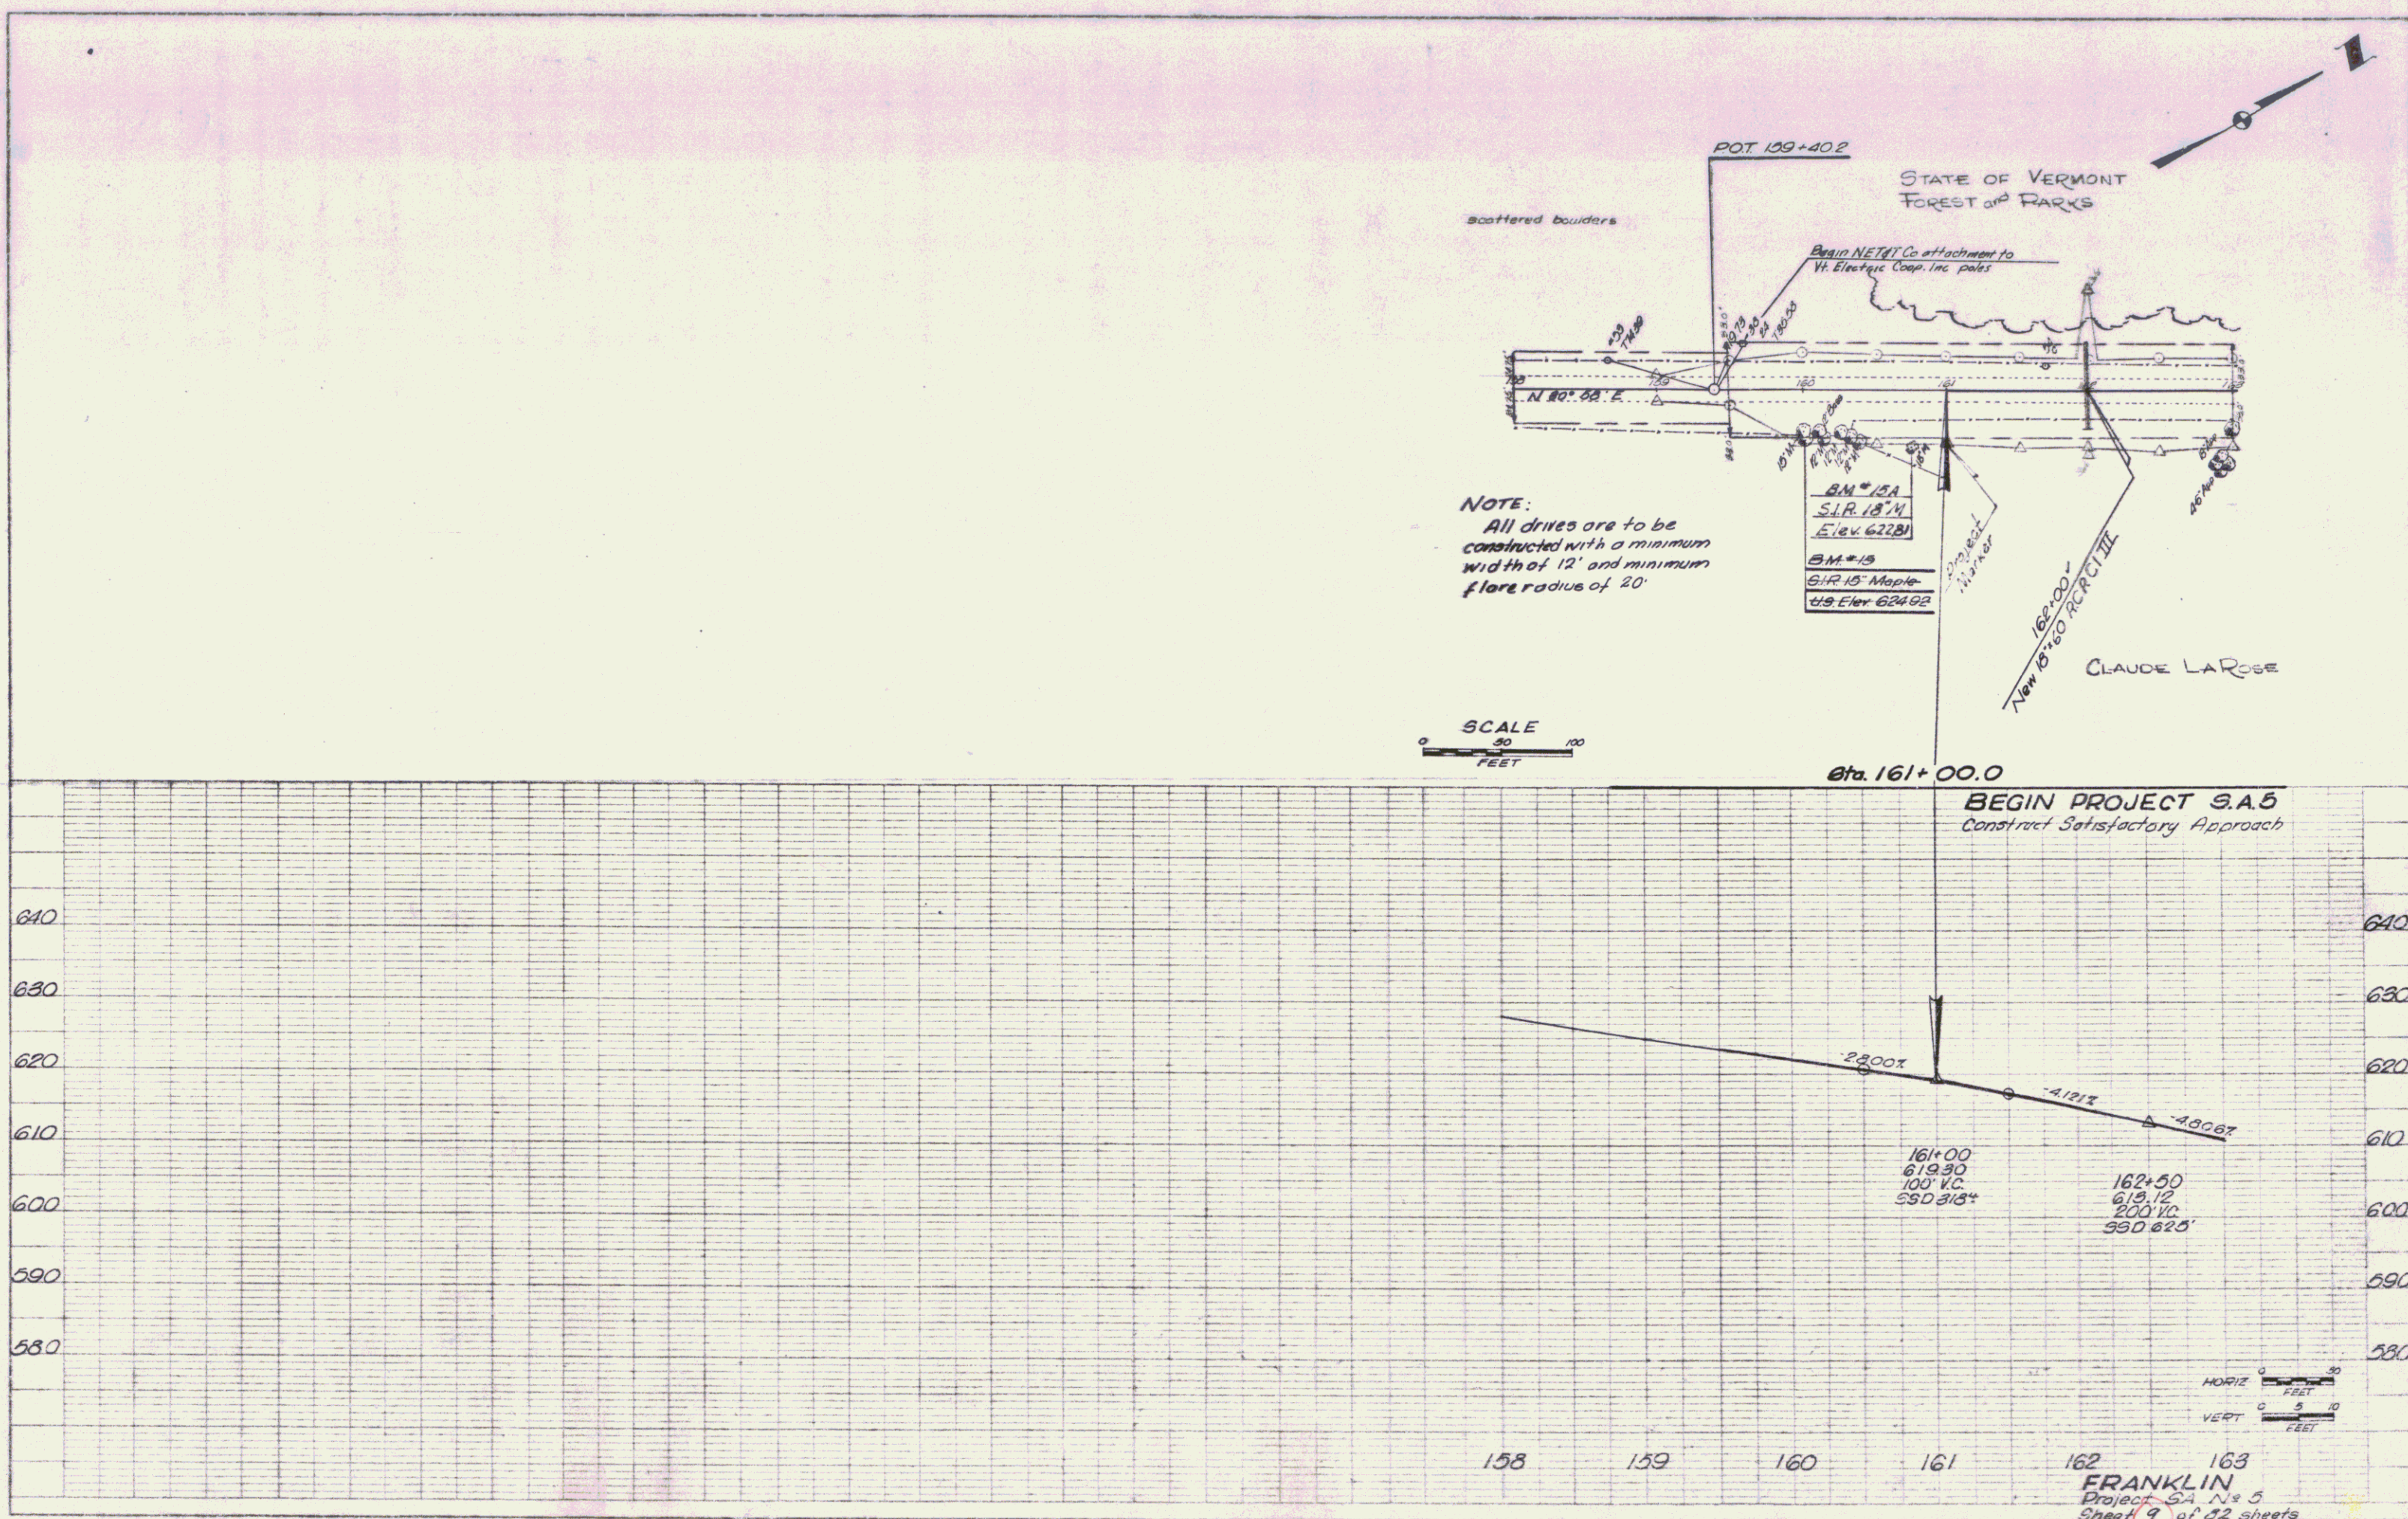

FRANKLIN
 Project SA No 5
 Sheet 9 of 22 sheets