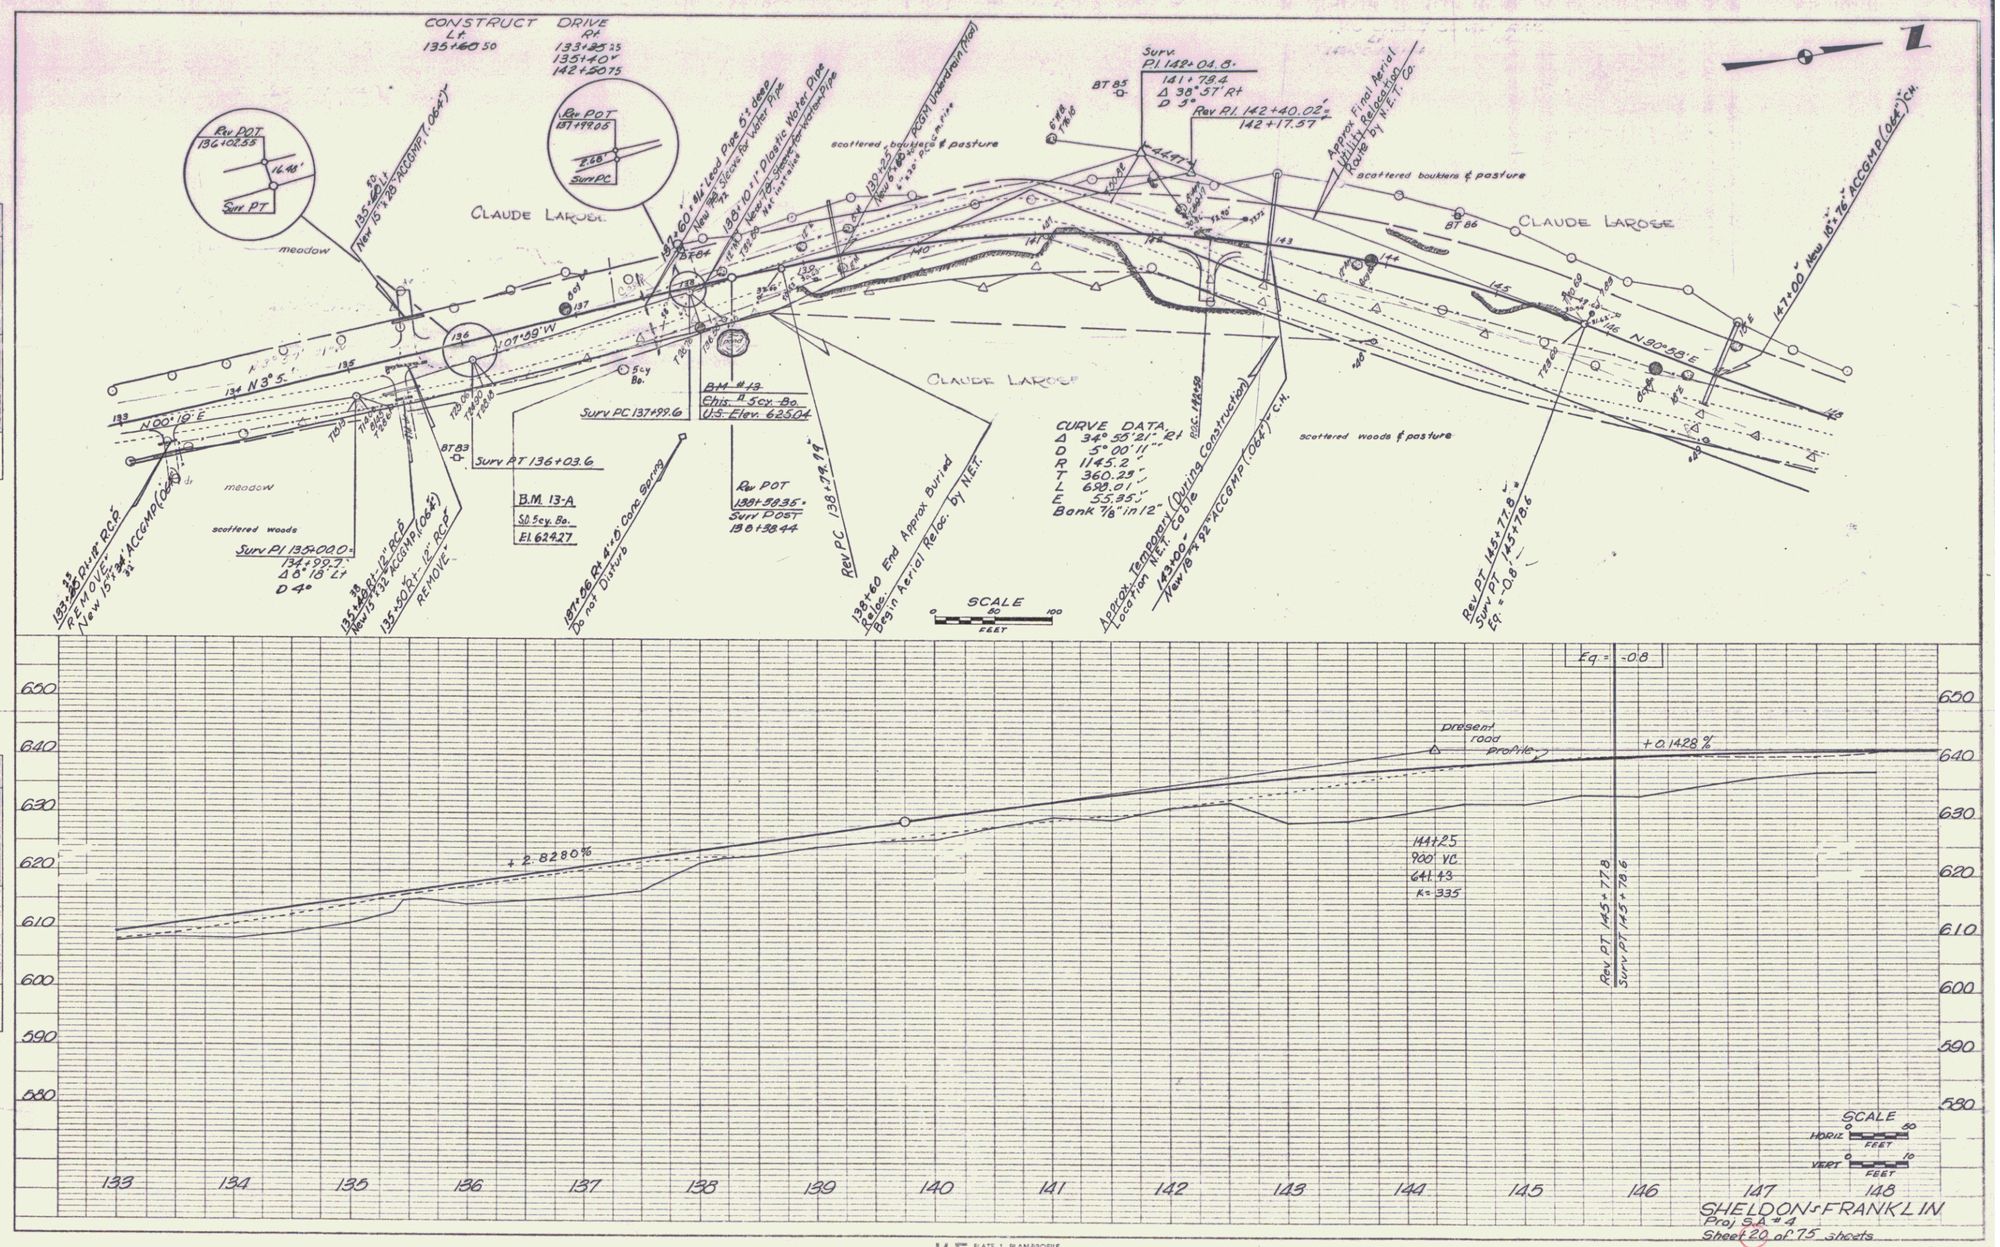

K+E PLATE 1, PLAN-PROFILE
KEUFFEL & ESSER CO.

40-7012 IMPERIAL™ TRACING CLOTH

10