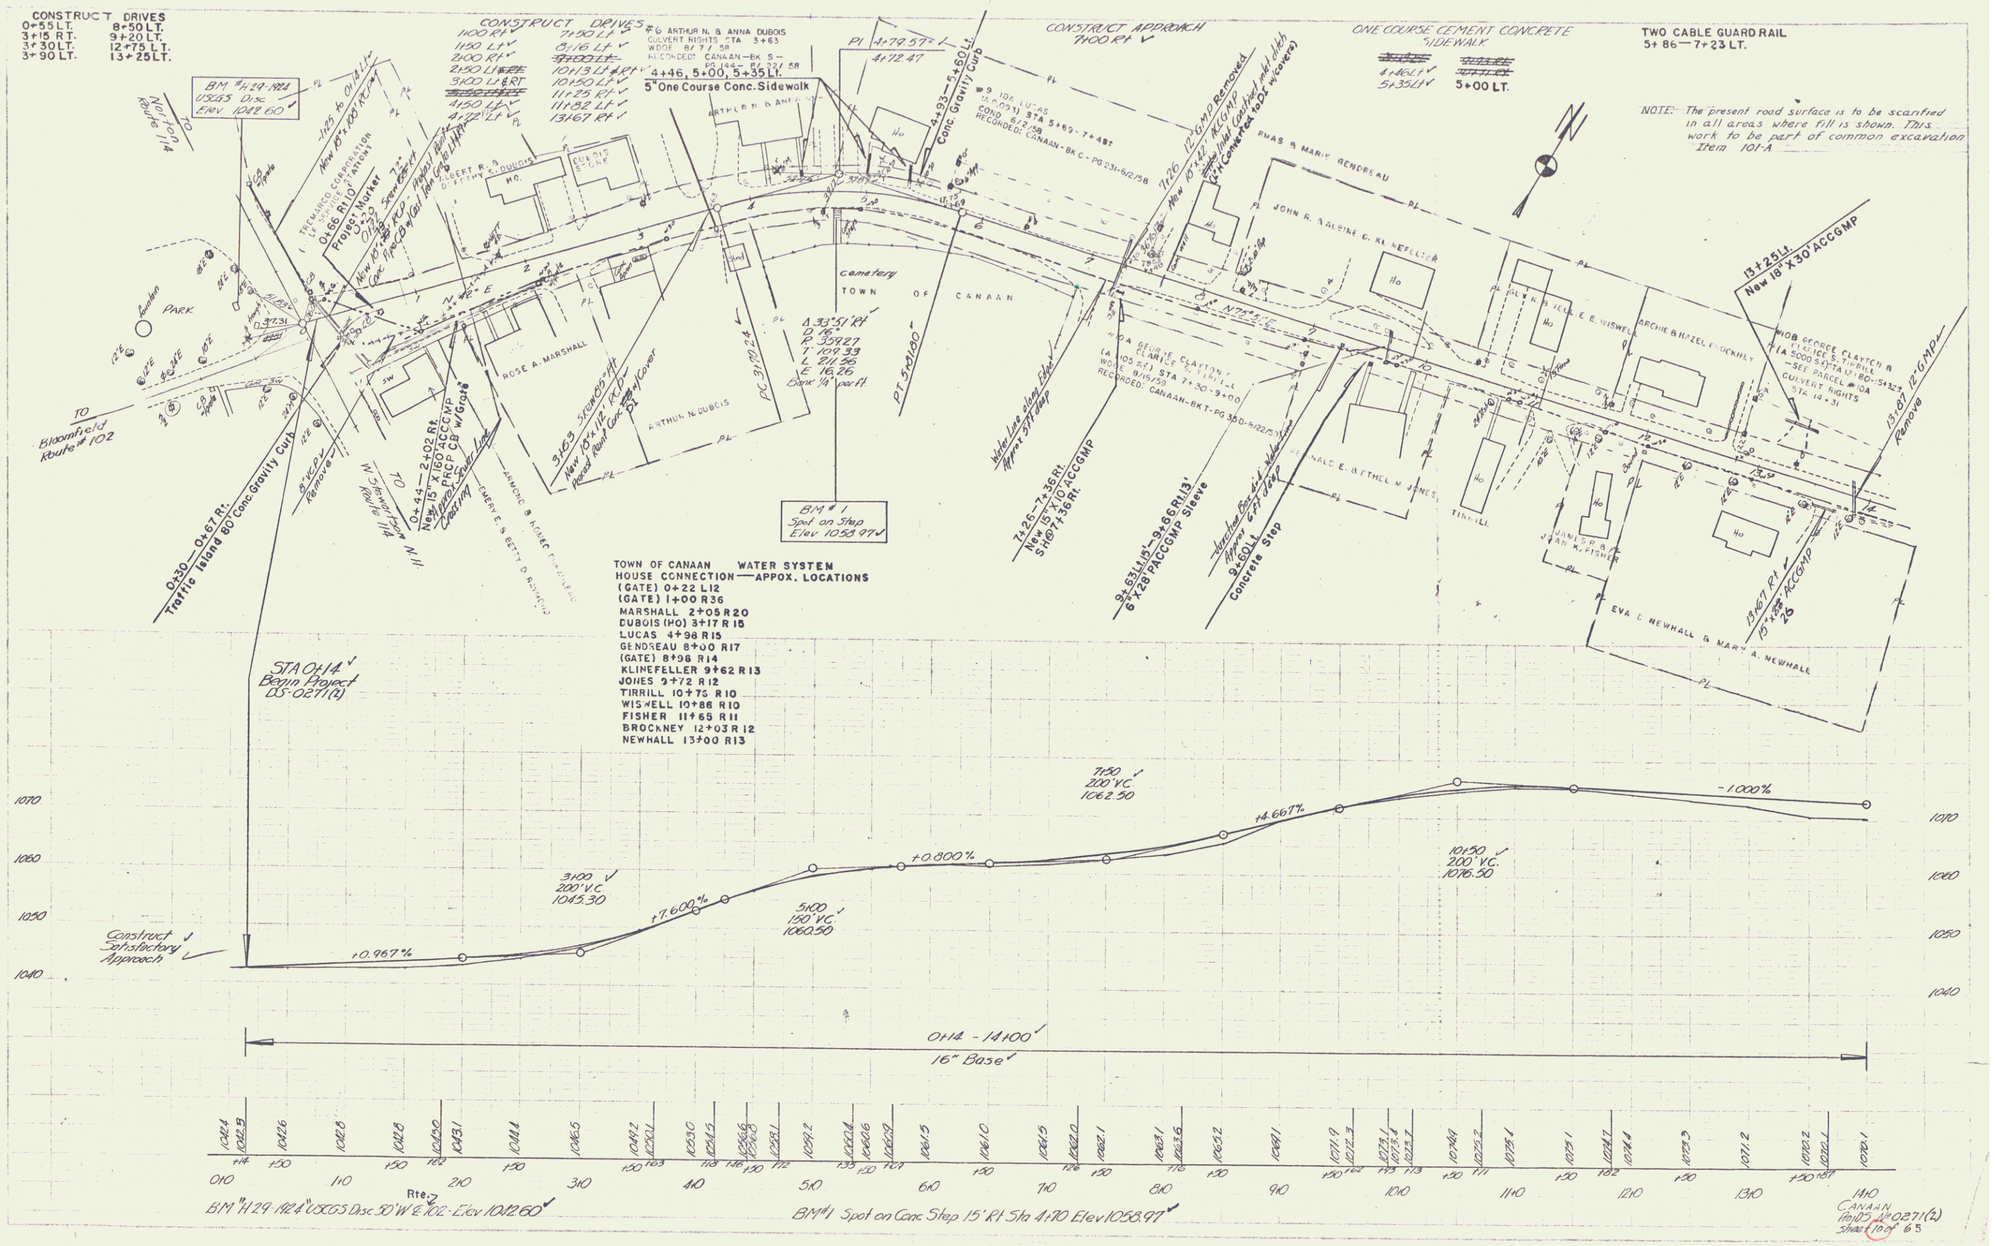
CONSTRUCT DRIVES
0+55 LT. 8+50 LT.
3+15 RT. 9+20 LT.
3+30 LT. 12+75 LT.
3+90 LT. 13+25 LT.
CONSTRUCT DRIVES
1100 RT
1150 LT
2100 RT
2150 LT
3100 LT & RT
4150 LT
4+72 LT
7+50 LT
8+16 LT
10+13 LT & RT
10+50 LT
11+29 RT
11+32 LT
13+67 RT
#6 ARTHUR N. & ANNA DUBOIS
CULVERT RIGHTS STA 3+63
WDOE 8/7/58
RECORDED: CANAAN-BK S-PG 144-8/27/58
4+46, 5+00, 5+35 LT.
5" One Course Conc. Sidewalk
PI 4+79.57
4+72.47
4+93—5+50 LT.
Conc. Gravity Curb
CONSTRUCT APPROACH
7+00 RT
ONE COURSE CEMENT CONCRETE SIDEWALK
4+46 LT
5+35 LT
5+00 LT.
TWO CABLE GUARD RAIL
5+86—7+23 LT.
NOTE: The present road surface is to be scarified in all areas where fill is shown. This work to be part of common excavation Item 101A
BM #1 29 1924
USGS Disc
Elev 1042.60
Norton Route 114
TO Bloomfield Route #102
PARK
Frost Market
OLGER RITTER
TREMARCO CORPORATION
ROSE A. MARSHALL
ARTHUR N. DUBOIS
cemetery
TOWN OF CANAAN
PT 5+01.90
Δ 33°51' Rt
D 16°
R 359.27
T 109.33
L 211.36
E 16.26
Back 14' out ft
BM #1
Spot on Step
Elev 1058.97
0+30—0+67 Rt.
Traffic Island 80' Conc. Gravity Curb
0+44—2+02 Rt.
New 15" X 160' ACCGMP
Rt. 102
W. Stewart Route 114
STA 0+14
Begin Project
OS-0271(2)
TOWN OF CANAAN WATER SYSTEM
HOUSE CONNECTION—APPOX. LOCATIONS
(GATE) 0+22 L12
(GATE) 1+00 R36
MARSHALL 2+05 R20
DUBOIS (PO) 3+17 R15
LUCAS 4+98 R15
GENDREAU 8+00 R17
(GATE) 8+98 R14
KLINEFELLER 9+62 R13
JONES 9+72 R12
TIRRILL 10+75 R10
WISWELL 10+86 R10
FISHER 11+65 R11
BROCKNEY 12+03 R12
NEWHALL 13+00 R13
7+26—7+36 Rt.
New 15" X 10' ACCGMP
Sta 6+7+36 Rt.
9+65 Lt. 15"—9+66 Rt. 13"
6' X 28' PACCGMP Sleeve
Concrete Step
13+25 Lt.
New 18" X 30' ACCGMP
13+01 12" GMP
Remove
13+67 Rt.
18" X 28' ACCGMP
Construct Satisfactory Approach
+0.967%
+7.600%
+0.800%
+4.667%
-1.000%
3+00 200' V.C. 1045.30
5+00 150' V.C. 1060.50
7+50 200' V.C. 1062.50
10+50 200' V.C. 1076.50
0+14 - 14+00
16" Base
BM #1 29 1924 USGS Disc 50' W & 102 - Elev 1042.60
BM #1 Spot on Conc Step 15' Rt Sta 4+90 Elev 1058.97
CANAAN
FM OS-0271(2)
Sheet 10 of 65