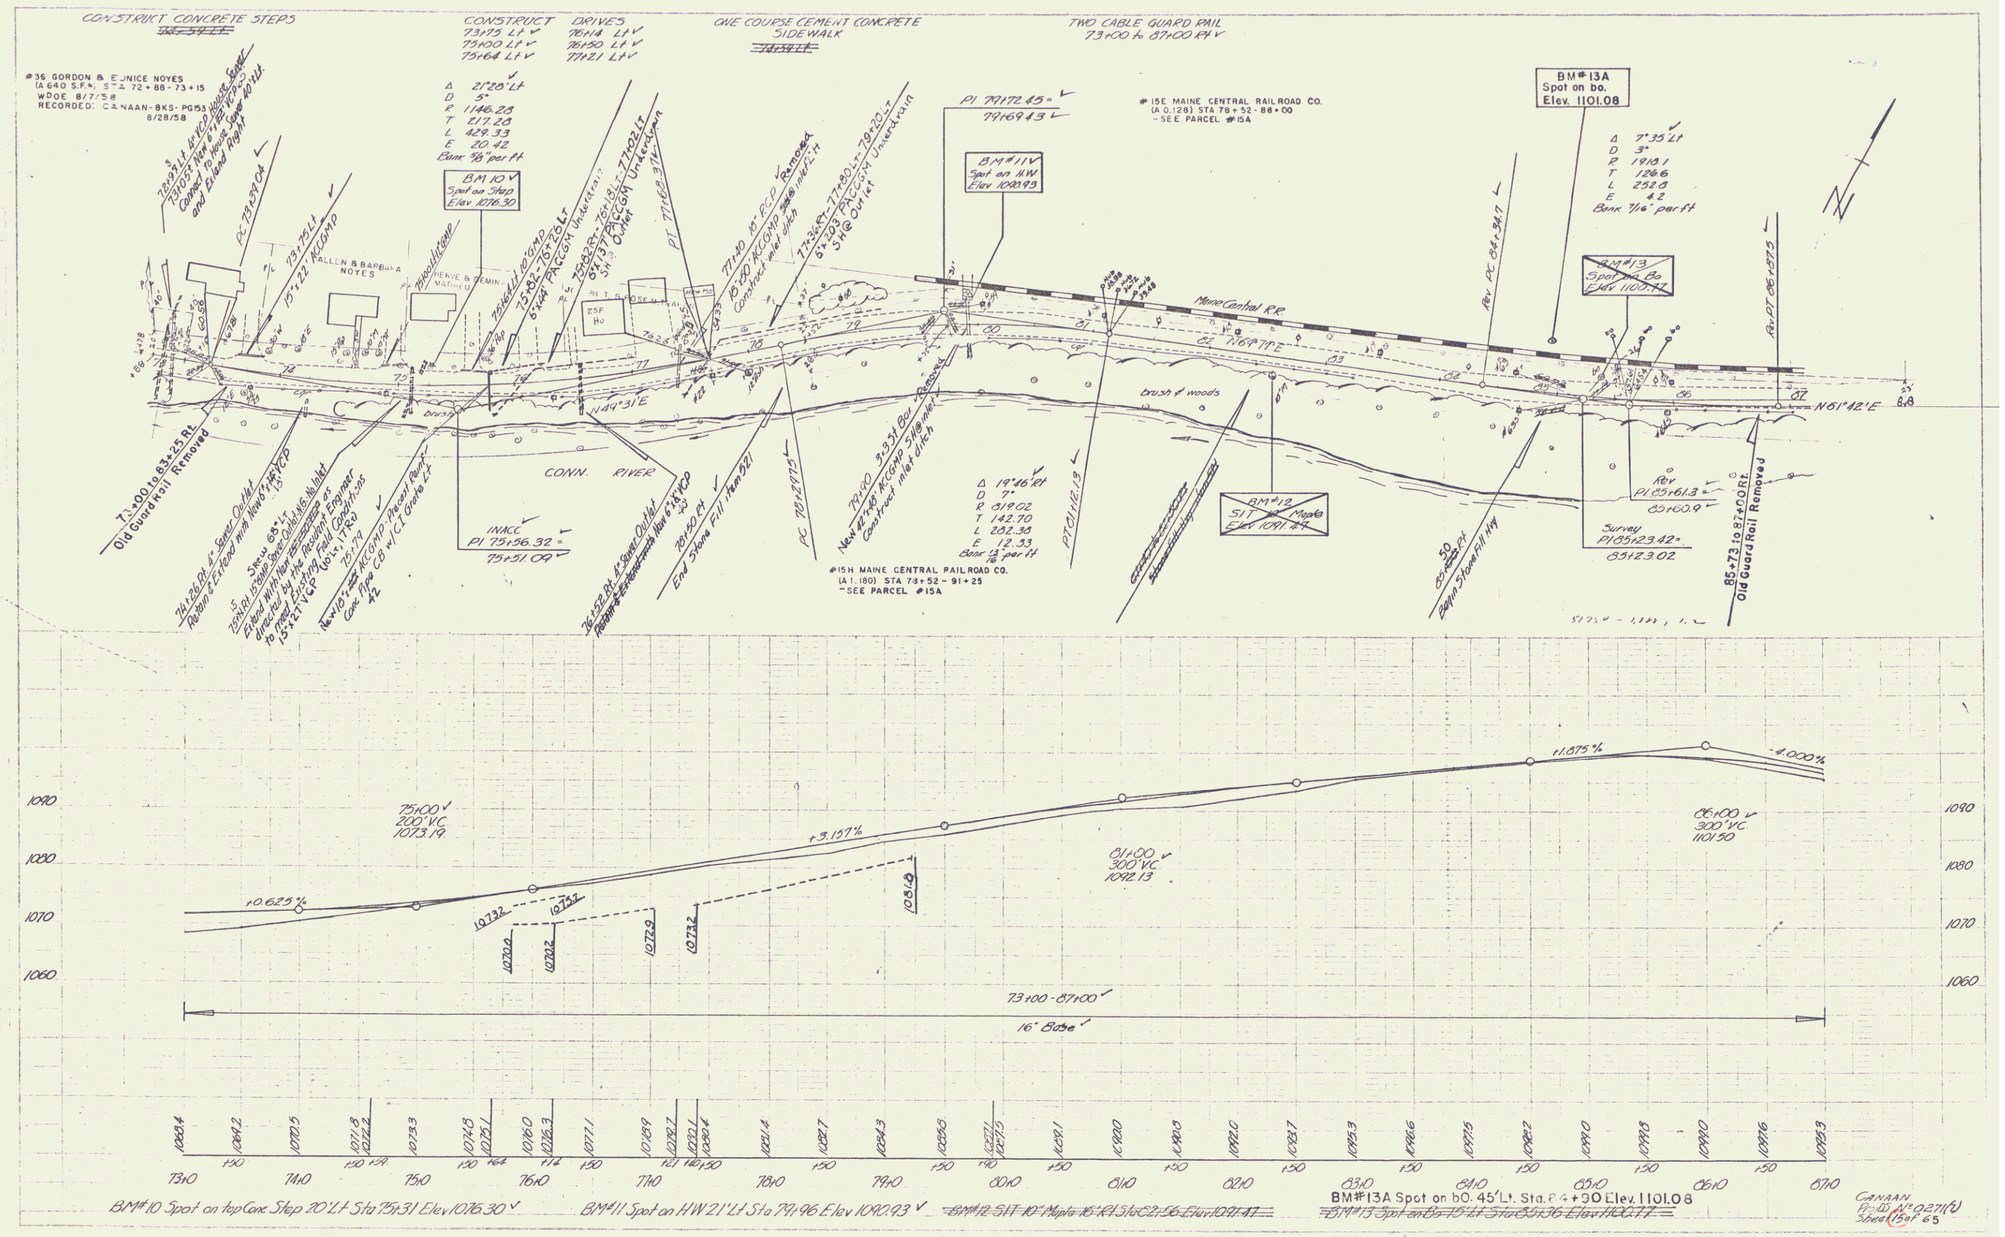
CONSTRUCT CONCRETE STEPS
CONSTRUCT DRIVES
73+75 Lt
73+00 Lt
75+64 Lt
76+14 Lt
76+50 Lt
77+21 Lt
ONE COURSE CEMENT CONCRETE SIDEWALK
TWO CABLE GUARD RAIL 73+00 to 87+00 Rt
#36 GORDON & EUNICE NOYES
(A.640 S.F.N. STA 72+88-73+15
WDOE 8/7/58
RECORDED: CANAAN-BKS-PG553
8/28/58
BM 10
Spot on Step
Elev 1076.30
BM #11
Spot on HW
Elev 1080.93
#15E MAINE CENTRAL RAILROAD CO.
(A.0.128) STA 78+52-88+00
-SEE PARCEL #15A
BM #13A
Spot on bo.
Elev. 1101.08
Maine Central R.R.
brush & woods
CONN. RIVER
N61°42'E
N49°31'E
73+00 to 83+25 Rt.
Old Guard Rail Removed
85+73 to 87+00 Rt.
Old Guard Rail Removed
#15H MAINE CENTRAL RAILROAD CO.
(A.1.180) STA 73+52-91+25
-SEE PARCEL #15A
+0.625%
+3.157%
+1.875%
-4.000%
75+00
200' VC
1073.19
81+00
300' VC
1042.13
86+00
300' VC
1101.50
73+00-87+00
16' Base
BM#10 Spot on top Conc. Step 20' Lt Sta 75+31 Elev 1076.30
BM#11 Spot on HW 21' Lt Sta 79+96 Elev 1080.93
BM#13A Spot on bo. 45' Lt. Sta. 86+90 Elev. 1101.08
CANAAN
15-10 No. 0271(2)
Sheet 15 of 65

7