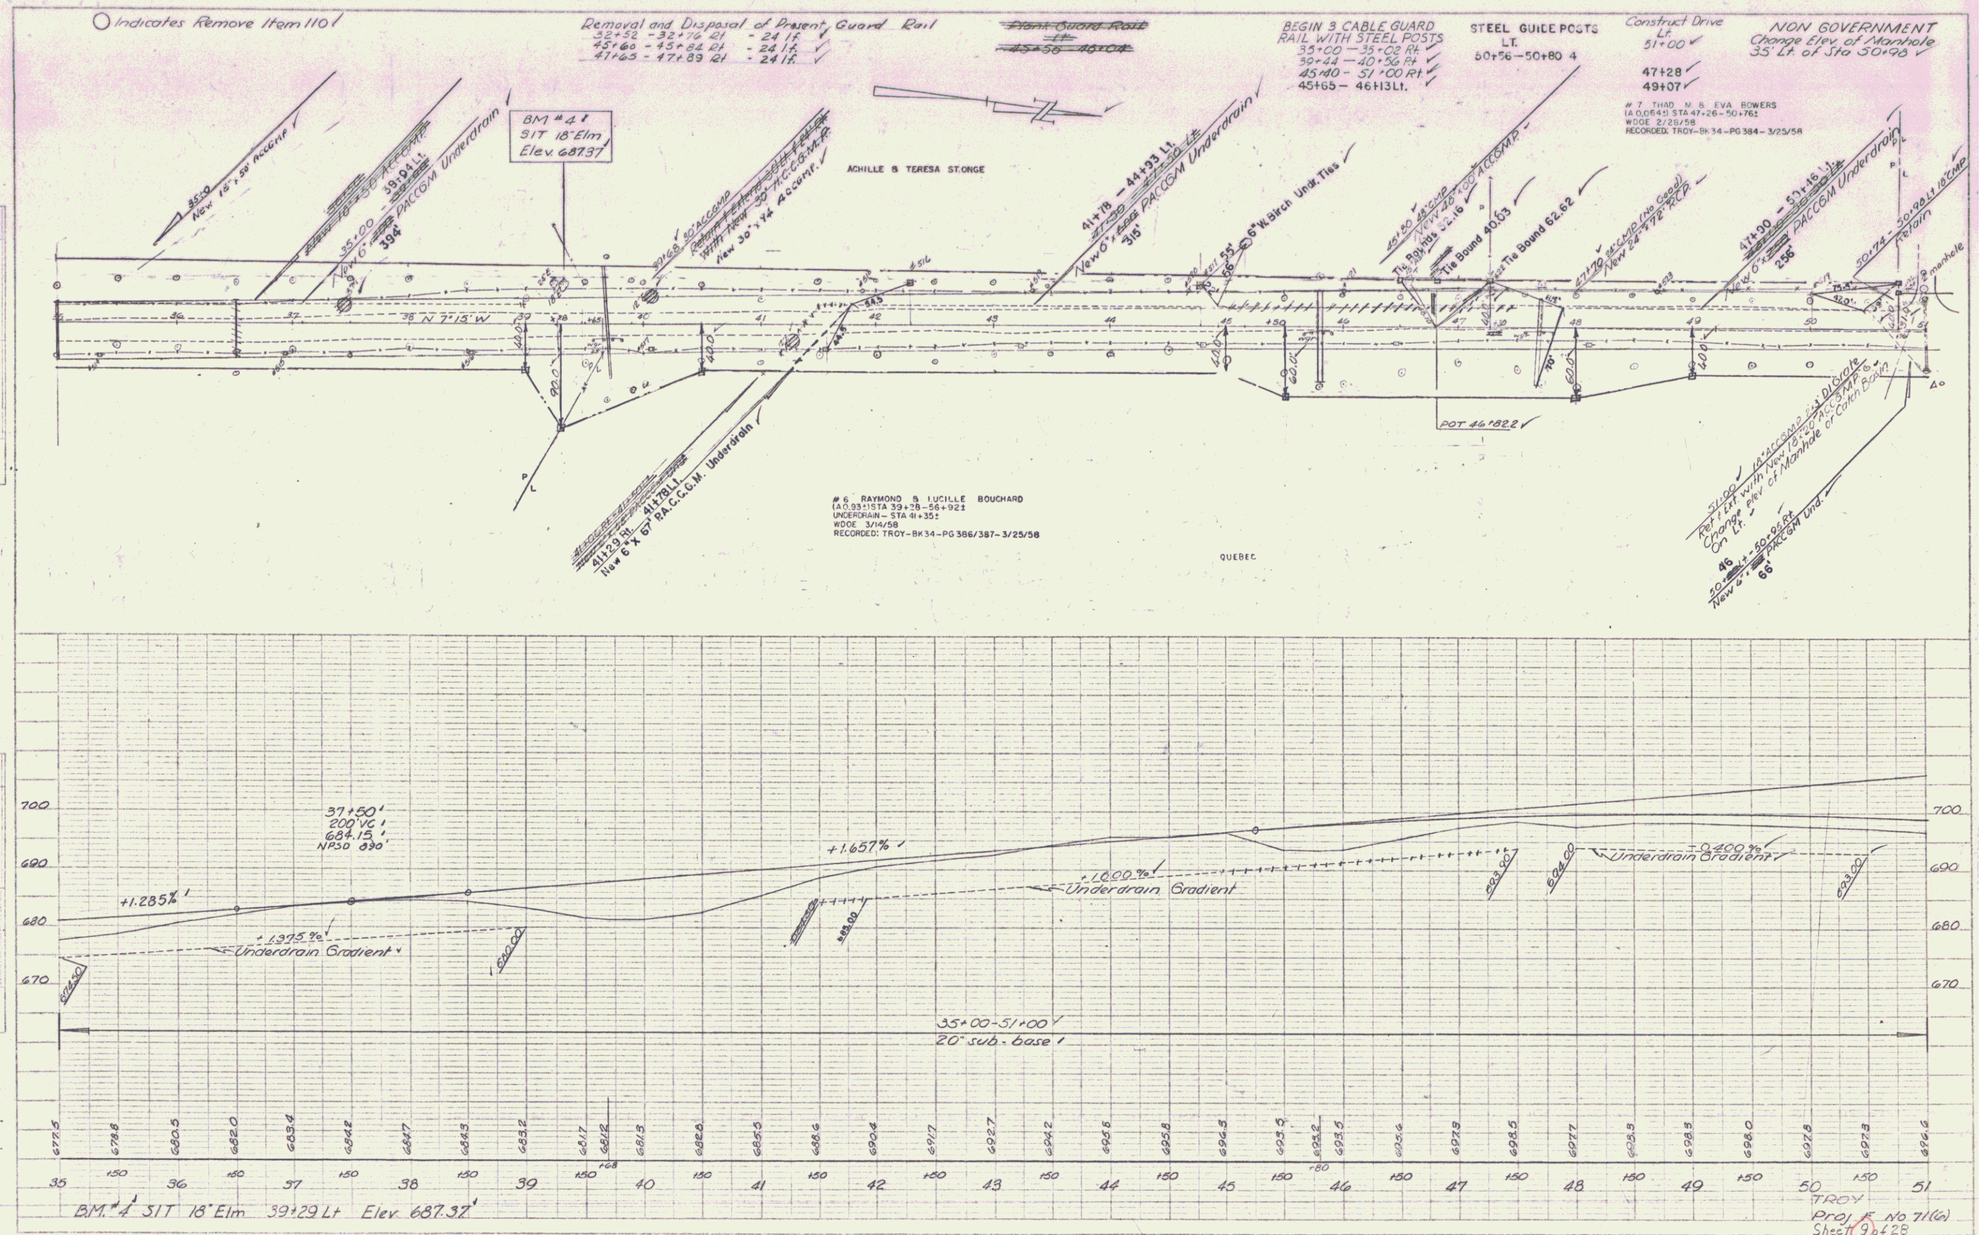
Indicates Remove Item 110
Removal and Disposal of Present Guard Rail
32+52 - 32+76 Rt - 24 l.f.
45+60 - 45+82 Rt - 24 l.f.
47+65 - 47+89 Rt - 24 l.f.
BEGIN 3 CABLE GUARD RAIL WITH STEEL POSTS
35+00 — 35+02 Rt
50+44 — 40+56 Rt
45+40 - 51+00 Rt
45+65 - 46+13 Lt.
STEEL GUIDE POSTS
LT.
50+56 - 50+80 4
Construct Drive
Lt.
51+00
47+28
49+07
NON GOVERNMENT
Change Elev. of Manhole
35' Lt of Sta 50+98
BM # 4
SIT 18" Elm
Elev. 687.37'
ACHILLE & TERESA STONGE
New 18" x 38' RCCPP
35+00 - 39+94 Lt.
New 6" PACCGM Underdrain
394'
New 30" x 74' Accent.
41+78 - 44+93 Lt.
New 6" PACCGM Underdrain
315'
6" W. Birch Undr. Ties
Tie Bound 40.03
Tie Bound 62.62
New 24" x 72' RCP
47+90 - 51+46 Lt.
New 6" PACCGM Underdrain
256
50+74 - 50+94 Lt 18" Conc
Retain
manhole
N 7°13' W
POT 46+82.2
41+29 Rt - 41+78 Lt.
New 6" x 67' P.A.C.C.G.M. Underdrain
6 RAYMOND & LUCILLE BOUCHARD
(A0.934) STA 39+28-56+92±
UNDERDRAIN - STA 41+35±
WDOE 3/14/58
RECORDED: TROY-Bk 34-PG 386/387-3/25/58
QUEBEC
51+00 Remove and Dispose of
Ref. Elev with New 18" x 20' RCCPP
Change elev of Manhole on Lt.
46
50+94 Rt - 50+98 Rt
New 4" PACCGM Und.
66'
7 THAD. M. & EVA BOWERS
(A0.0645) STA 47+26-50+76±
WDOE 2/28/58
RECORDED: TROY-Bk 34-PG 384-3/25/58
+1.285%
37+50'
200' VC
684.15'
NPSO 690'
+1.375%
Underdrain Gradient
+1.657%
+1.000%
Underdrain Gradient
-0.400%
Underdrain Gradient
35+00-51+00
20" sub-base
BM. # 4 SIT 18" Elm 39+29 Lt Elev. 687.37'
TROY
Proj. F No 71(6)
Sheet 9 of 28

4