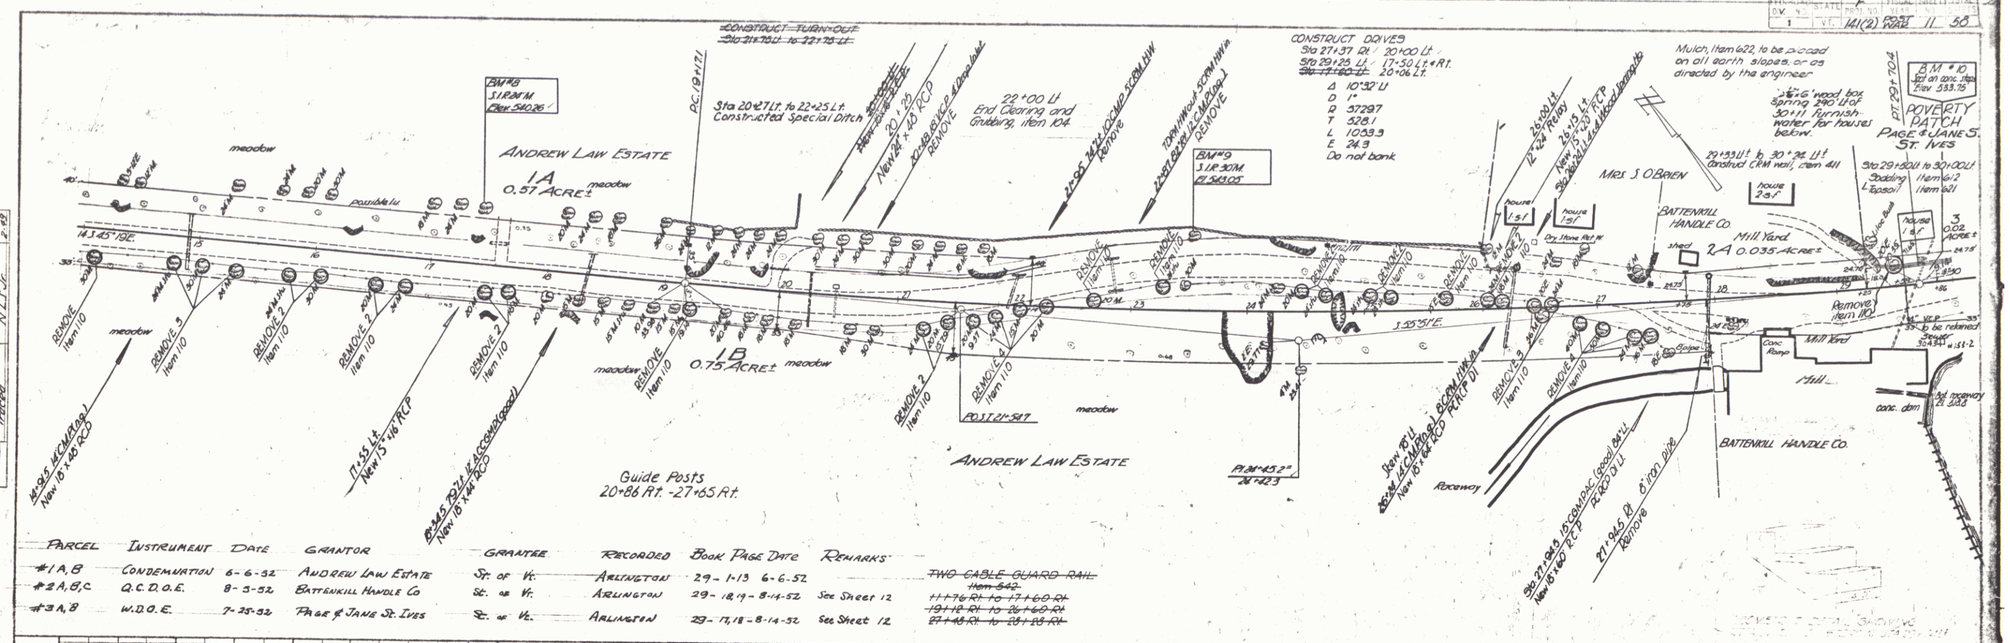

PARCEL	INSTRUMENT	DATE	GRANTOR	GRANTEE	RECORDED	BOOK PAGE DATE	REMARKS
#1 A, B	CONDEMNATION	6-6-52	ANDREW LAW ESTATE	ST. OF VT.	ARLINGTON	29-1-13 6-6-52	
#2 A, B, C	Q.C.D.O.E.	8-5-52	BATTENKILL HANDLE CO	ST. OF VT.	ARLINGTON	29-12, 19-8-14-52	See Sheet 12
#3 A, B	W.D.O.E.	7-25-52	PAGE & JANE ST. IVES	ST. OF VT.	ARLINGTON	29-17, 18-8-14-52	See Sheet 12

~~TWO CABLE GUARD RAIL Item 542~~
~~11+76 Rt. to 17+60 Rt.~~
~~19+18 Rt. to 26+60 Rt.~~
~~27+45 Rt. to 28+18 Rt.~~

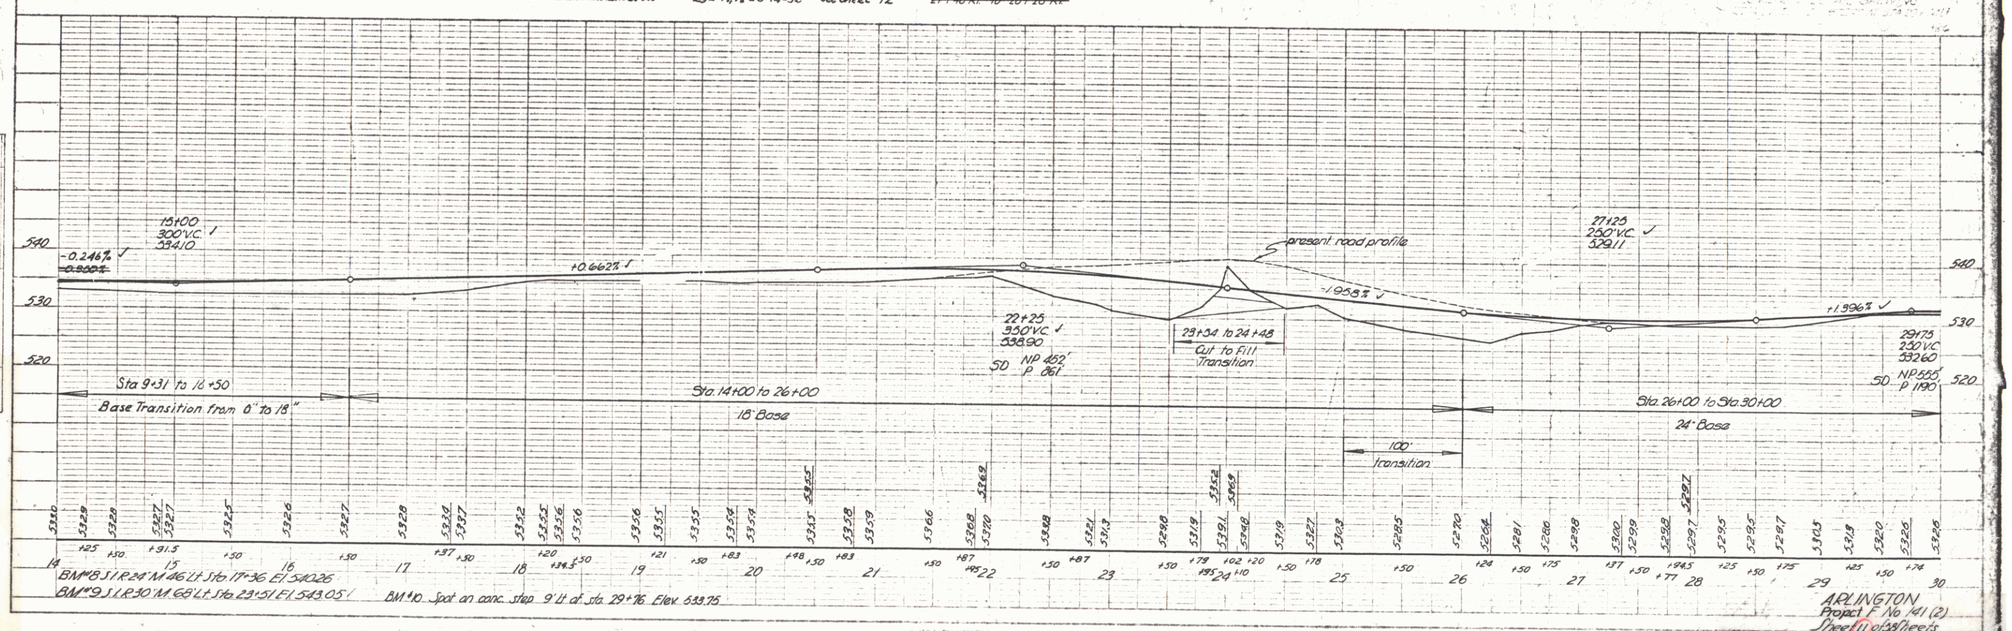

ARLINGTON
Project F No 141 (2)
Sheet 11 of 58 Sheets