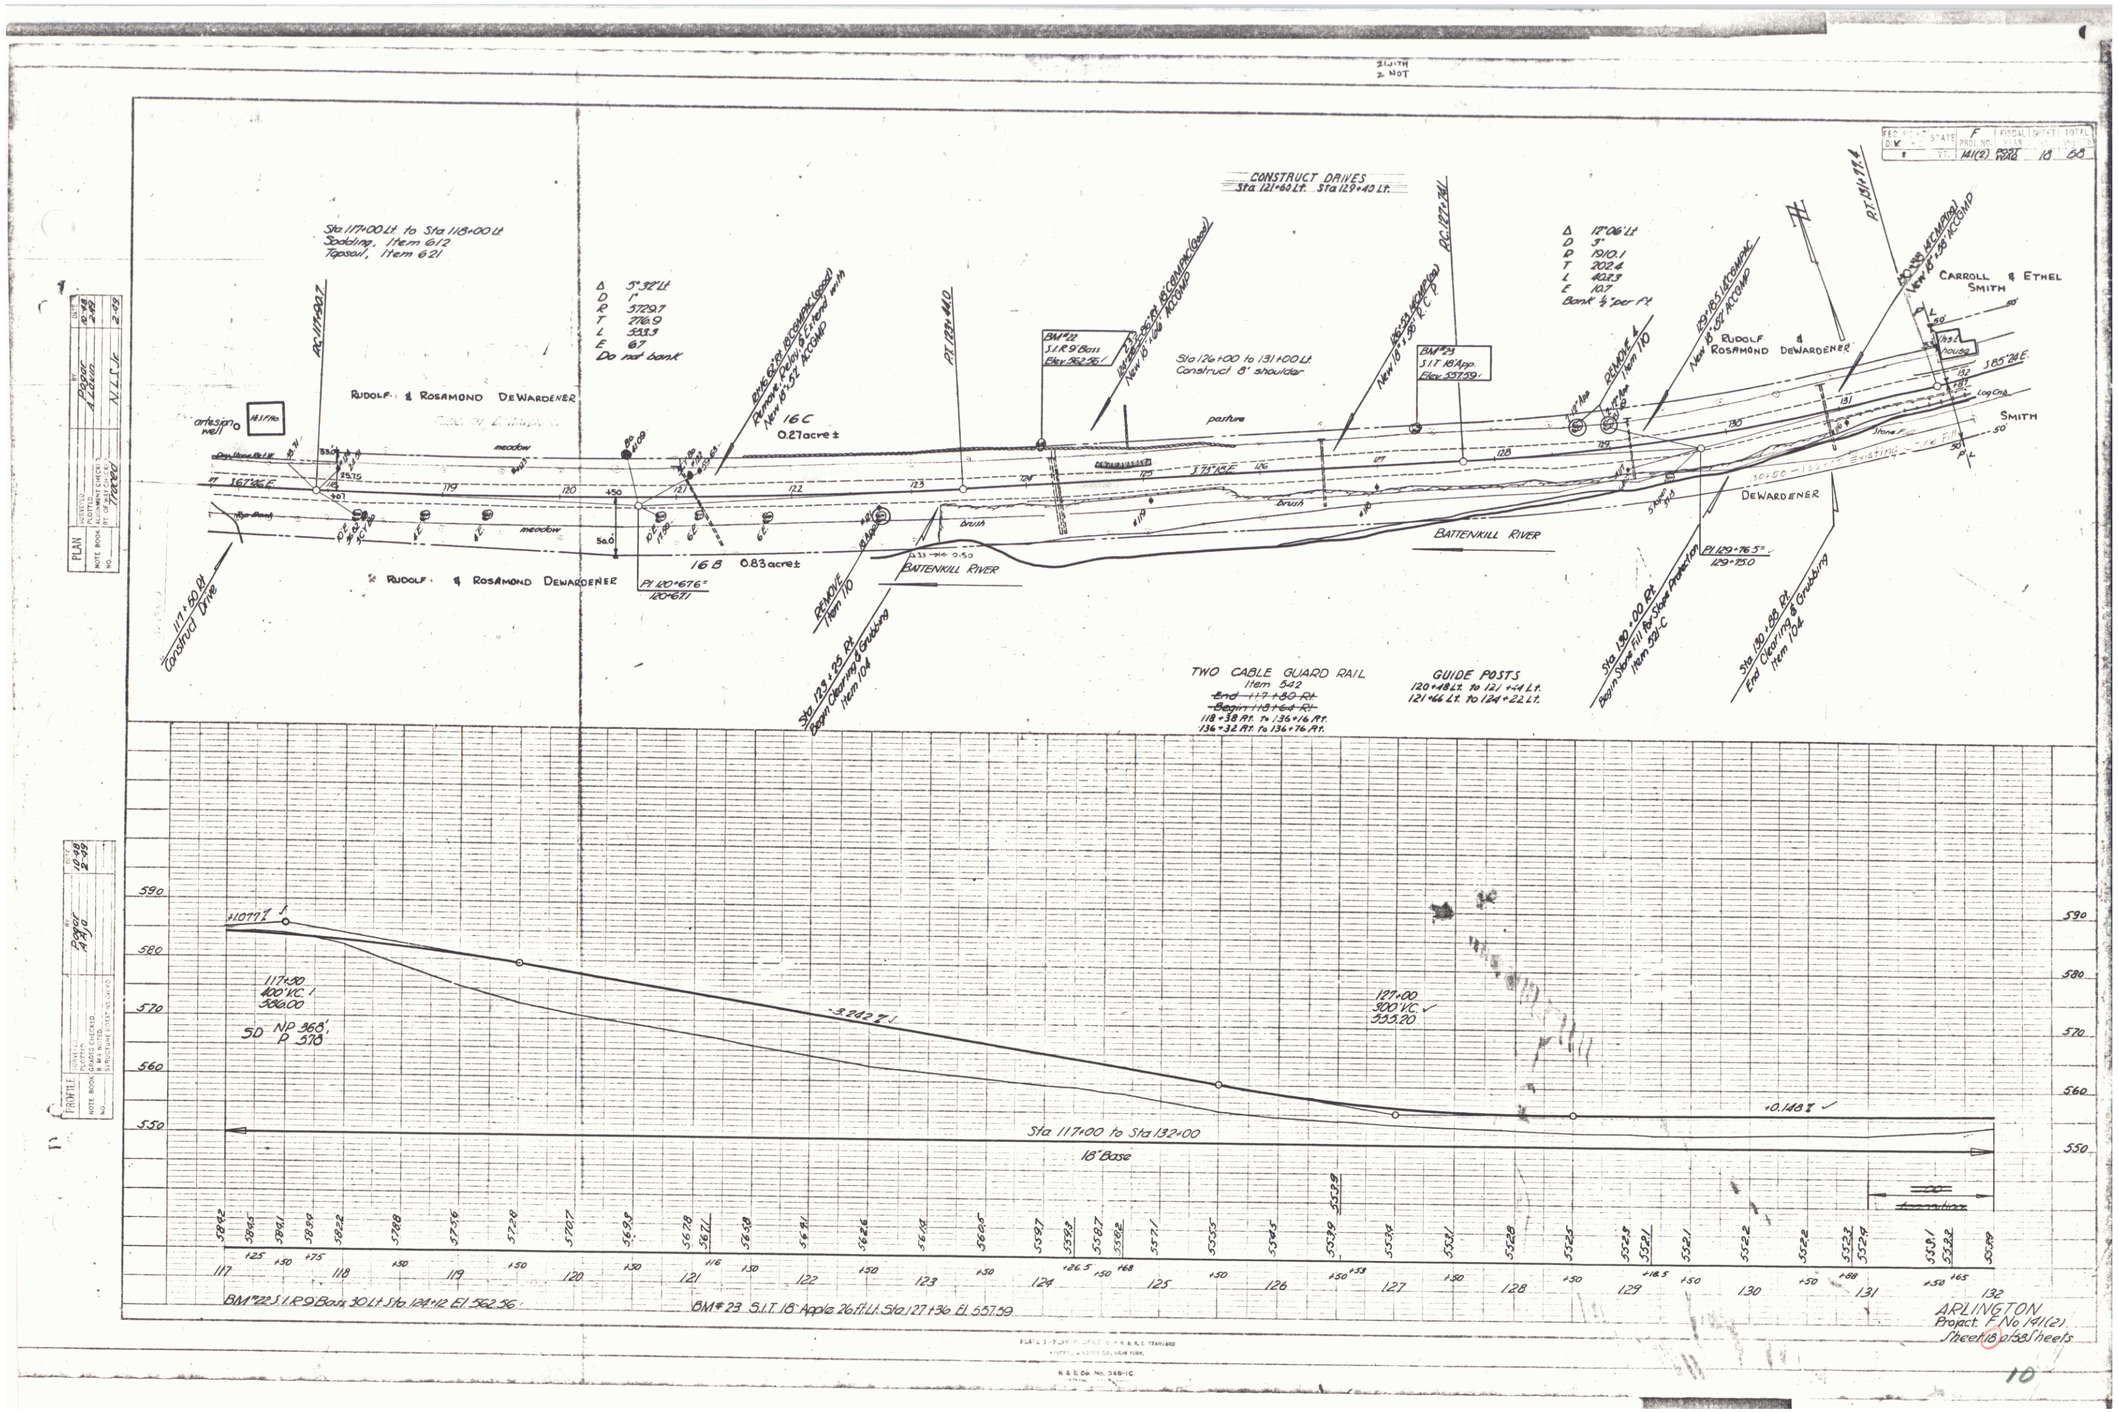
Sta 117+00 Lt. to Sta 118+00 Lt.
Sodding, Item 612
Topsoil, Item 621
Δ 5°32' Lt.
D 1°
R 5729.7
T 276.9
L 553.3
E 6.7
Do not bank
Remove & Replace Guiderail with New 6'-0" ACCOMP.
16C
0.27 acre ±
RUDOLF & ROSAMOND DEWARDENER
artesian well
meadow
brush
16B
0.83 acre ±
RUDOLF & ROSAMOND DEWARDENER
PI 120+67.6
120+67.1
BATTENKILL RIVER
Sta 123+55 Rt.
Begin Clearing & Grubbing
Item 104
REMOVE
Item 110
Sta 126+00 to 131+00 Lt.
Construct 8' shoulder
pasture
brush
BATTENKILL RIVER
CONSTRUCT DRIVES
Sta 121+60 Lt. Sta 129+40 Lt.
Remove Fence & Set Back with New 8'-0" ACCOMP.
BM #22
S.I.R. 9" Butt
Elev. 562.36
BM #23
S.I.T. 18" App.
Elev. 557.59
Δ 18°06' Lt.
D 3°
R 1910.1
T 202.4
L 403.3
E 10.7
Bank ⅔ per Ft.
Remove Fence & Set Back with New 8'-0" ACCOMP.
RUDOLF & ROSAMOND DEWARDENER
DEWARDENER
Stone Fill
Log Cribs
Existing Low Fill
CARROLL & ETHEL SMITH
House
SMITH
S85°24'E.
TWO CABLE GUARD RAIL
Item 542
~~End 117+80 Rt.~~
~~Begin 118+64 Rt.~~
118+38 Rt. to 135+16 Rt.
136+32 Rt. to 136+76 Rt.
GUIDE POSTS
120+48 Lt. to 121+4 Lt.
121+66 Lt. to 124+22 Lt.
Sta 130+00 Rt.
Begin Stone Fill Revetment
Item 509.C
Sta 130+65 Rt.
End Clearing & Grubbing
Item 104
PI 129+76.5
129+75.0
590
580
570
560
550
117+50
800' VC
506.00
SD NP 368
P 570
-3.242 %
127+00
900' VC
553.20
+0.143 %
Sta 117+00 to Sta 132+00
18" Base
BM #22 S.I.R. 9 Butt 30 Lt. Sta 124+12 El. 562.36
BM #23 S.I.T. 18" Apple 26 Ft. Lt. Sta 127+36 El. 557.59
ARLINGTON
Project F No 141(2)
Sheet 18 of 58 Sheets
10