2 WITH
2 WOT

FED. ROAD DIV.	STATE	PROJ. NO.	FISCAL YEAR	SHEET NO.	TOTAL SHEETS
1	VT.	F 141(2)	1956	19	38

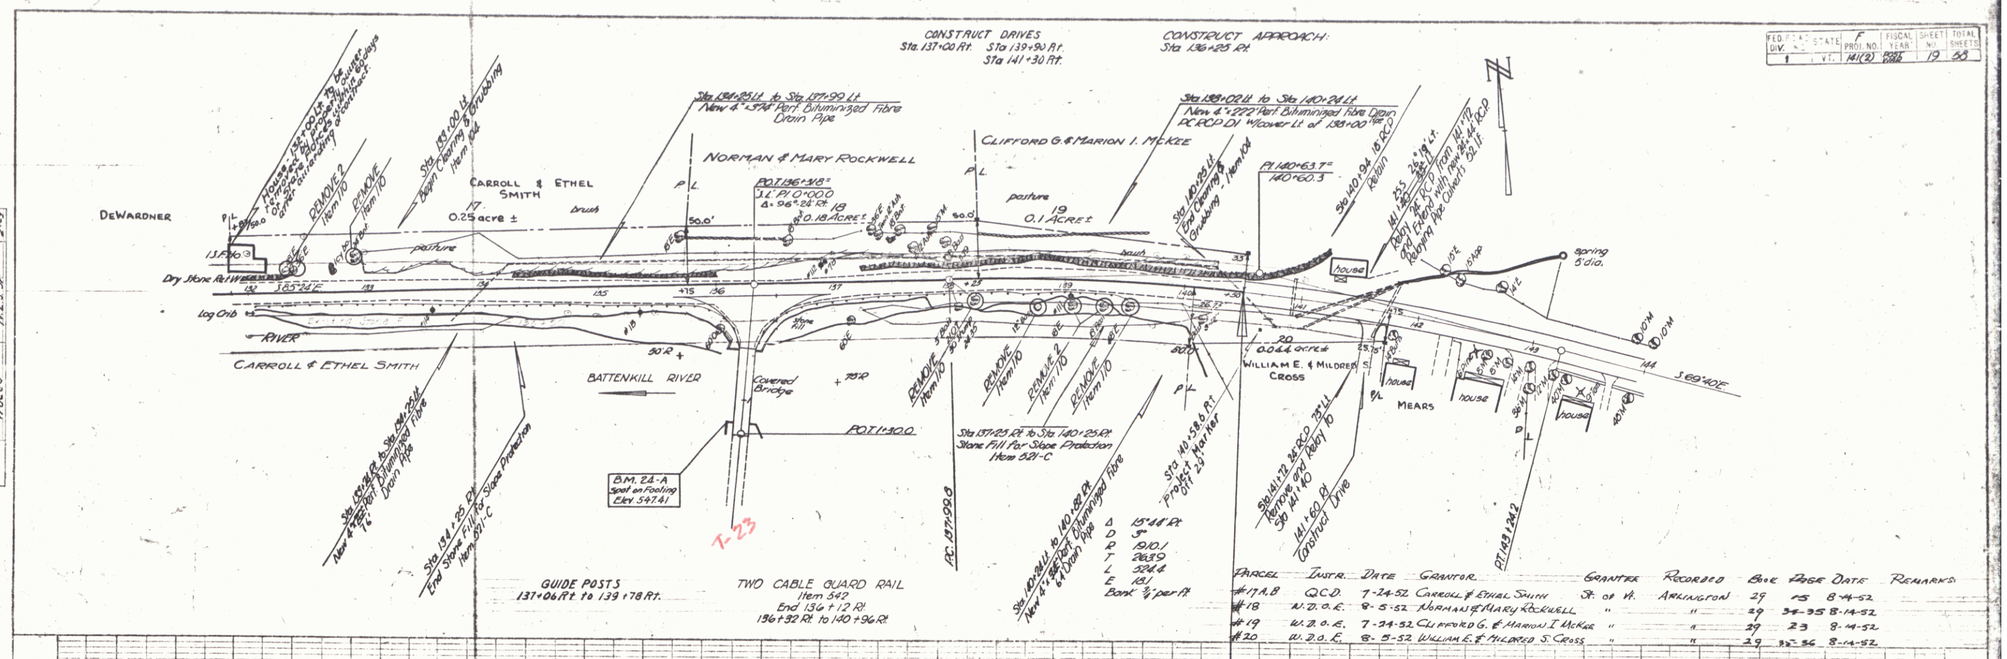

Parcel	Instr.	Date	Grantor	Grantee	Recorded	Book	Page	Date	Remarks
#17 A,B	Q.C.D.	7-24-52	Carroll & Ethel Smith	St. of Vt.	Arlington	29	15	8-14-52	
#18	W.D.O.E.	8-5-52	Norman & Mary Rockwell	"	"	29	34-35	8-14-52	
#19	W.D.O.E.	7-24-52	Clifford G. & Marion I. McKee	"	"	29	23	8-14-52	
#20	W.D.O.E.	8-5-52	William E. & Mildred S. Cross	"	"	29	32-36	8-14-52	

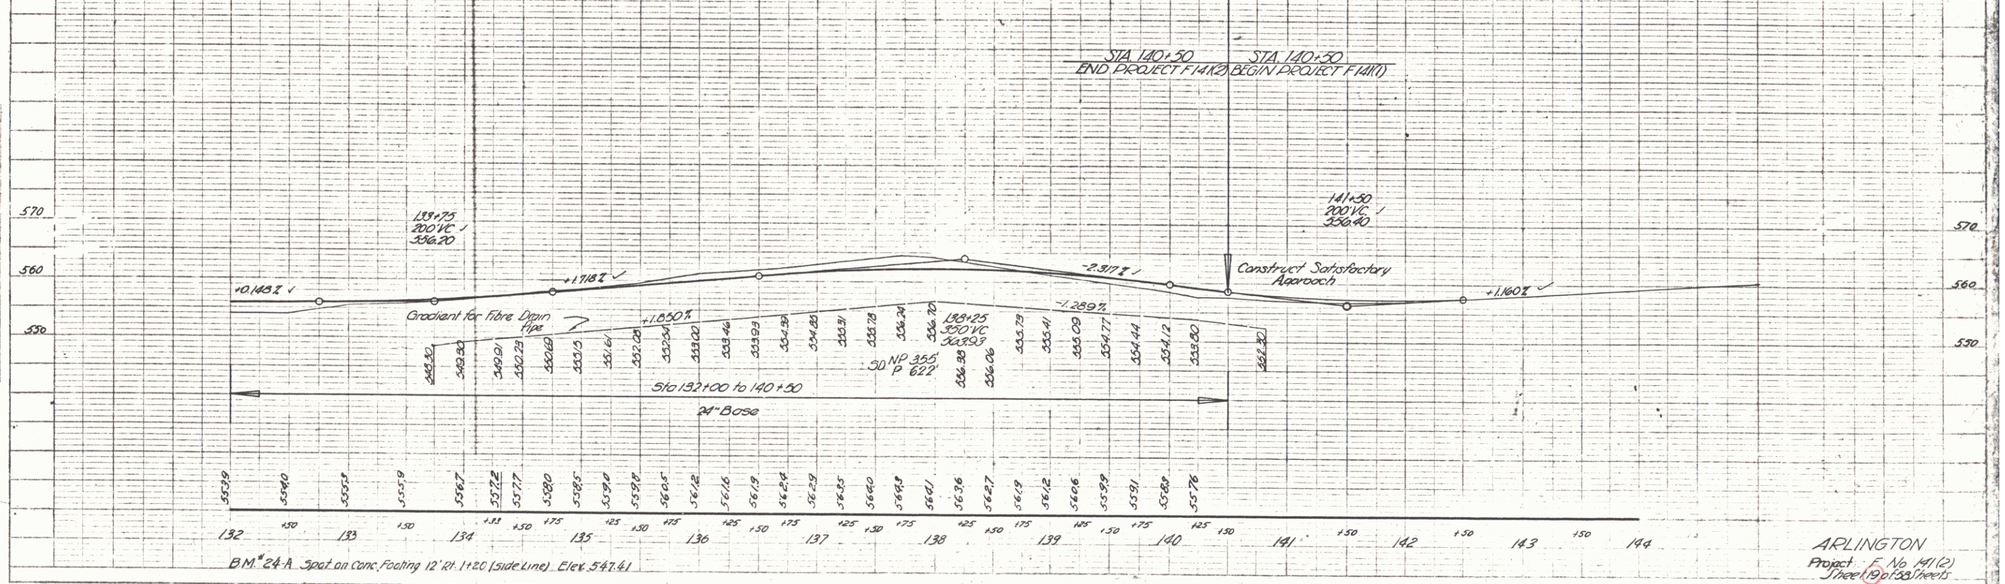

ARLINGTON
Project F No. 141(2)
Sheet 19 of 38 Sheets