F.A.P. ROAD PROJ. NO.	STATE	F PROJ. NO.	FISCAL YEAR	SHEET NO.	TOTAL SHEETS
	V.	141(1)	1947	11	70

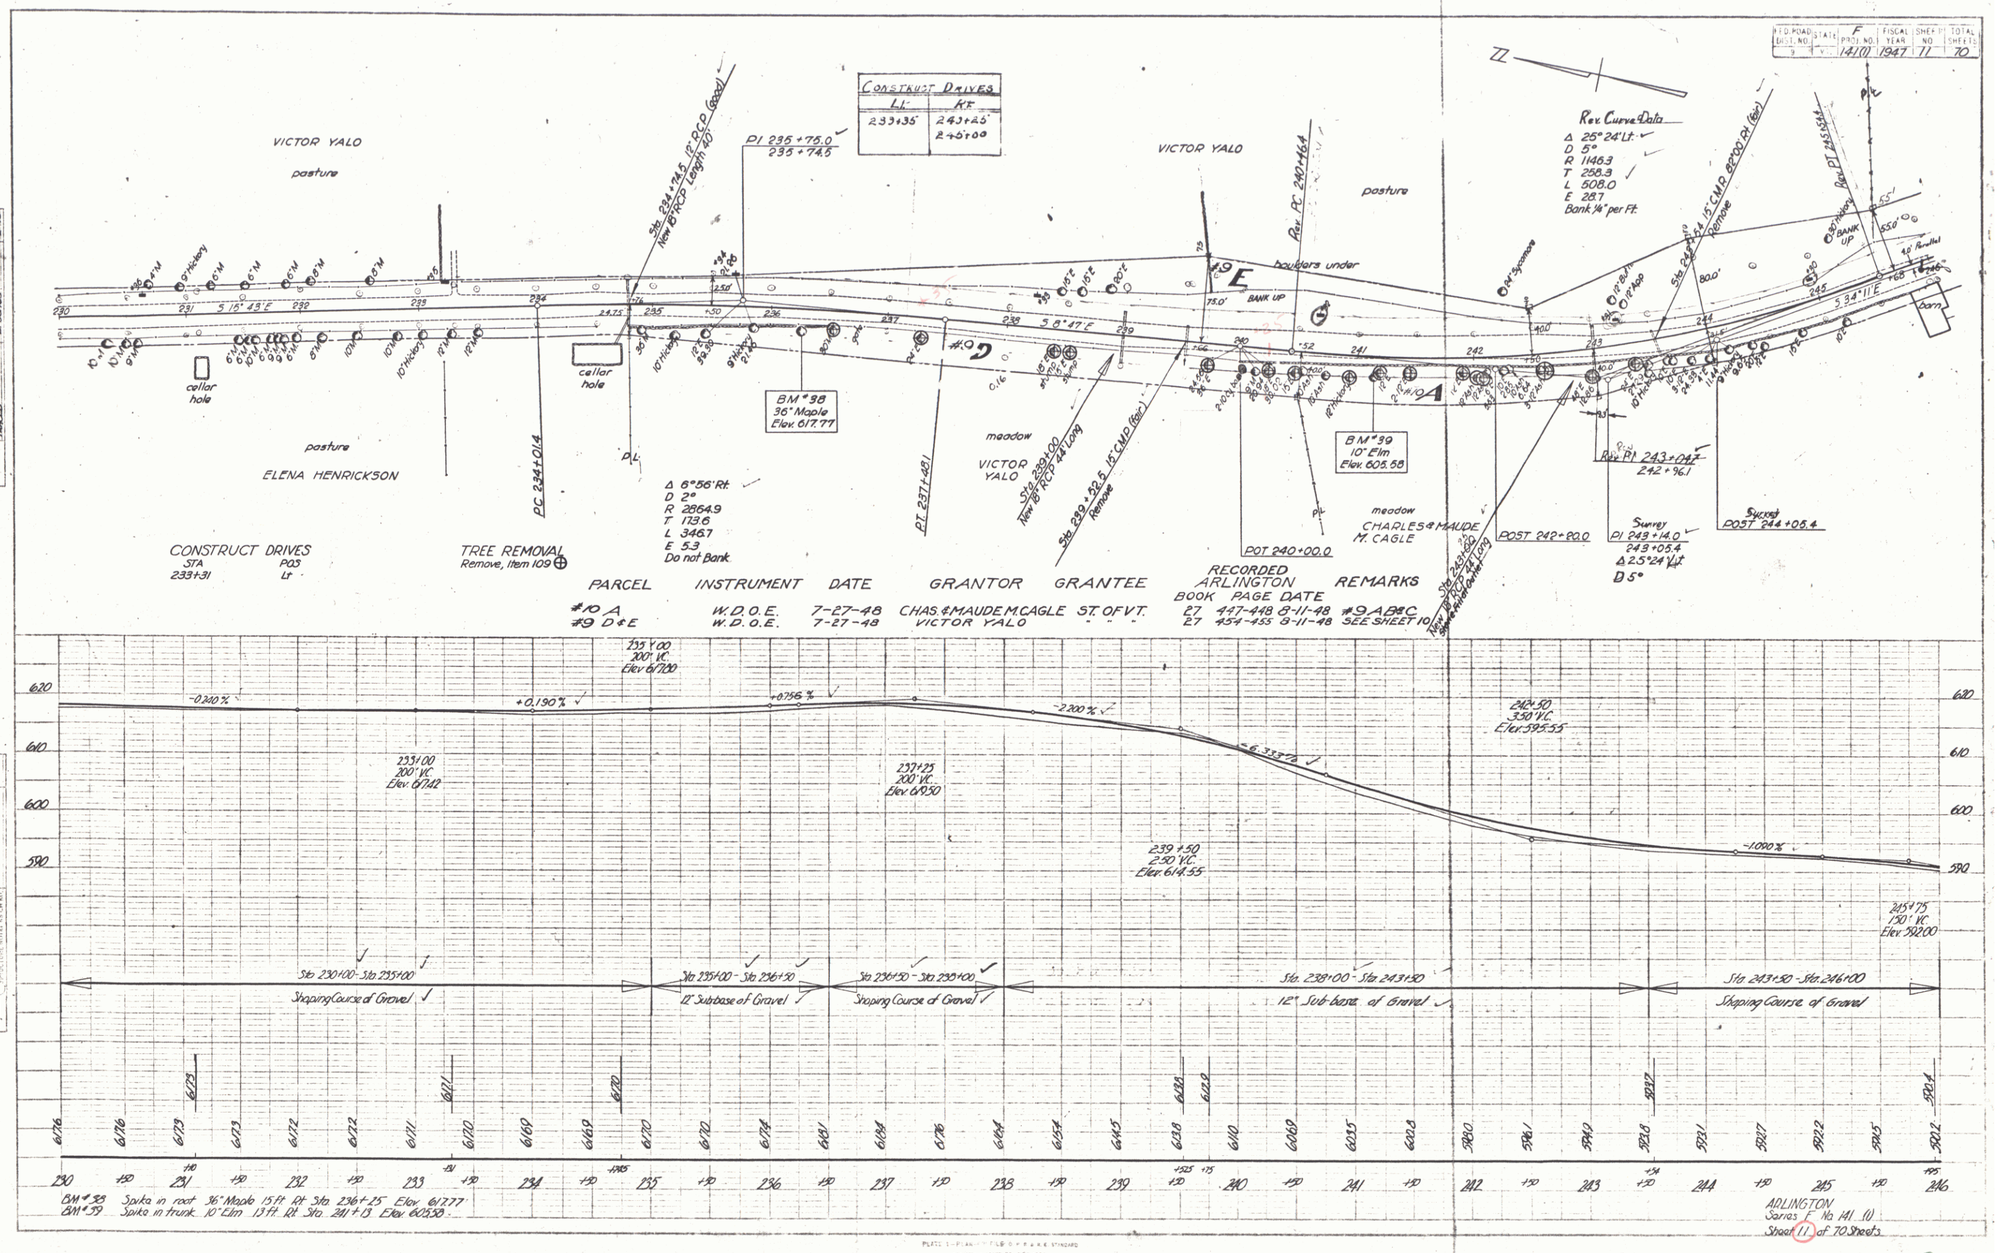

9